


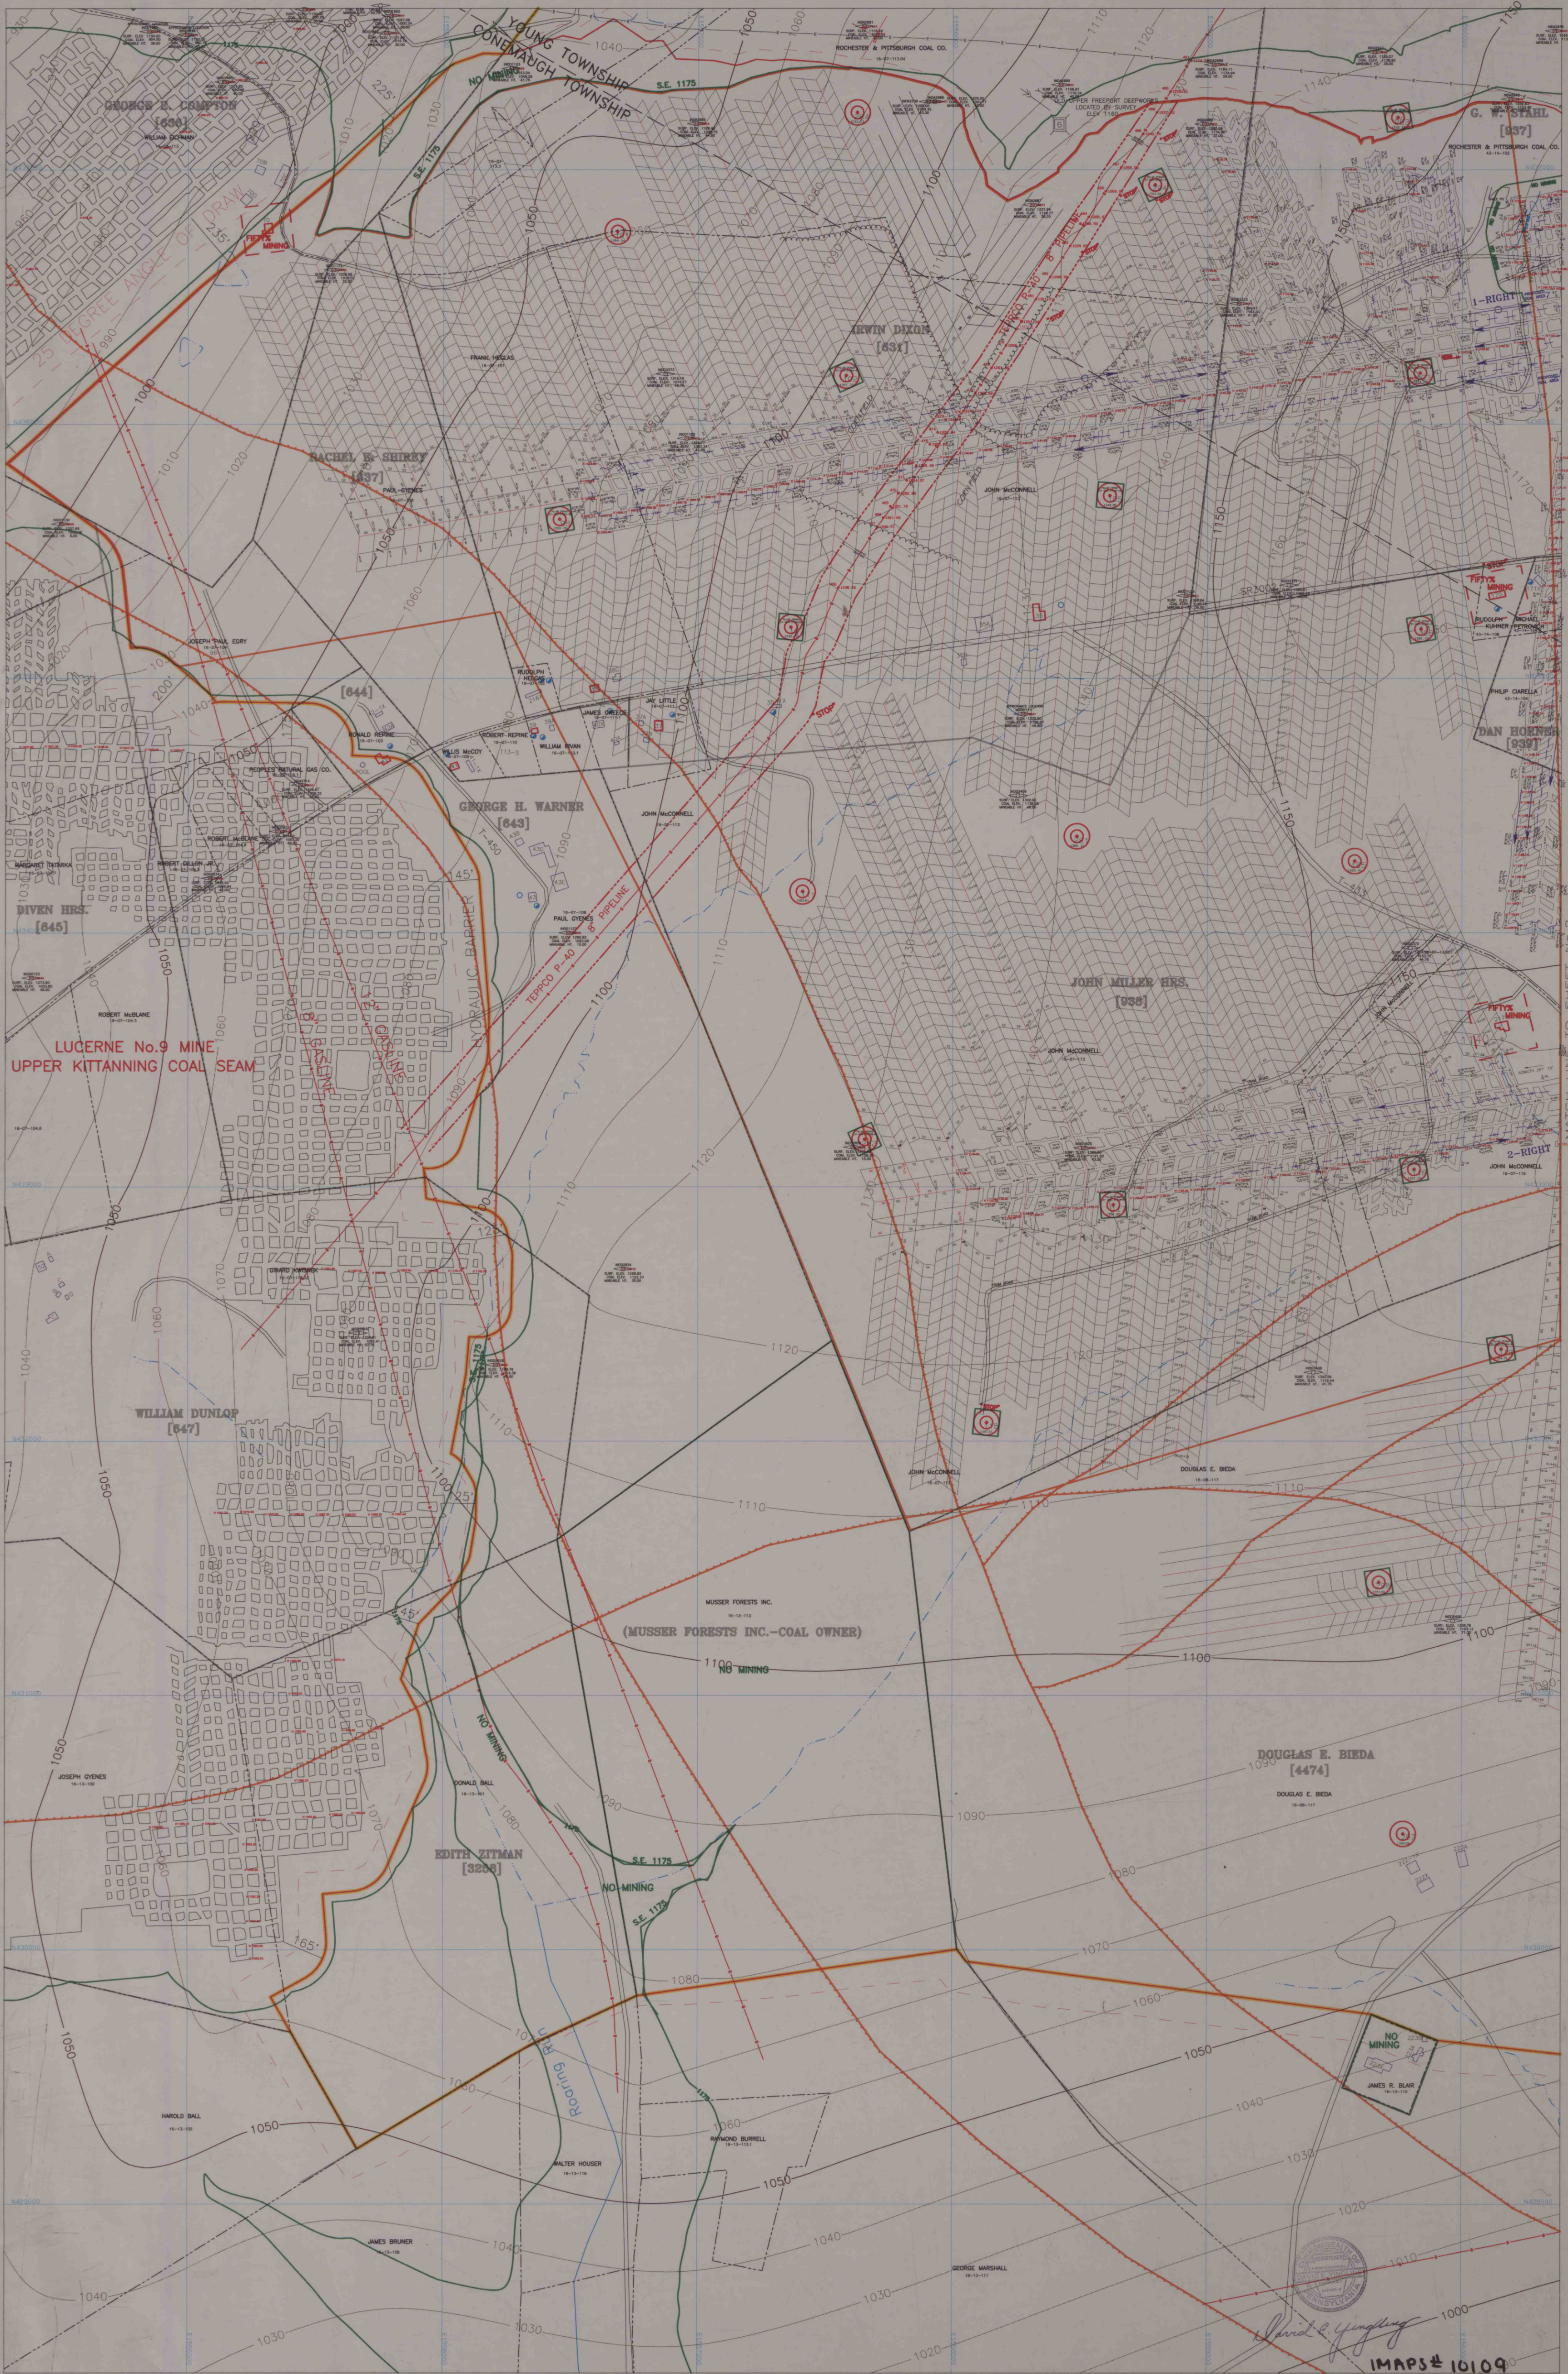

POSTED 1-22-96 CONTEMPLATED MINING FROM 9-1-95 TO 3-1-96