



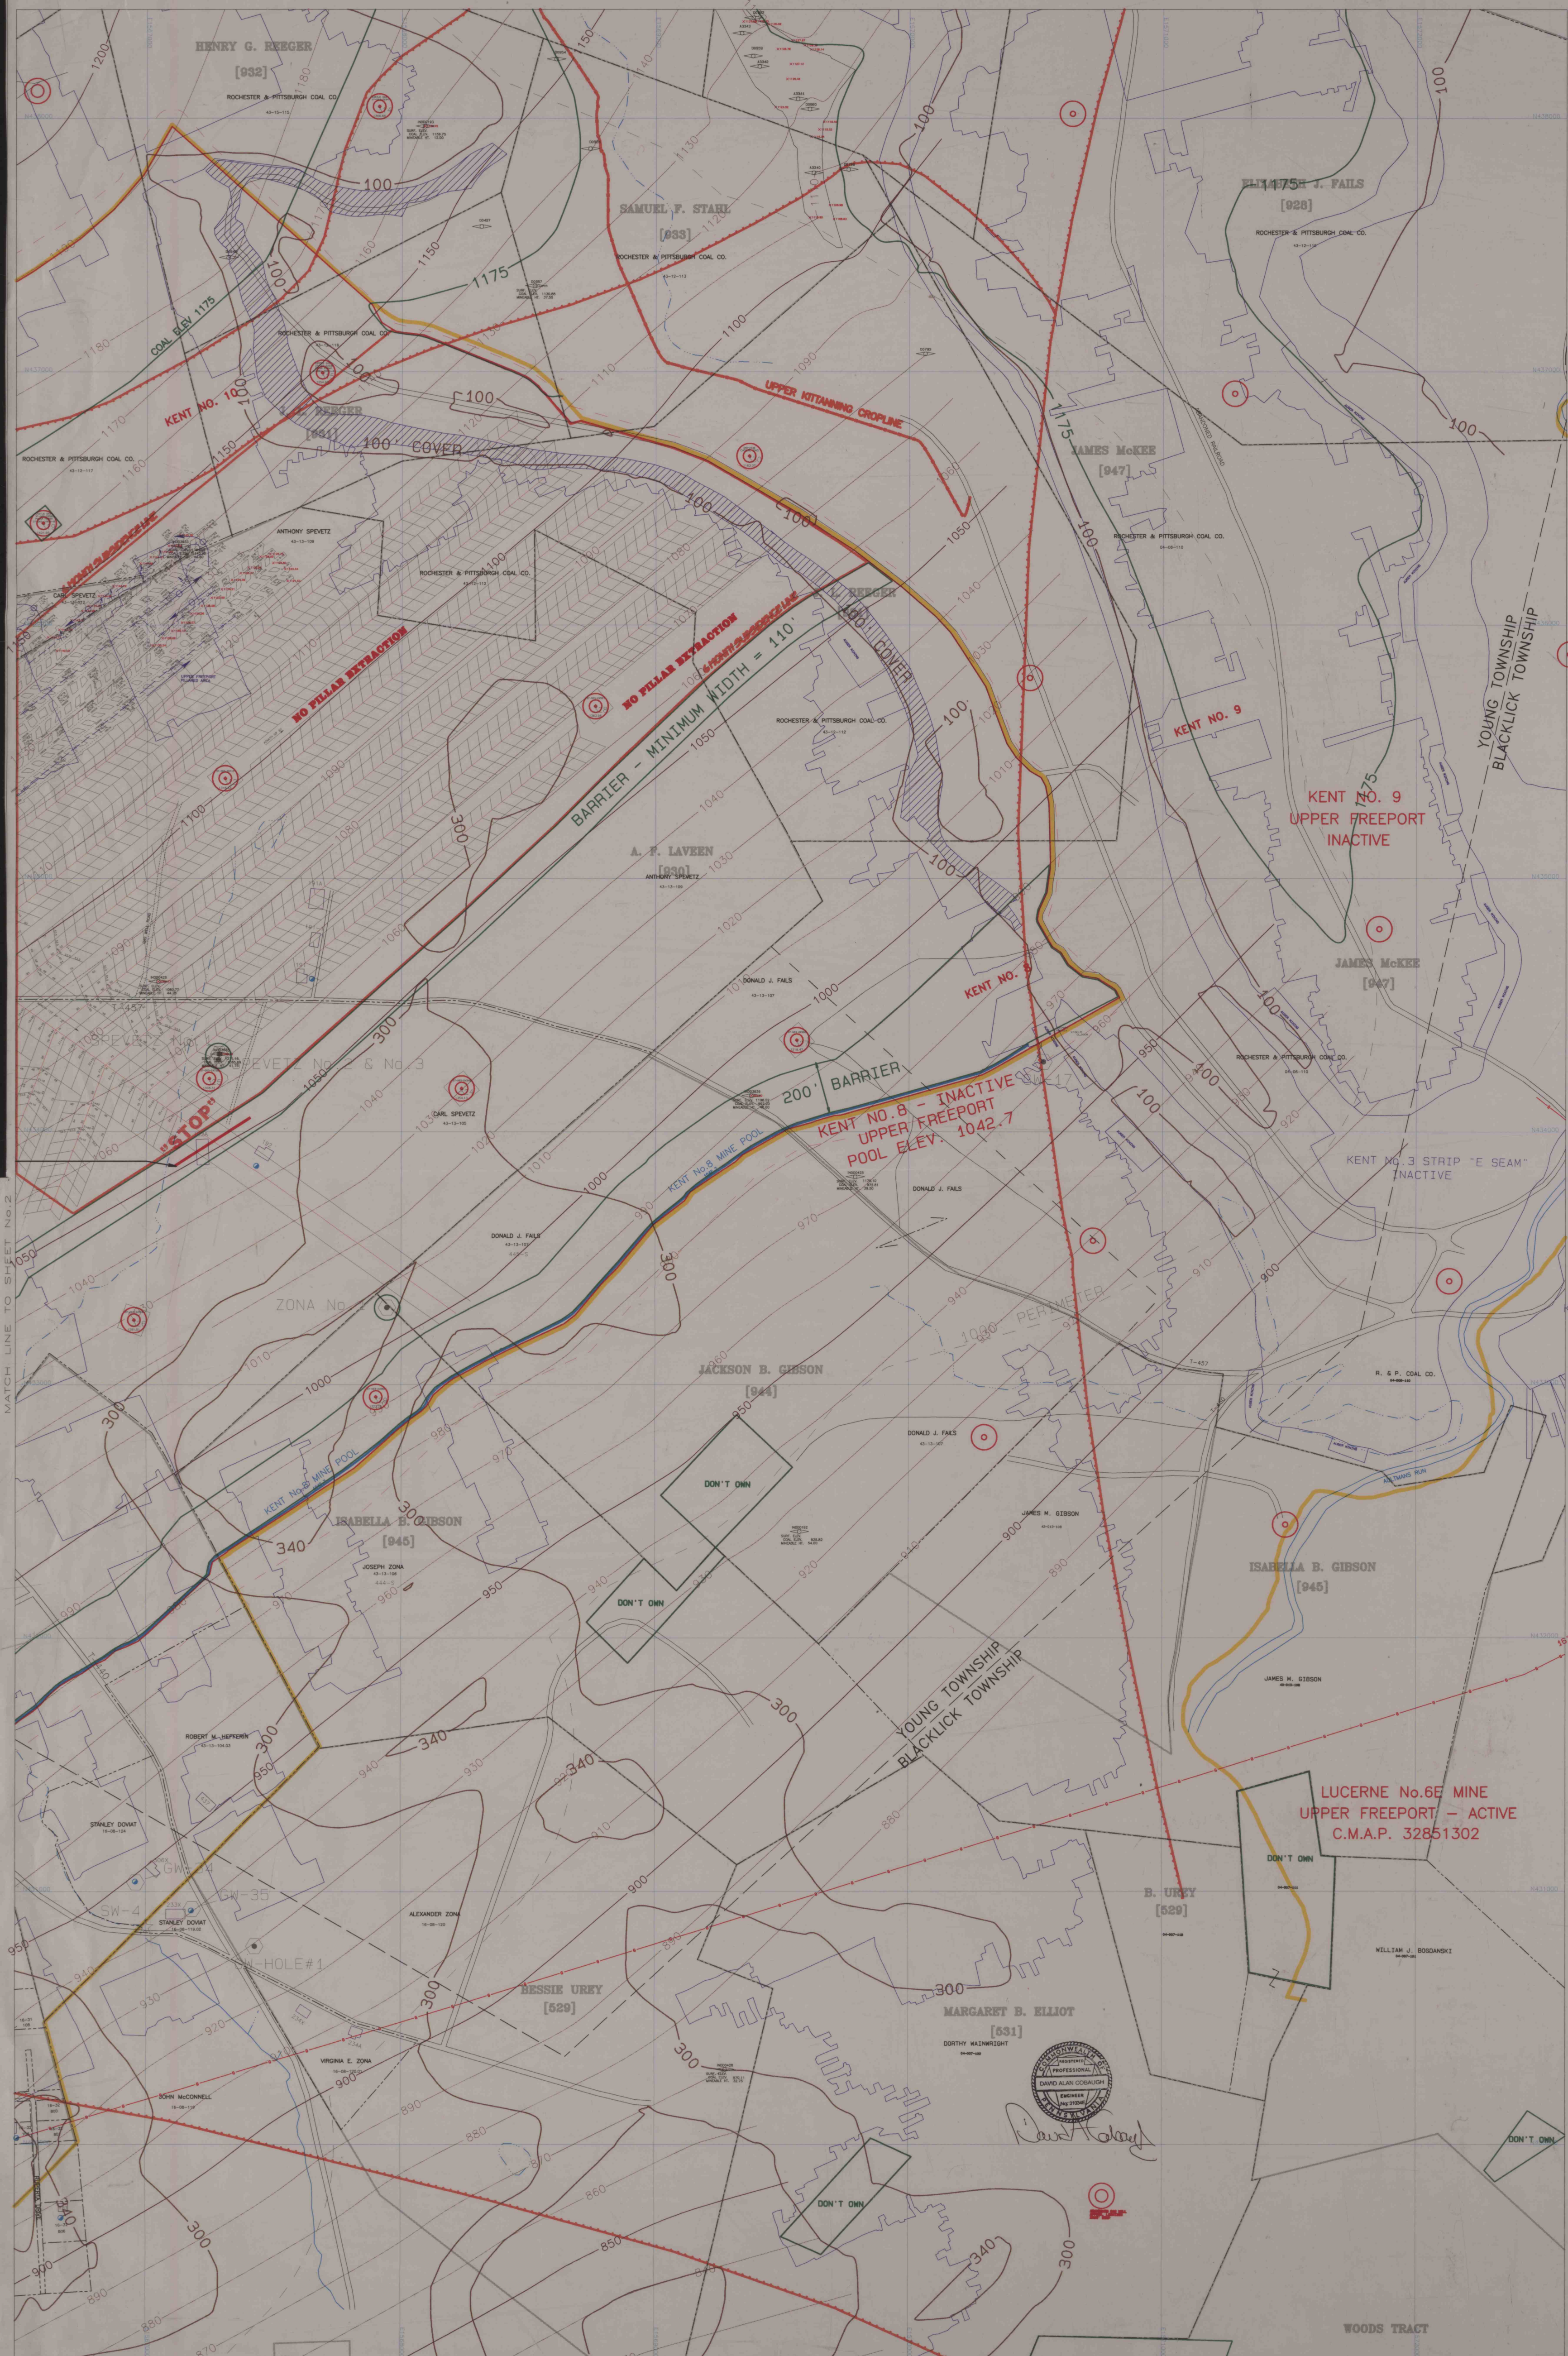


CONTEMPLATED MINING FROM 3-1-98 TO 9-1-98

POSTED 3-1-1998

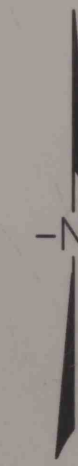

MSHA I.D. No. 36-08435
DER PERMIT No. 32921302

UPPER KITTANNING COAL SEAM

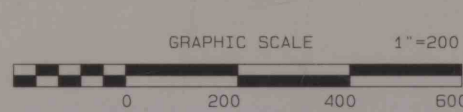

MARSHALL RUN MINE HELVETIA COAL CO.
YOUNG & CONEMAUGH TOWNSHIPS, INDIANA COUNTY