



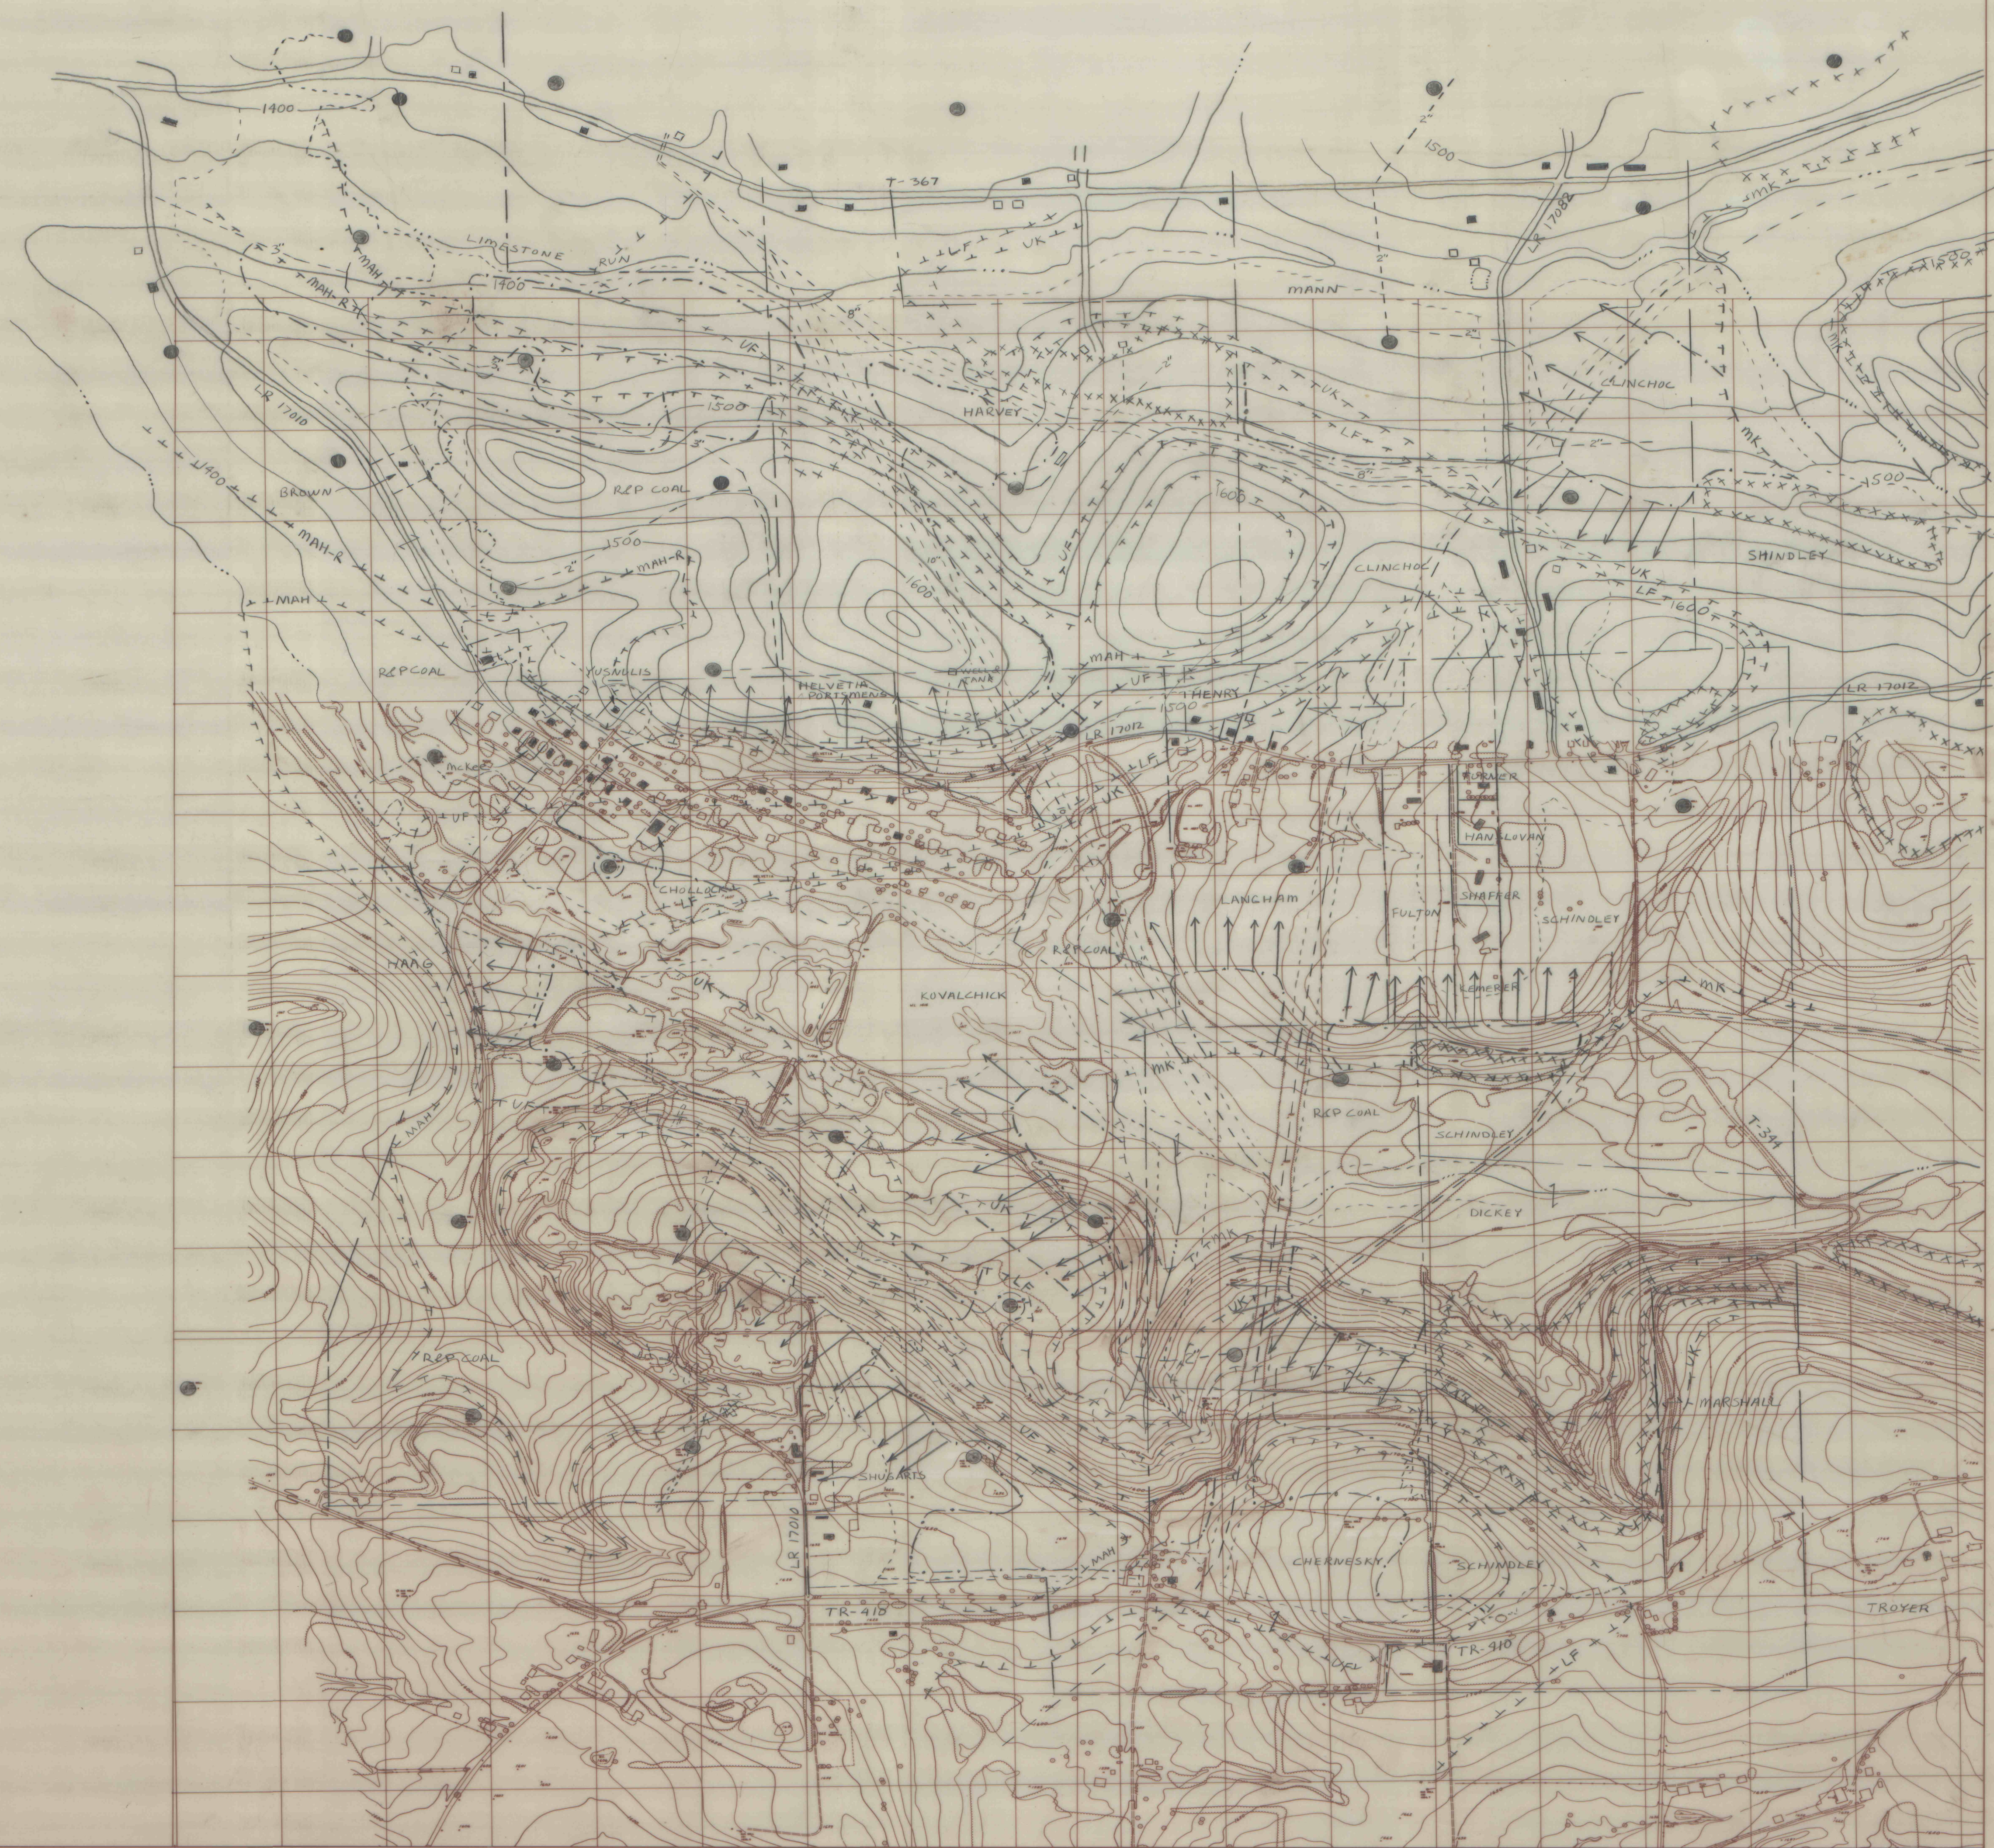

E 1,714,000 E 1,716,000 E 1,718,000 E 1,720,000 E 1,722,000 76° 45' 00.00"

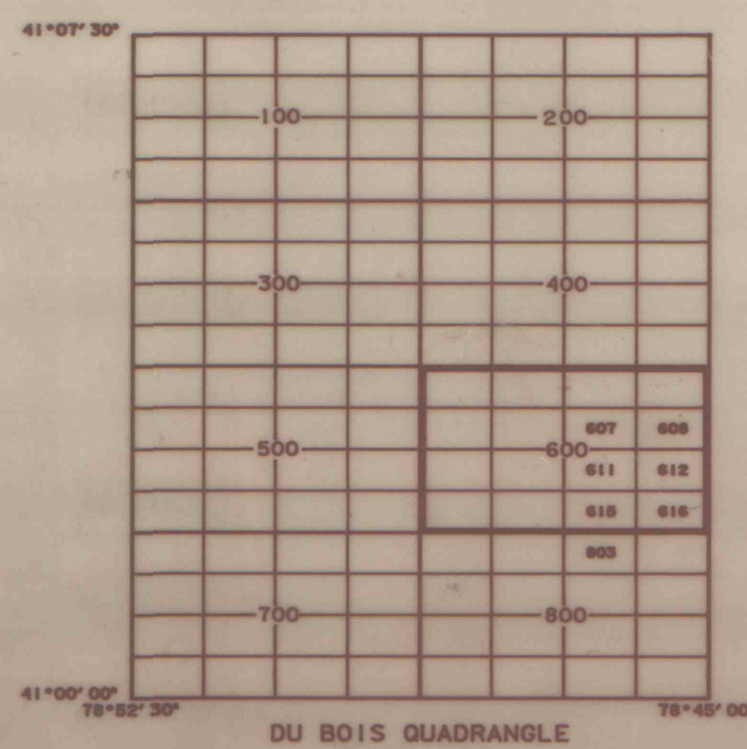

TROUTVILLE 2

- LF DEEP MINE
- BARRIER
- xxx PREVIOUS STRIP MINING
- +++ MAH-R CROPLINE
- (---) MAH-R MINING AREA
- +++ MAH CROPLINE
- (---) MAH MINING AREA
- +++ UF CROPLINE
- (---) UF MINING AREA
- ↑↑↑ UF AUGER AREA
- +++ LF CROPLINE
- (---) LF MINING AREA
- ↑↑↑ LF AUGER AREA
- +++ UK CROPLINE
- (---) UK MINING AREA
- +++ MK CROPLINE
- (---) MK MINING AREA
- ↑↑↑ MK AUGER AREA

AJP
MAY, 1988

ROCHESTER AND PITTSBURGH COAL CO.

655 CHURCH STREET INDIANA PA.

TROUTVILLE 2
HELVETIA COAL SITE

CLEARFIELD COUNTY

DU BOIS QUADRANGLE

SHEET NO. 4100-7845/600

IMAPS# 10128

400' Sepia ASP Trout 2