


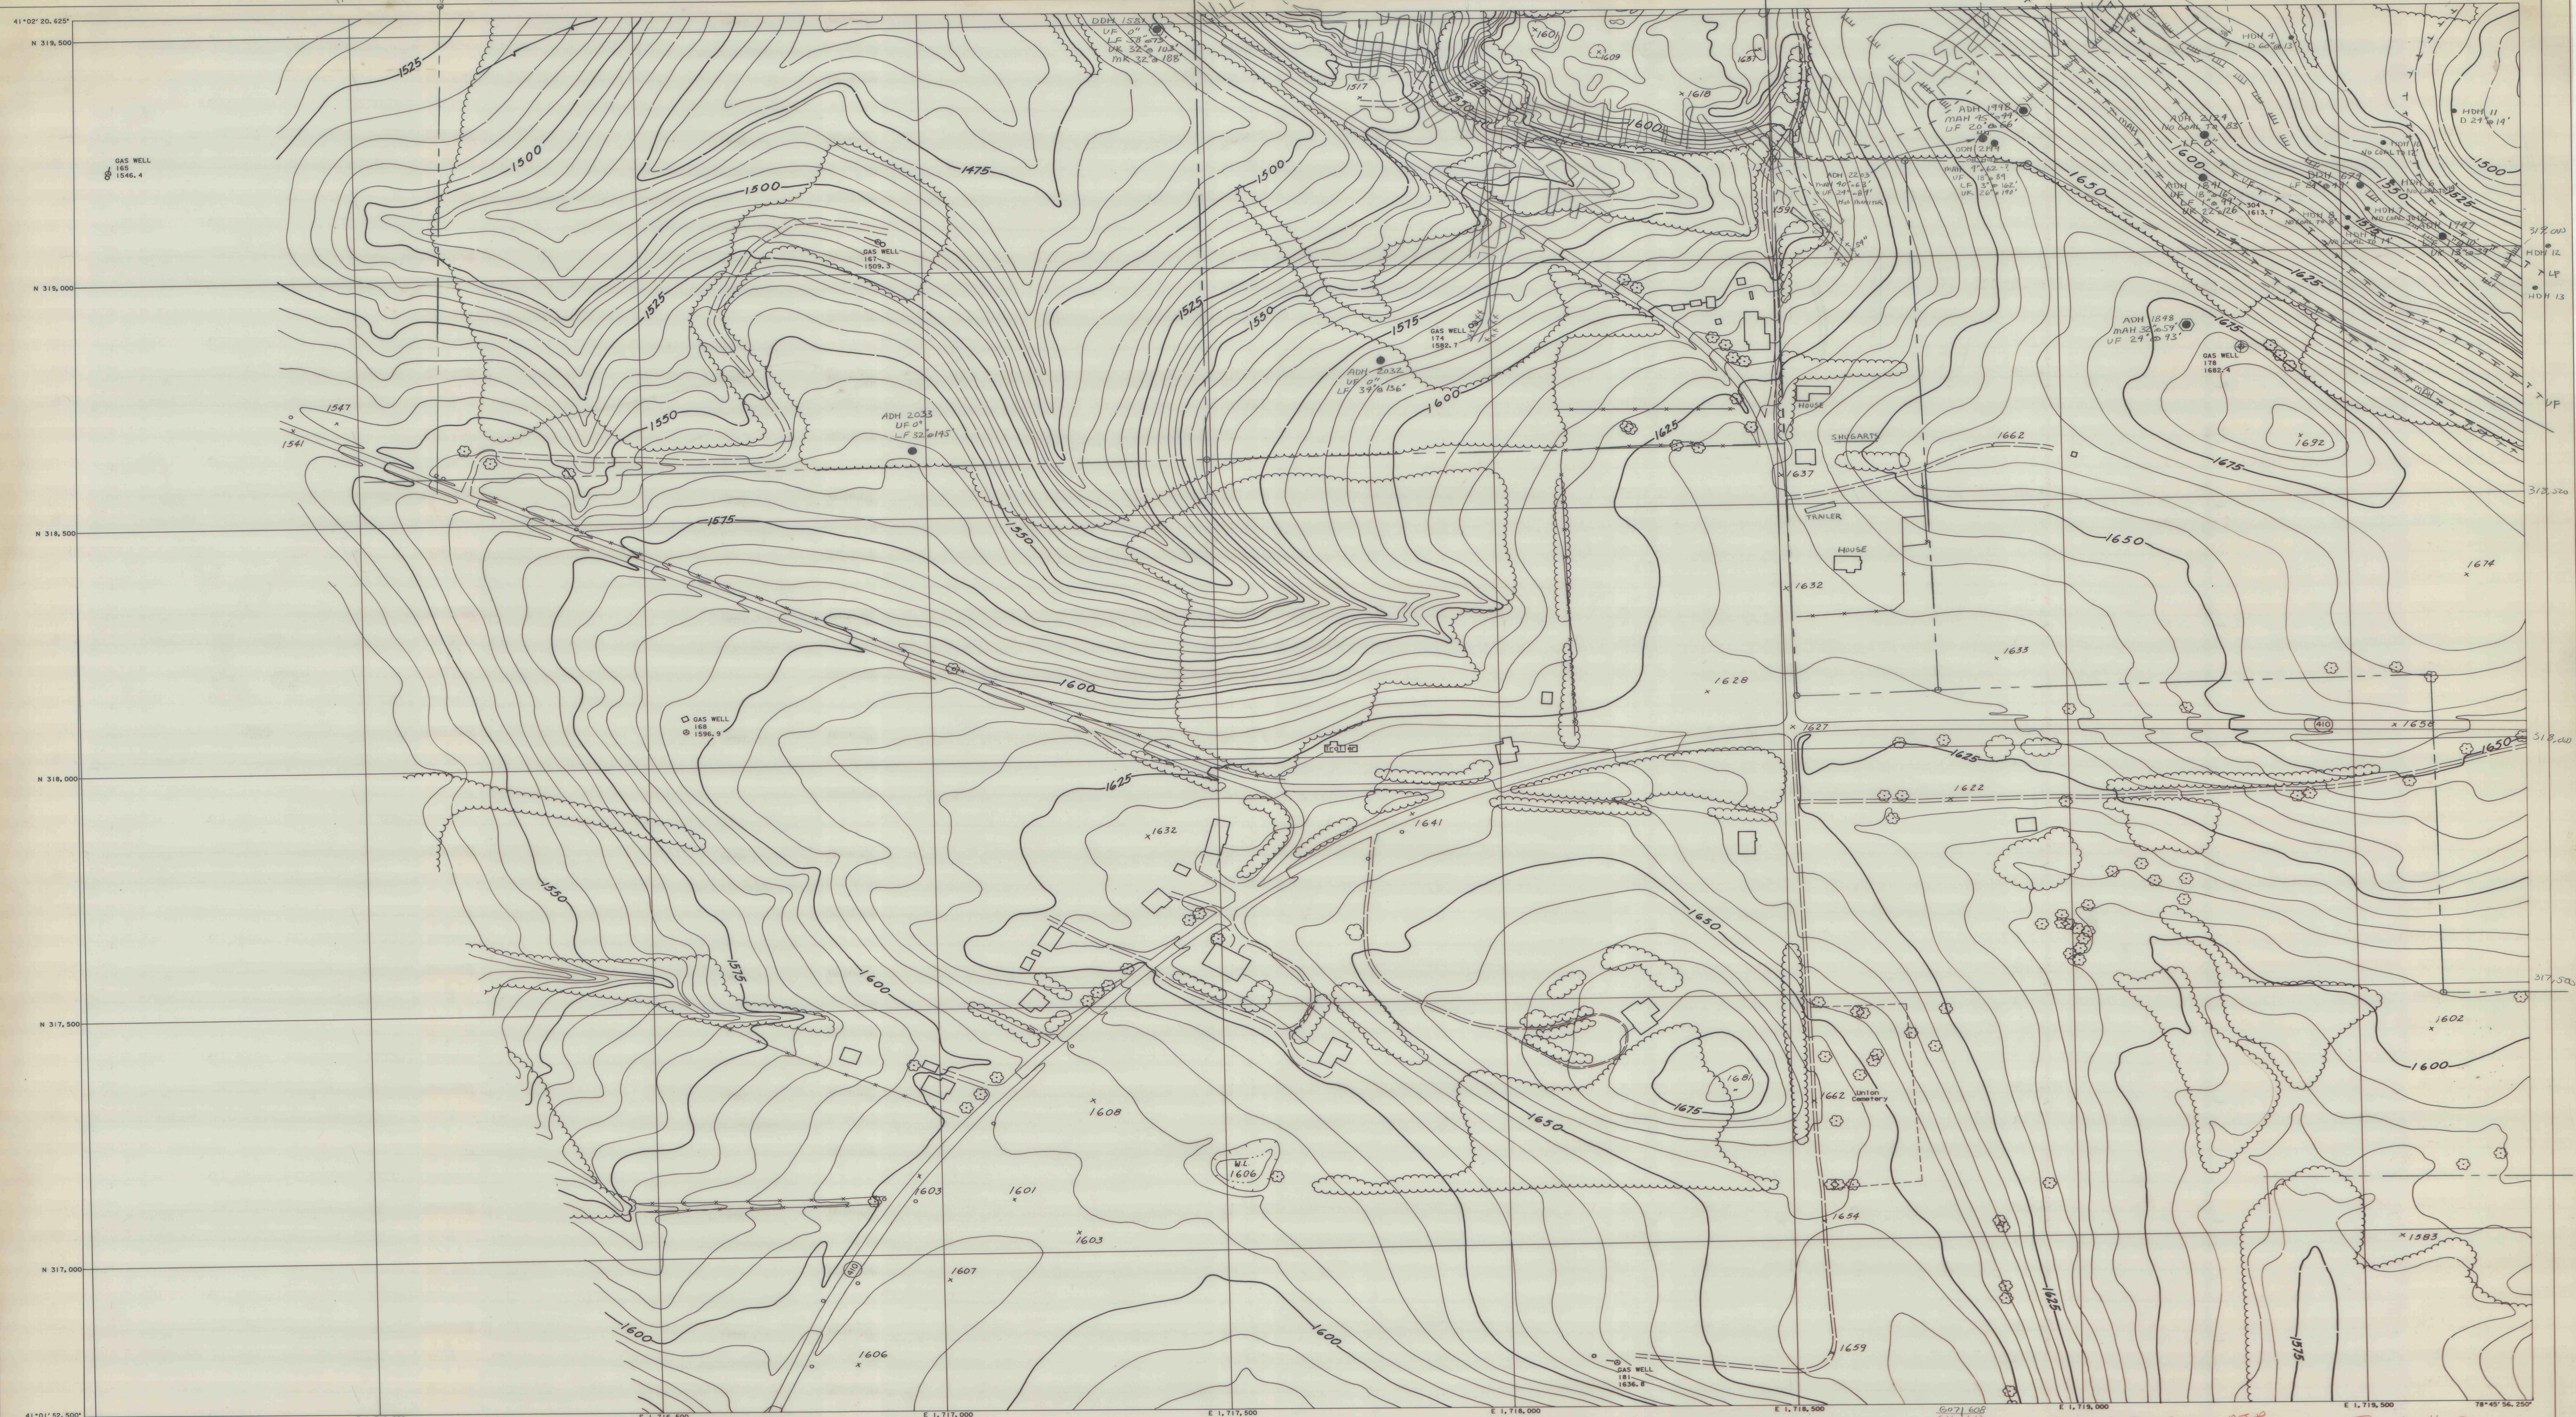

6071 608
611 612
615 616
IMAPS 10143
615 Sepia ASP
Troutville 2
ROCHESTER AND PITTSBURGH COAL CO.
615