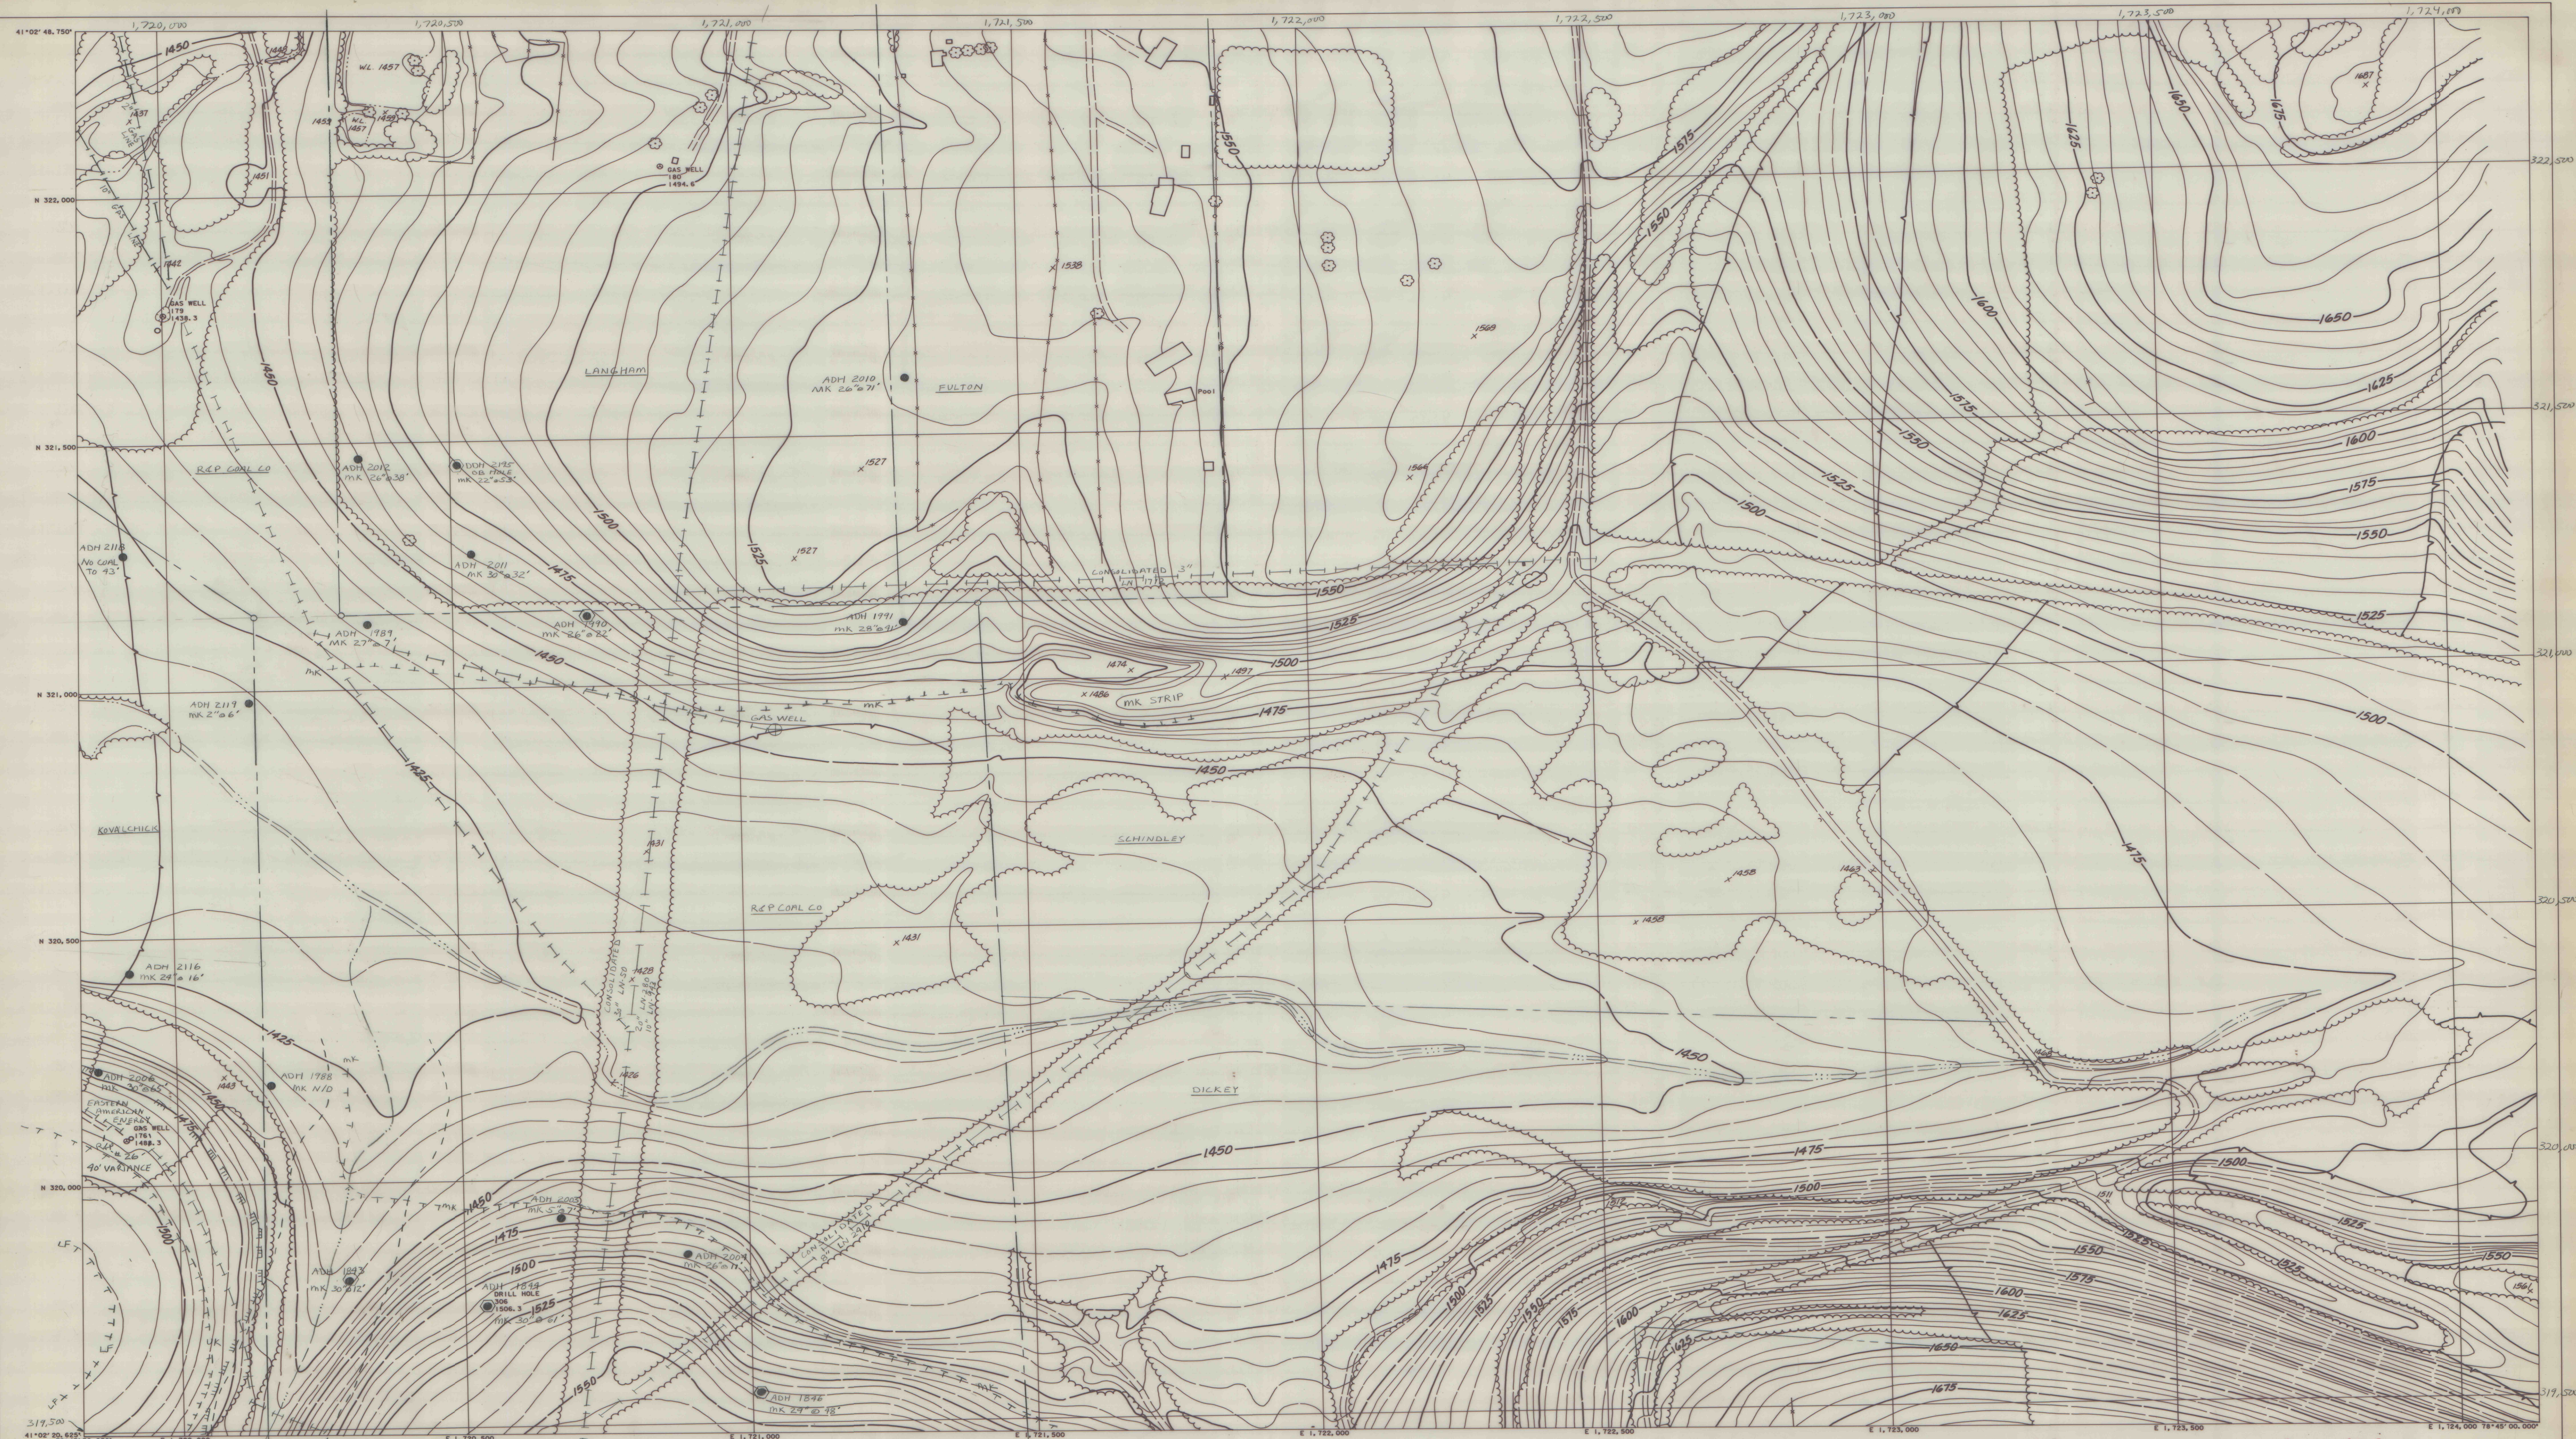


MAP# 10146

607 608  
611 612  
615 616

612 Sepia ASP Troutville 2  
ROCHESTER AND PITTSBURGH COAL CO.  
655 CHURCH STREET INDIANA PA.

612