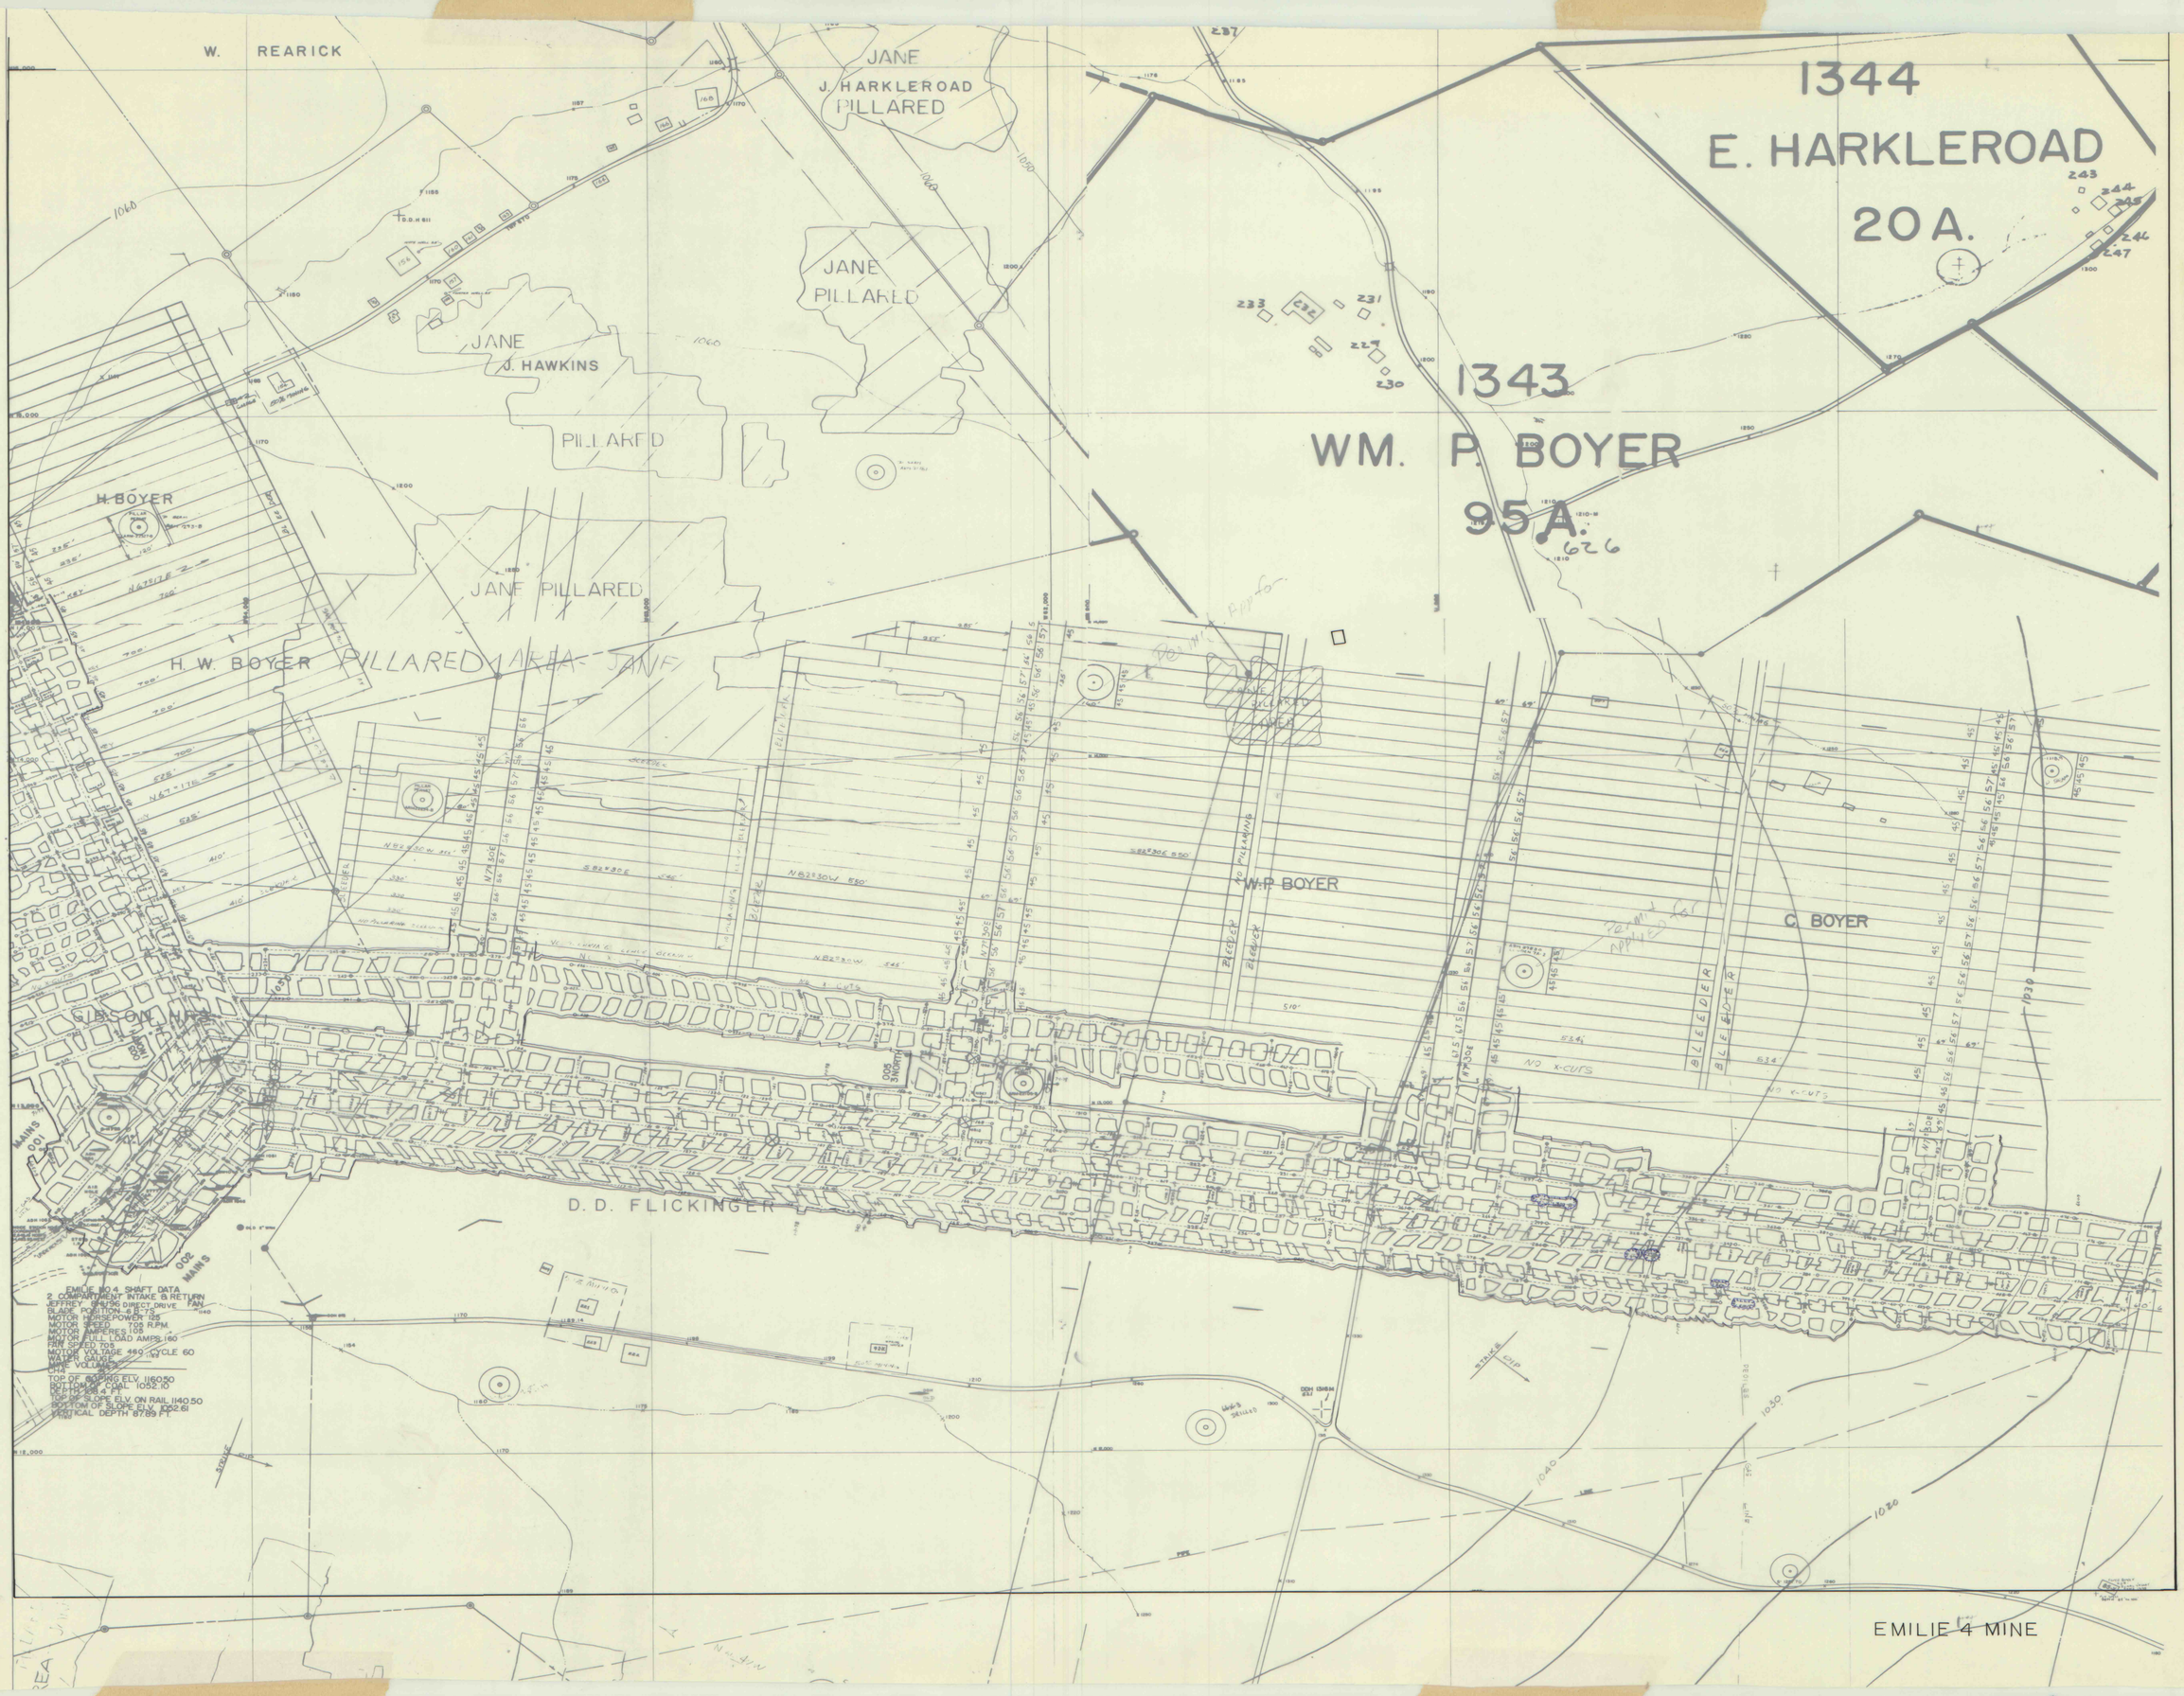
W. REARICK
JANE
J. HARKLEROAD
PILLARED
JANE
PILLARED
JANE
J. HAWKINS
PILLARED
JANE PILLARED
H. BOYER
H. W. BOYER
PILLARED AREA JANE
1344
E. HARKLEROAD
20 A.
1343
WM. P. BOYER
95 A.
W.P. BOYER
C. BOYER
GIBSONIA
D. D. FLICKINGER
EMILIE NO. 4 SHAFT DATA
2 COMPARTMENT INTAKE & RETURN
JEFFREY 84-136 DIRECT DRIVE FAN
BLADE POSITION-4.5-7.5
MOTOR HORSEPOWER 125
MOTOR SPEED 705 R.P.M.
MOTOR AMPERES 105
MOTOR FULL LOAD AMPS 160
FAN SPEED 705
MOTOR VOLTAGE 460 CYCLE 60
WATER GAUGE
AIR VOLUME
TOP OF SHAFT ELV. 1160.50
BOTTOM OF COAL 1052.10
DEPTH 108.4 FT.
TOP OF SLOPE ELV. ON RAIL 1140.50
BOTTOM OF SLOPE ELV. 1052.61
VERTICAL DEPTH 87.89 FT.
EMILIE 4 MINE

IMAPS # 10159