


 SCALE: HORIZONTAL 1"=400'
 VERTICAL 1"=100'
 DRILL HOLES ON A LINE OF N12°15'W

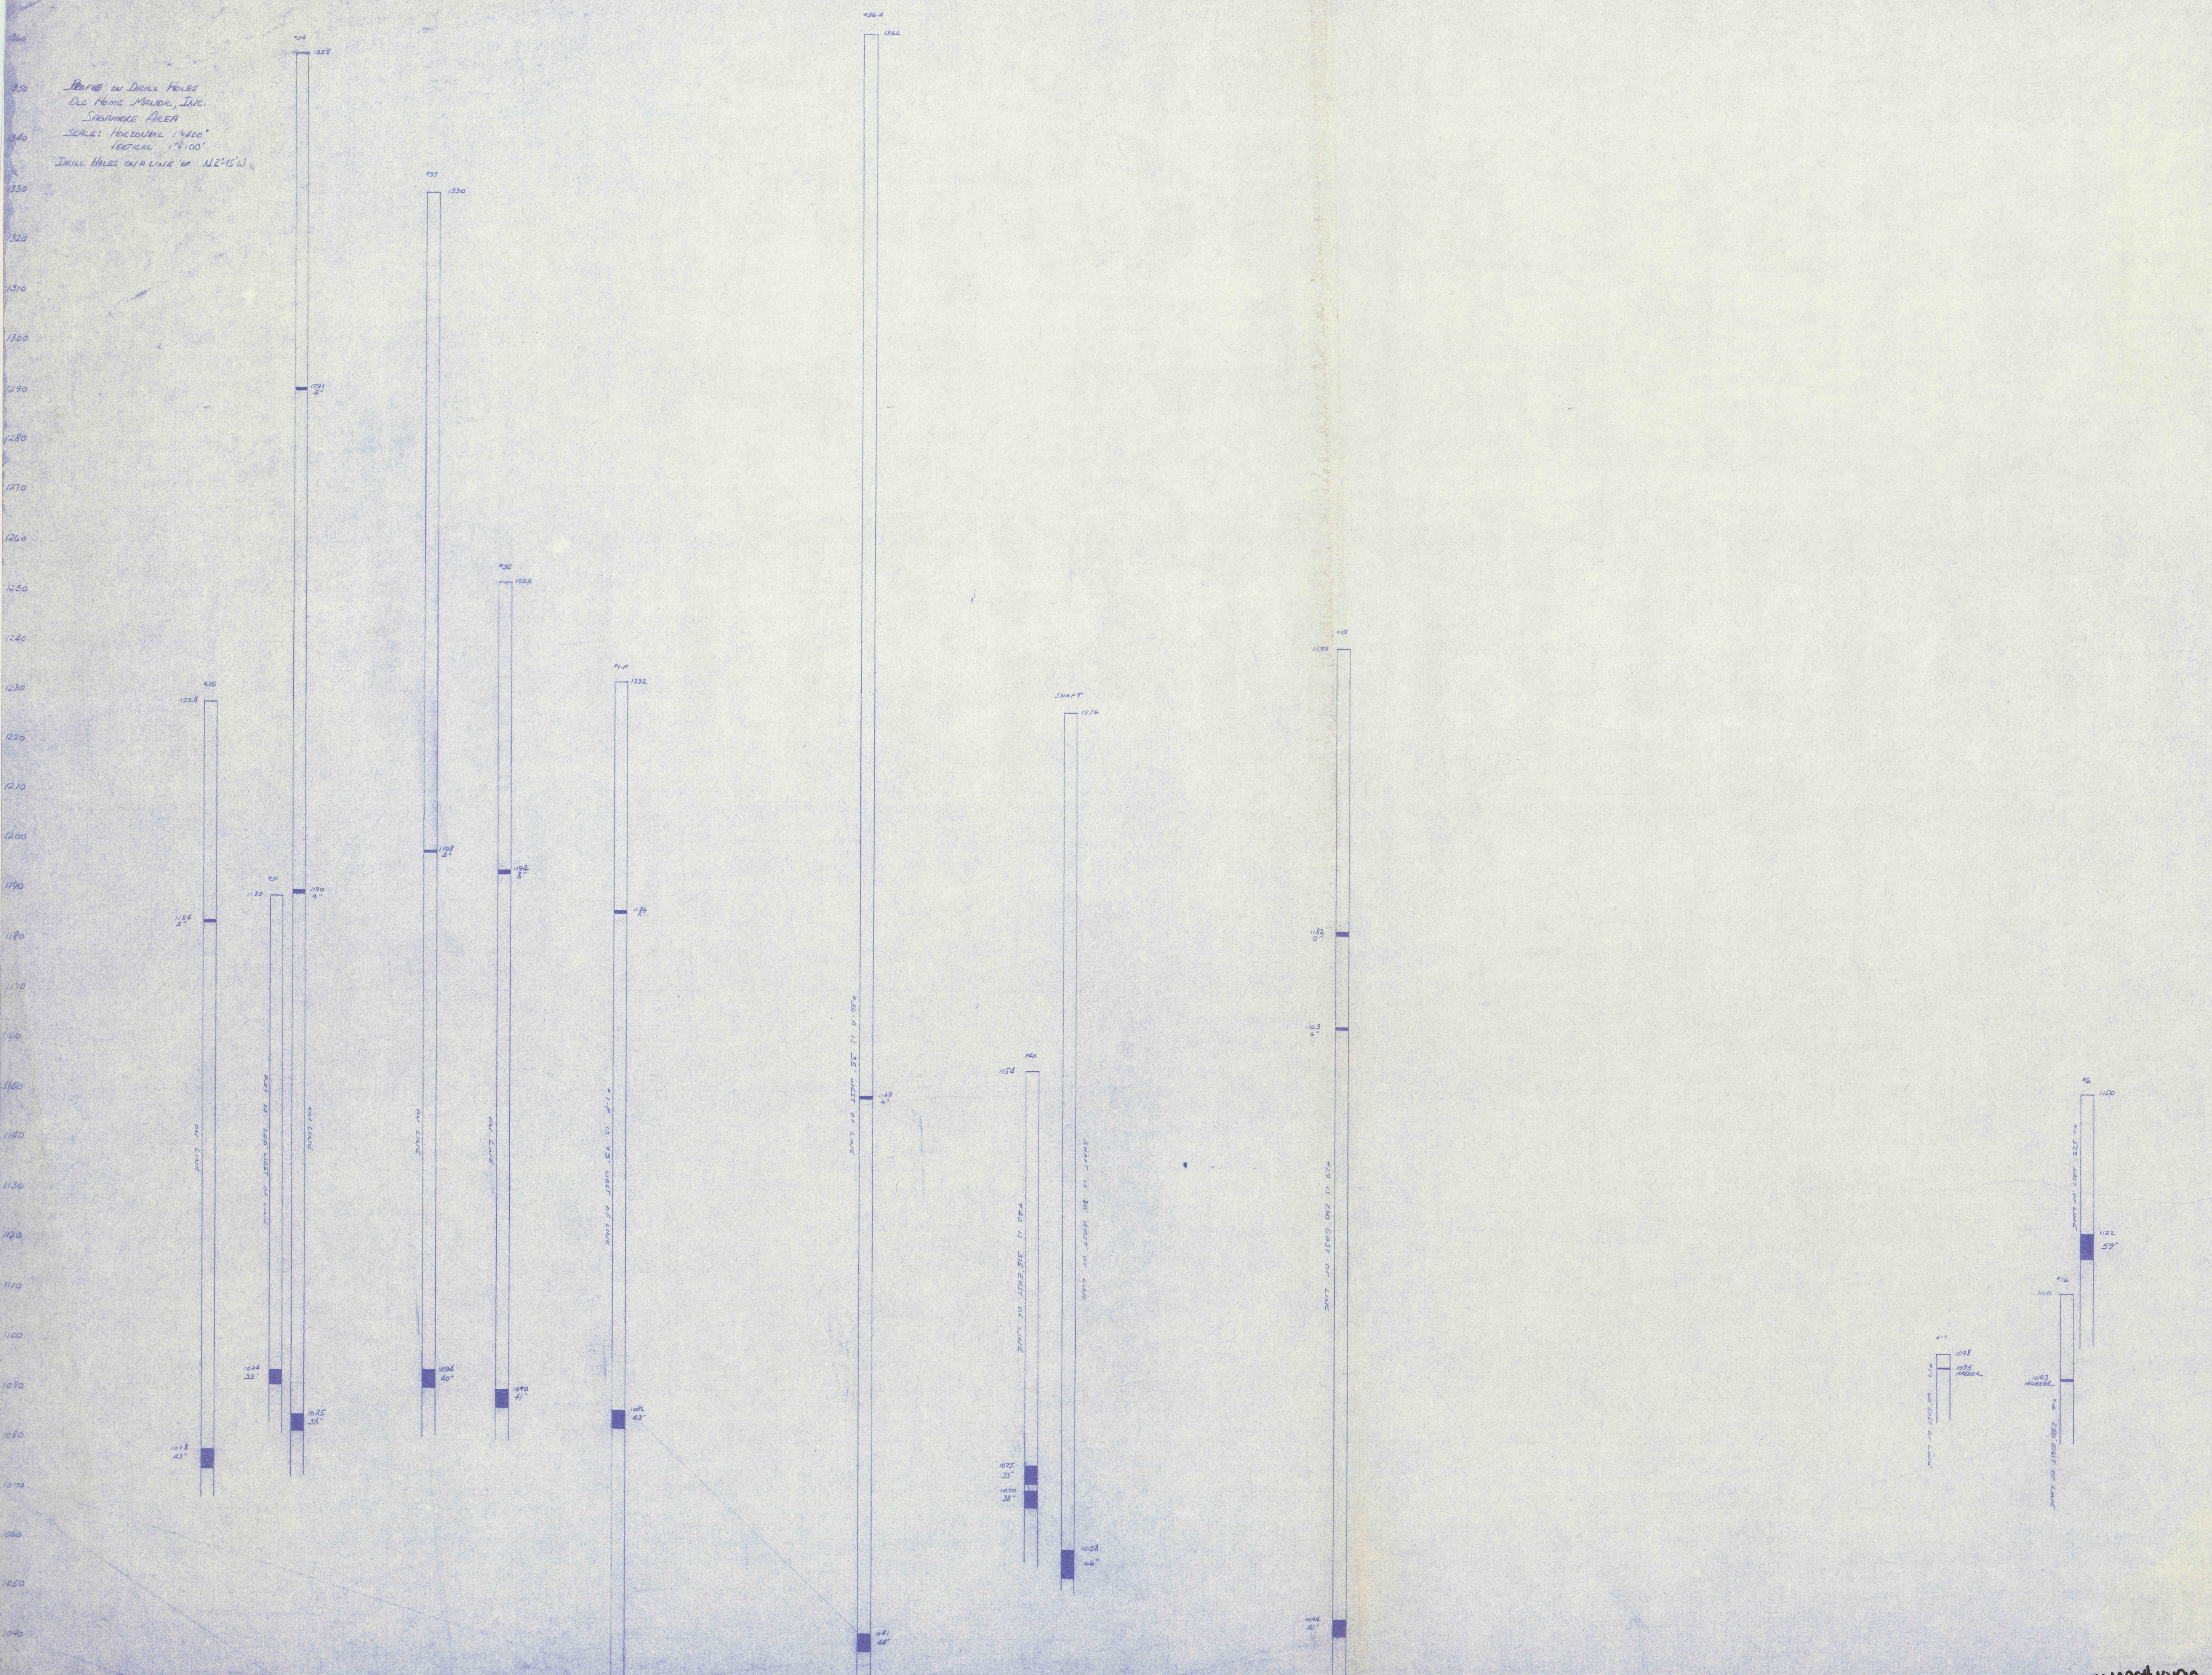

11405#10190