


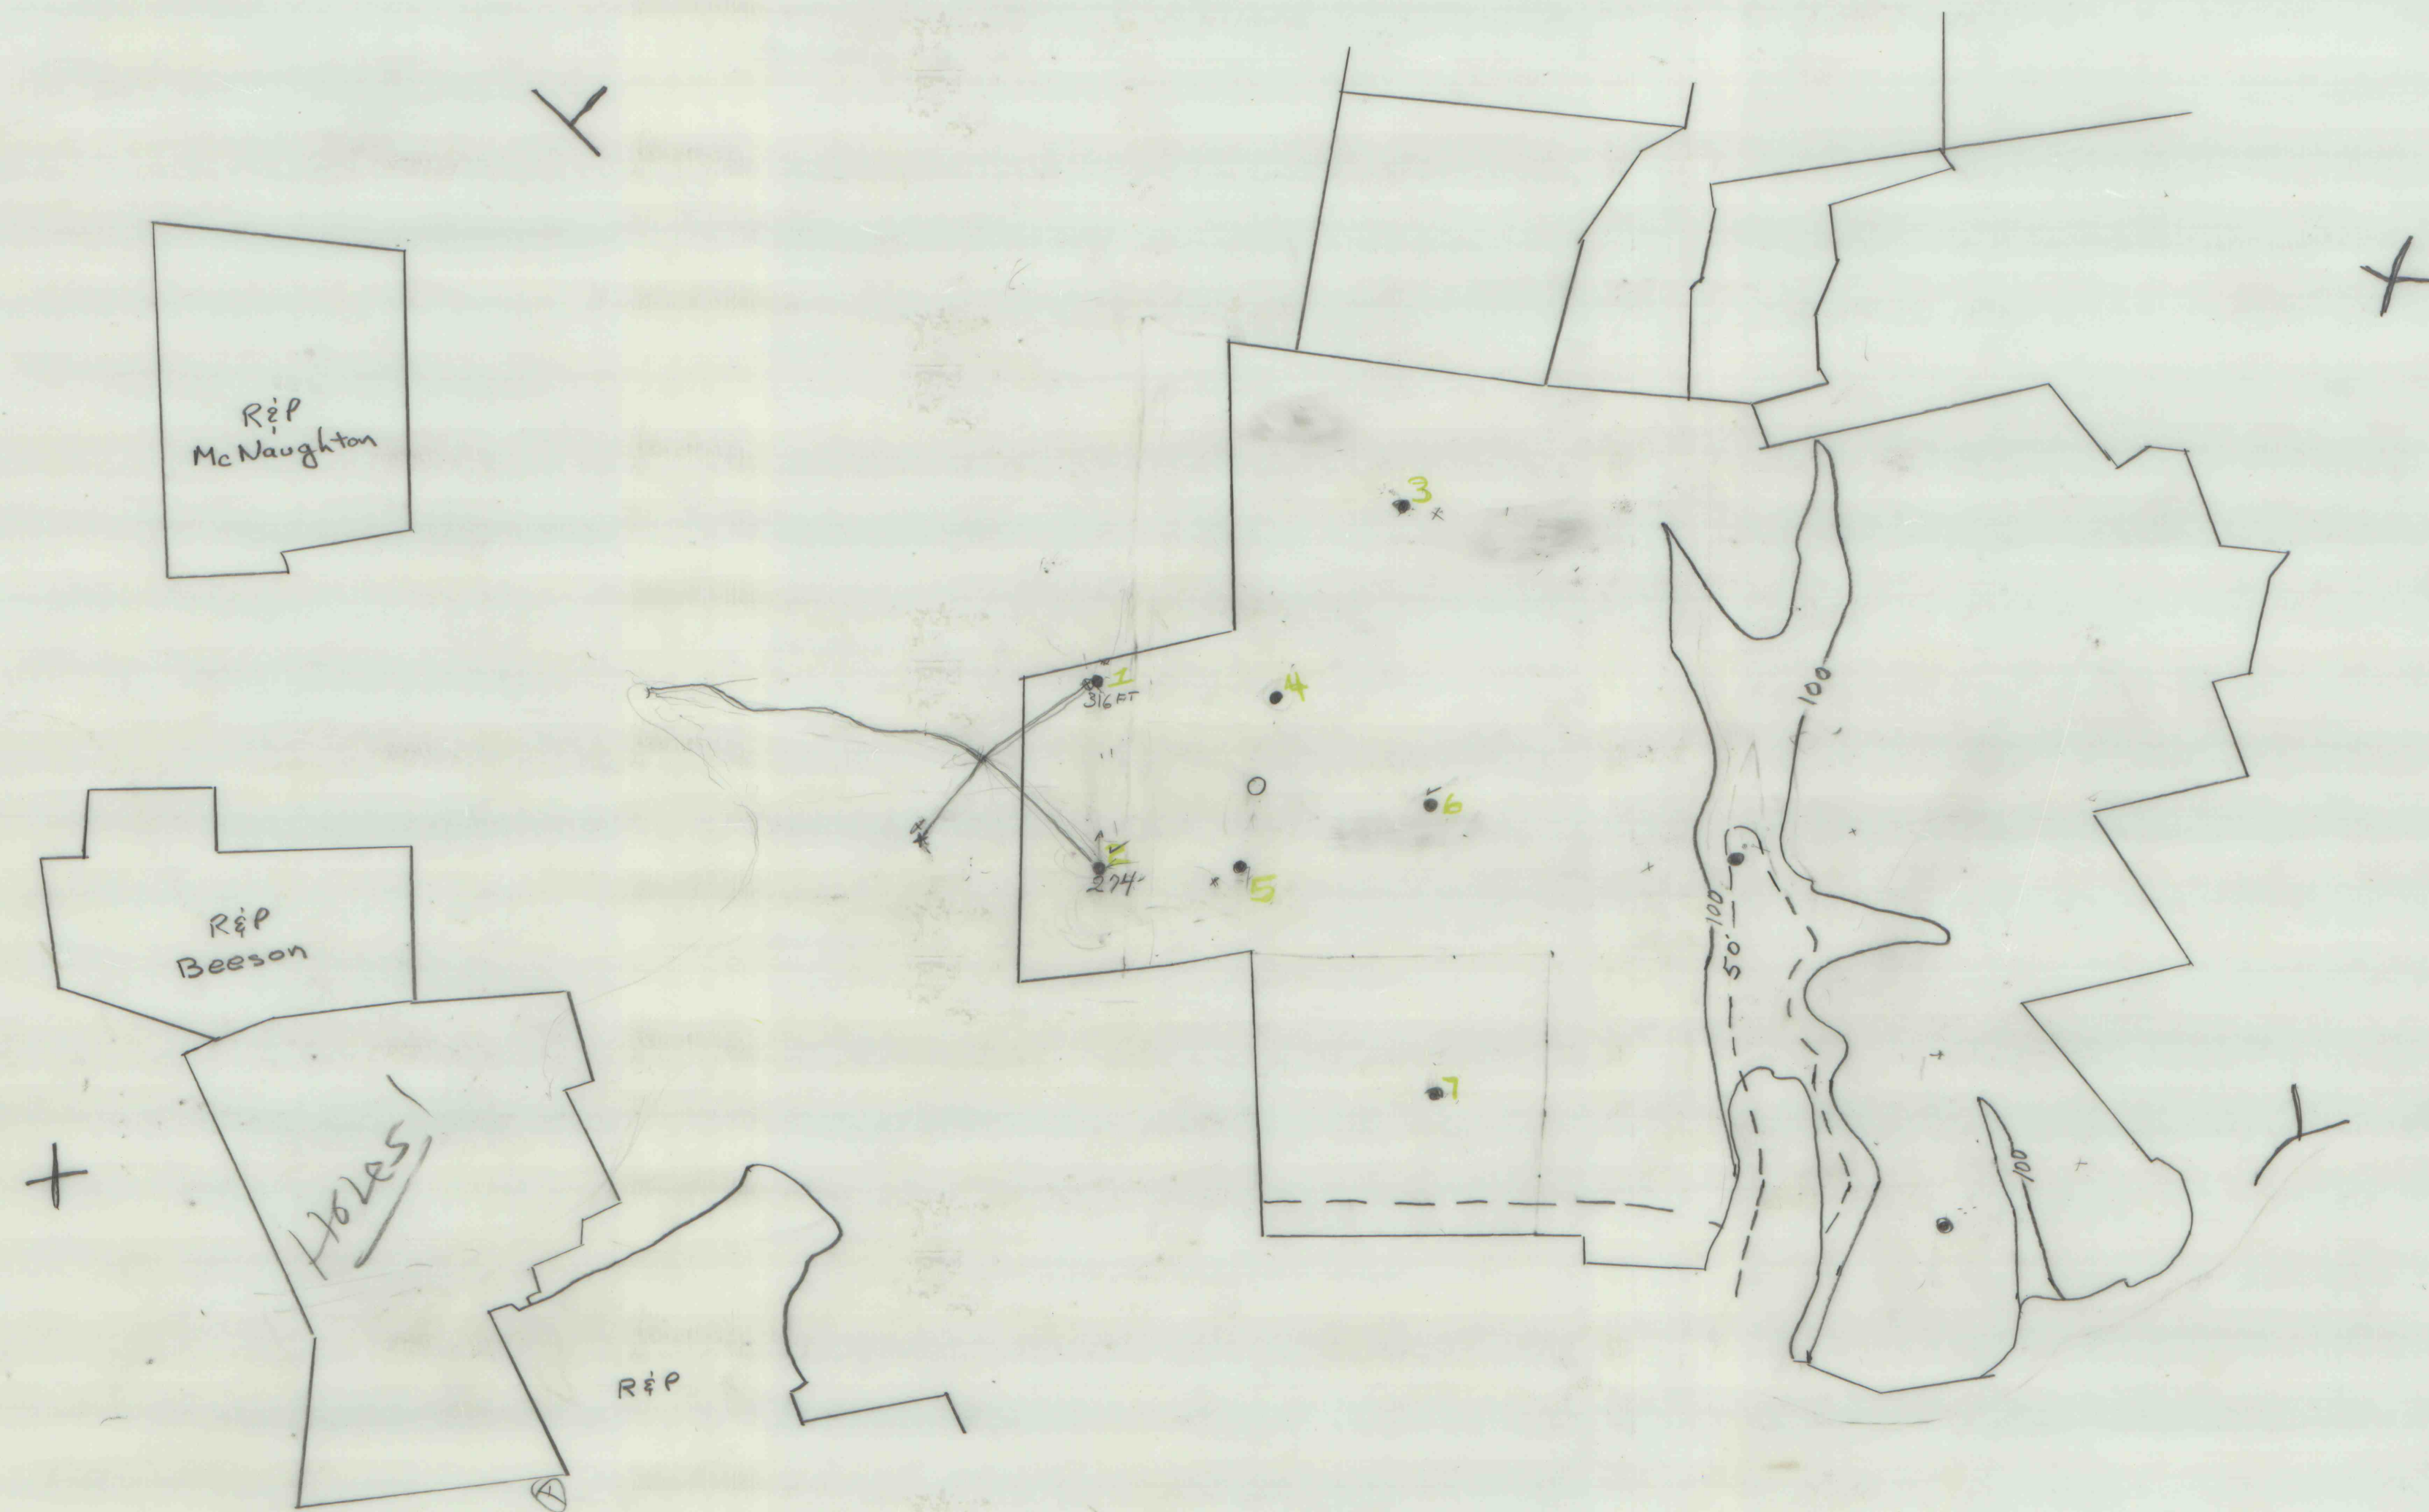

HELVETIA COAL CO.
ENGINEERING DEPT., INDIANA, PA.

MADE BY	SCALE
TRACED BY	DATE
CHECKED BY	NO.

IMAPS # 10198