


Surface B Coal

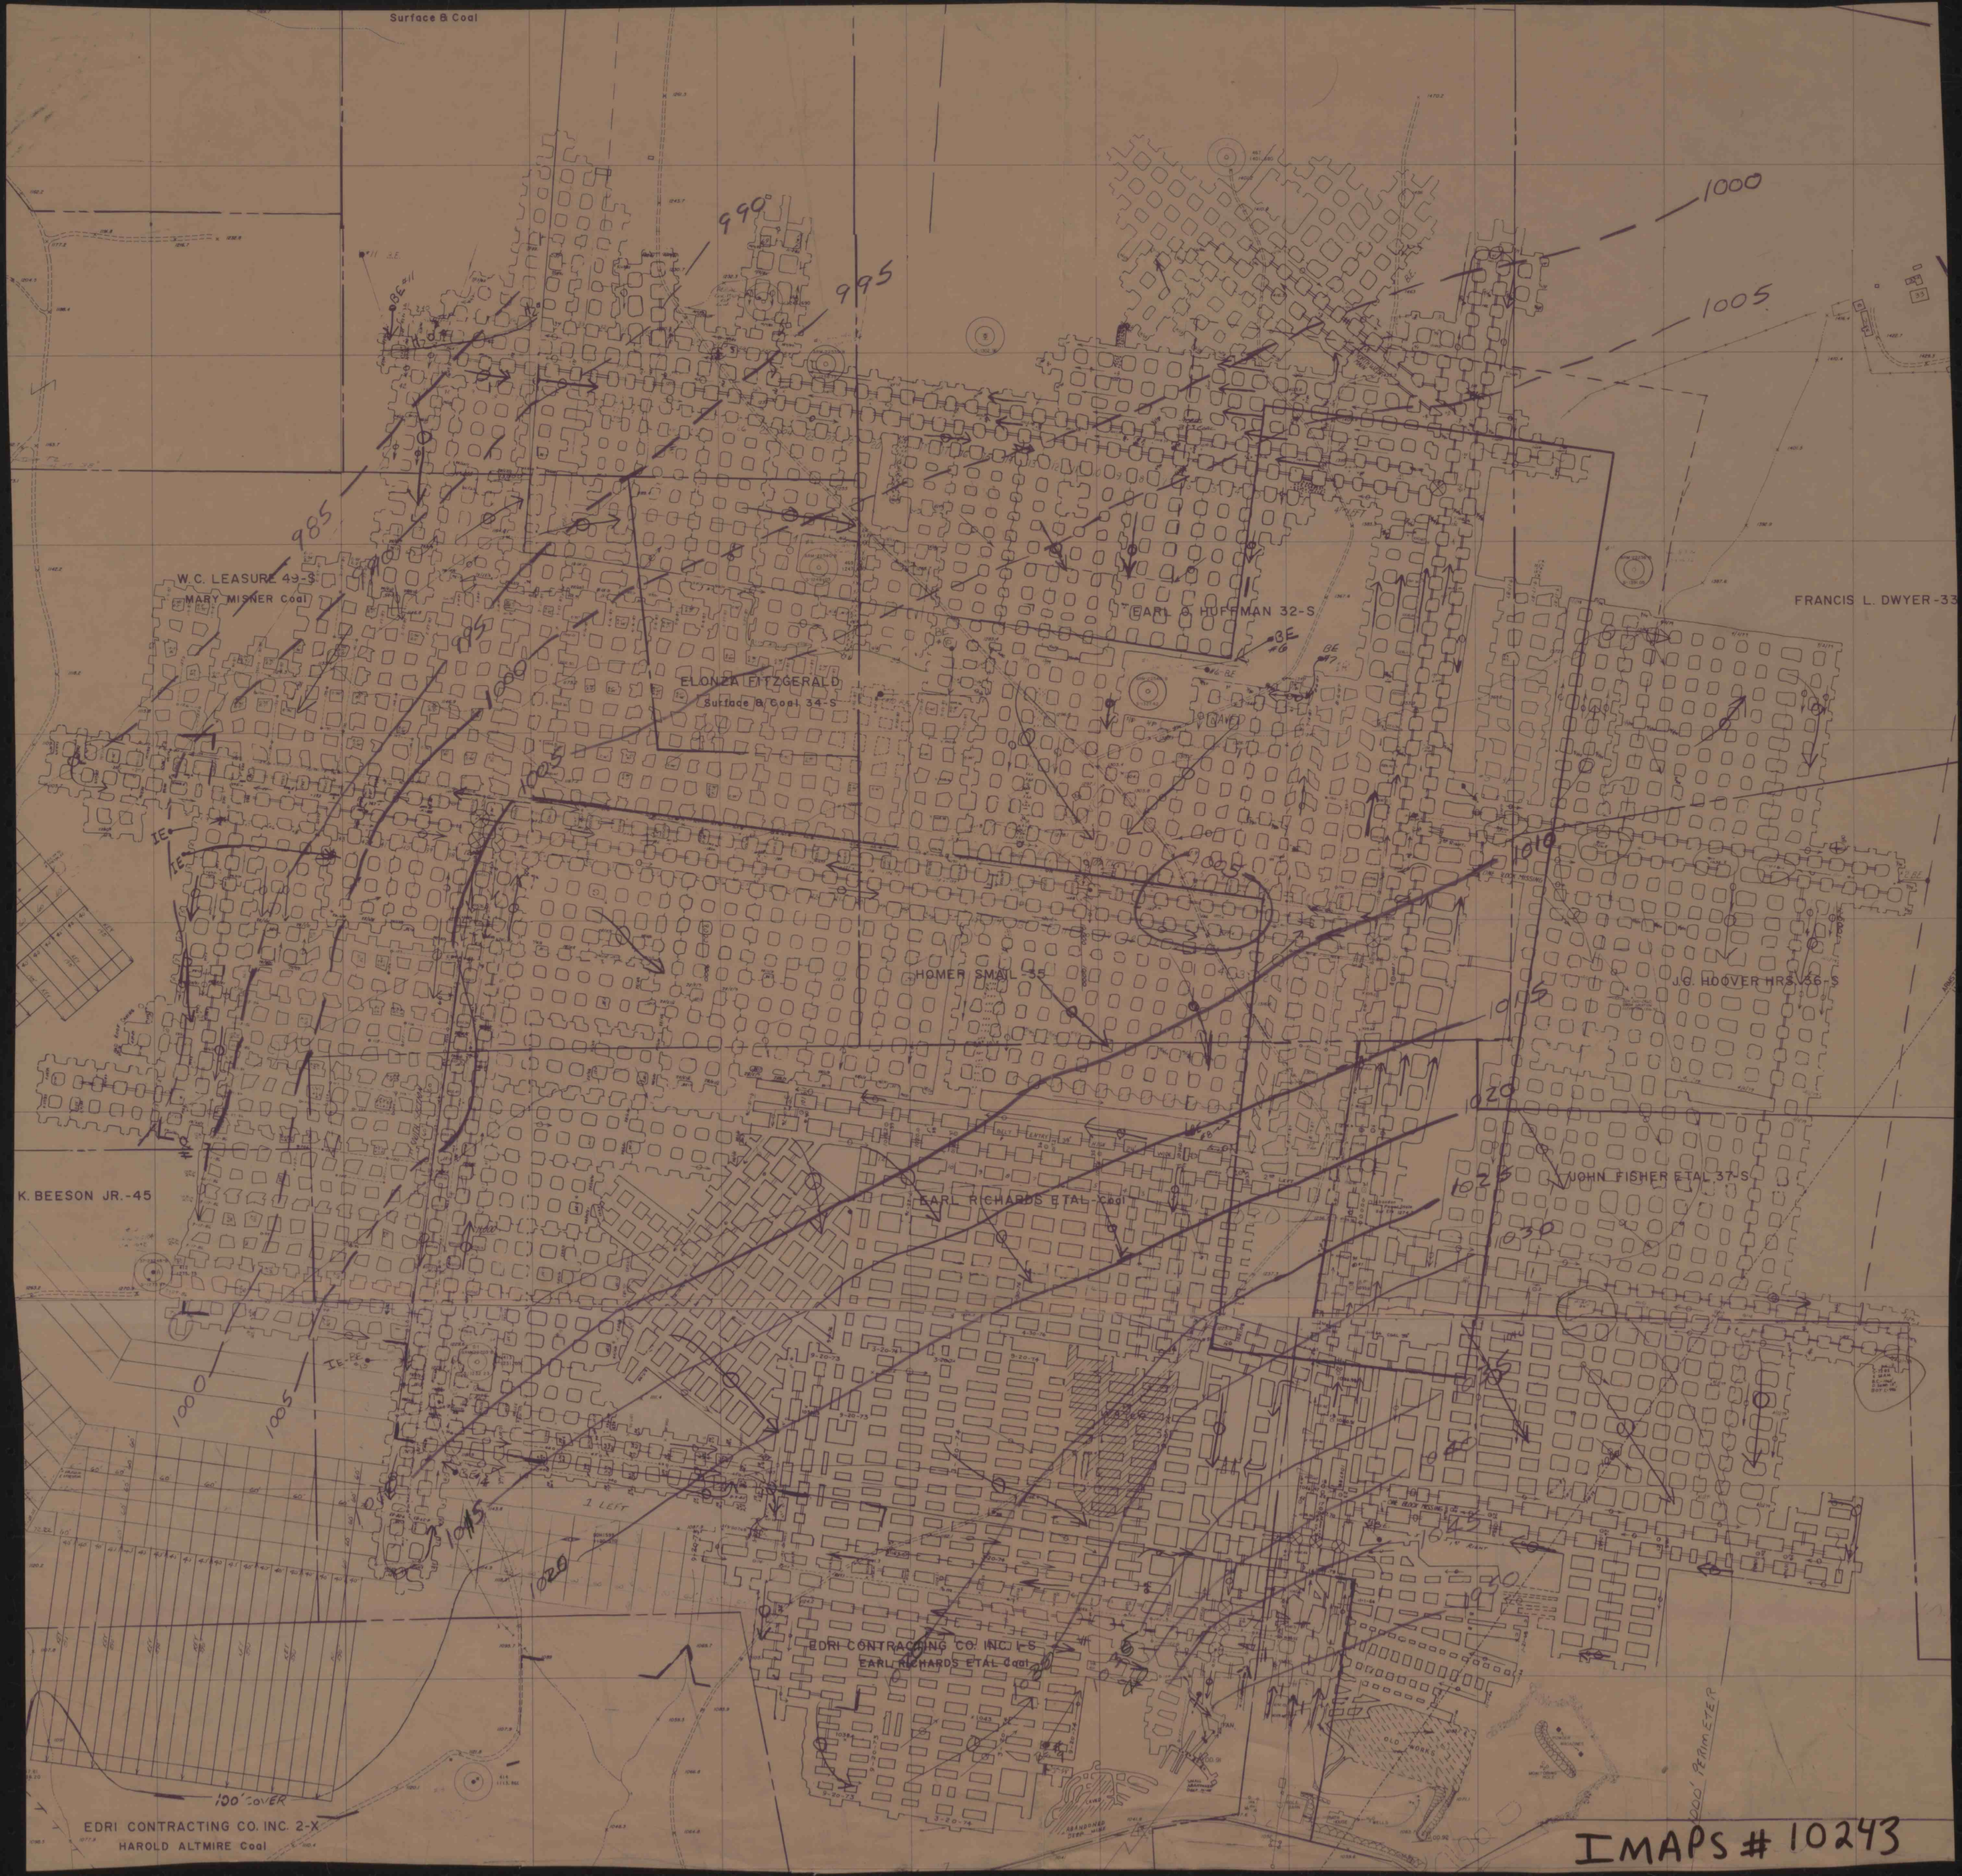

W.C. LEASURE 49-S
MARY MISNER Coal

ELONZA FITZGERALD
Surface B Coal 34-S

EARL & HUFFMAN 32-S

FRANCIS L. DWYER-33

HOMER SMALL 3-S

J.G. HOOVER HRS 36-S

JOHN FISHER ETAL 37-S

EARL RICHARDS ETAL 38-S

K. BEESON JR. -45

EDRI CONTRACTING CO. INC. 1-S
EARL RICHARDS ETAL Coal

EDRI CONTRACTING CO. INC. 2-X
HAROLD ALTMIRE Coal

IMAPS # 10243