


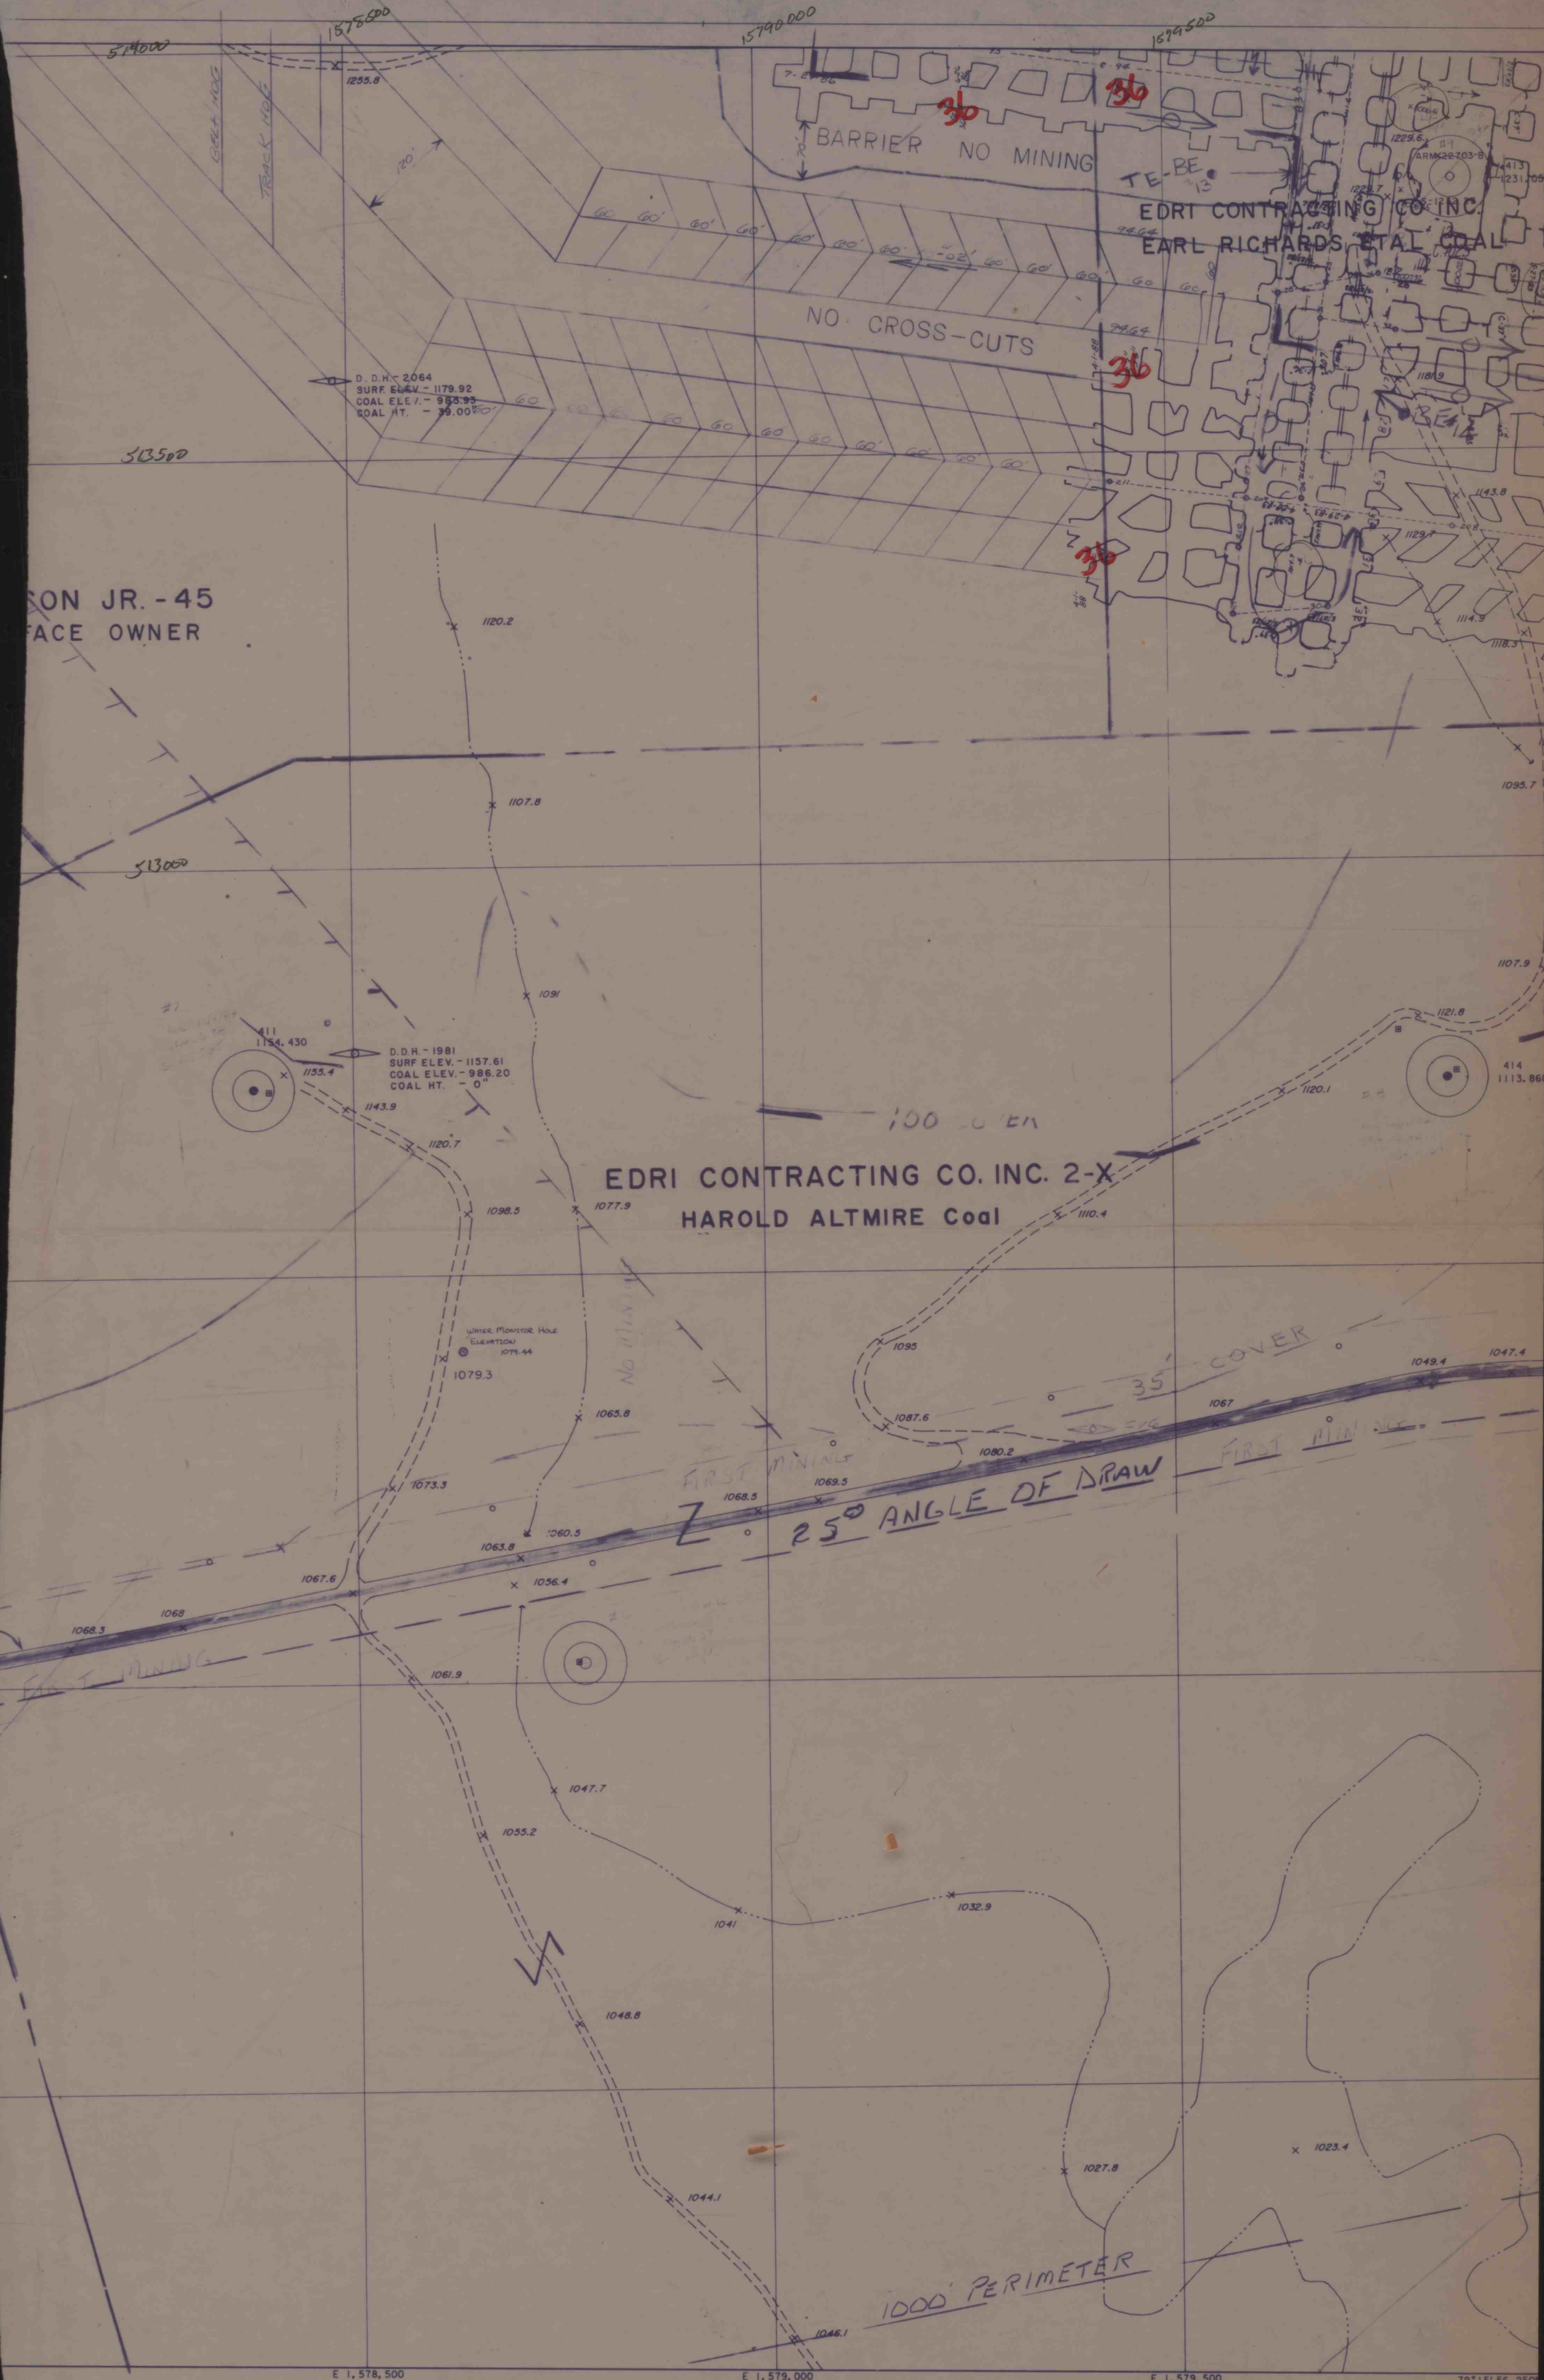

SON JR. - 45
FACE OWNER

EDRI CONTRACTING CO. INC. 2-X
HAROLD ALTMIRE Coal

FIRST MINING
25° ANGLE OF DRAW

1000' PERIMETER

O'DONNELL COAL CO. 1MAPSE10245

