


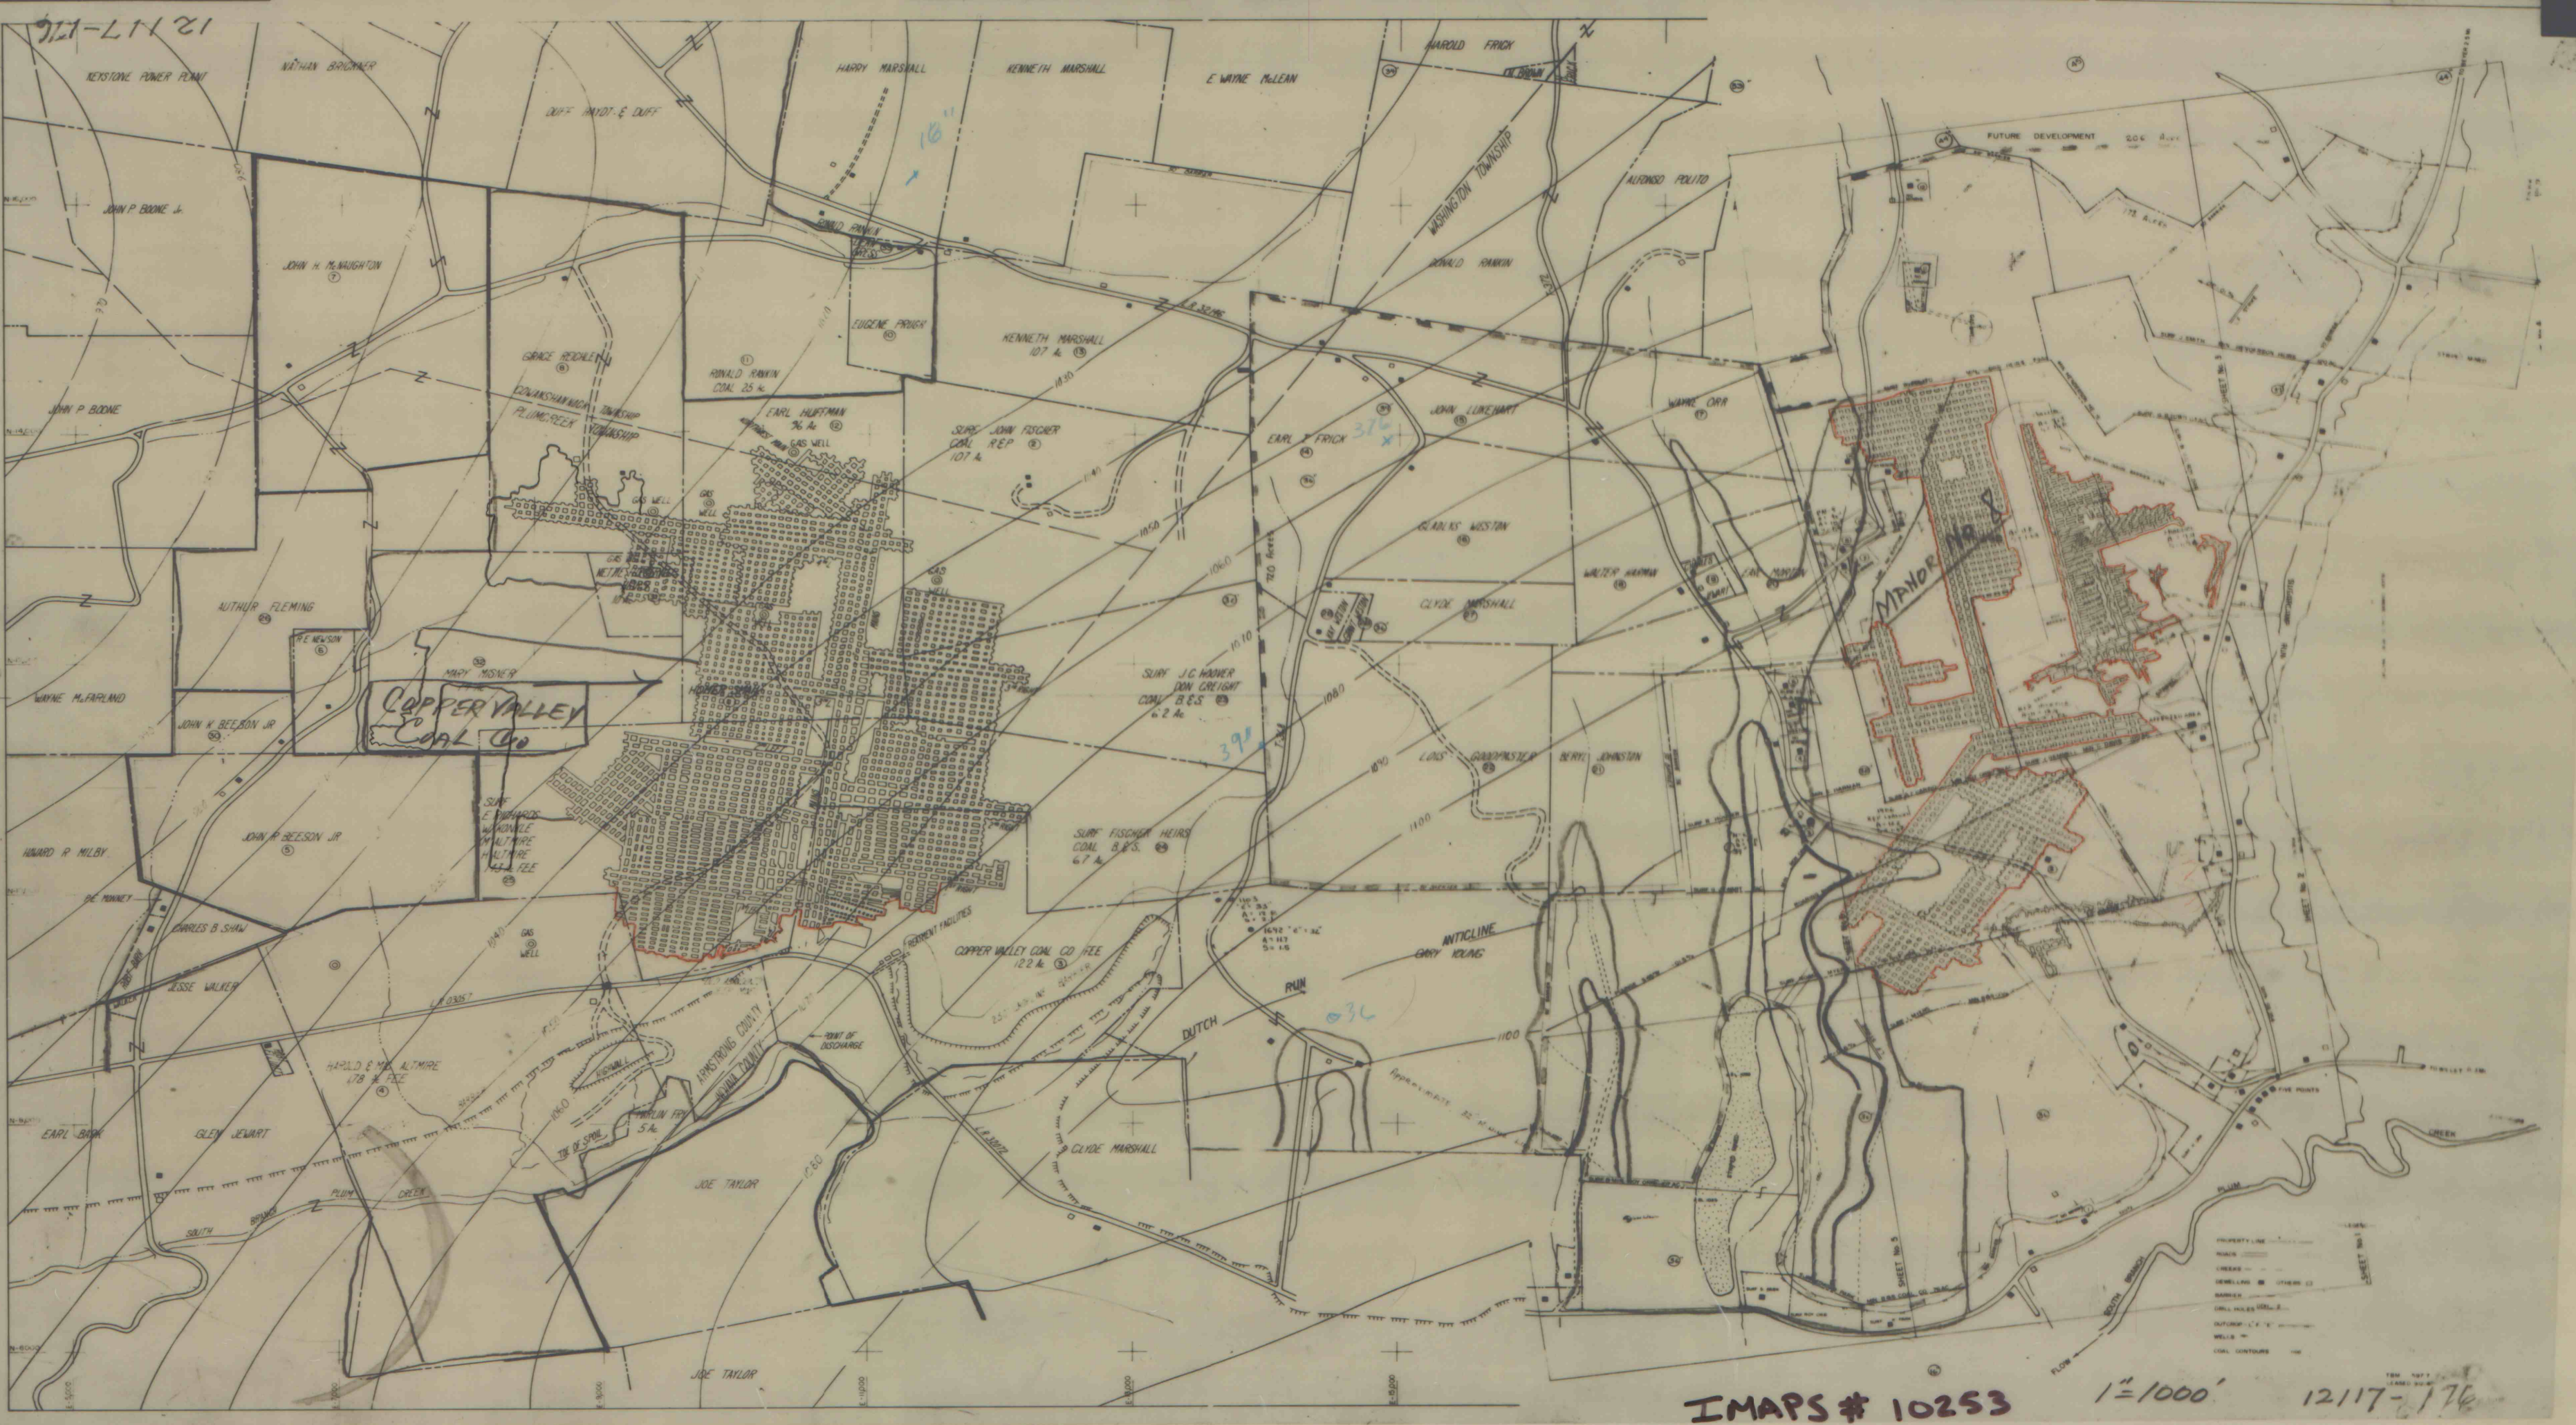

1217-176

IMAPS # 10253

1"=1000'

1217-176