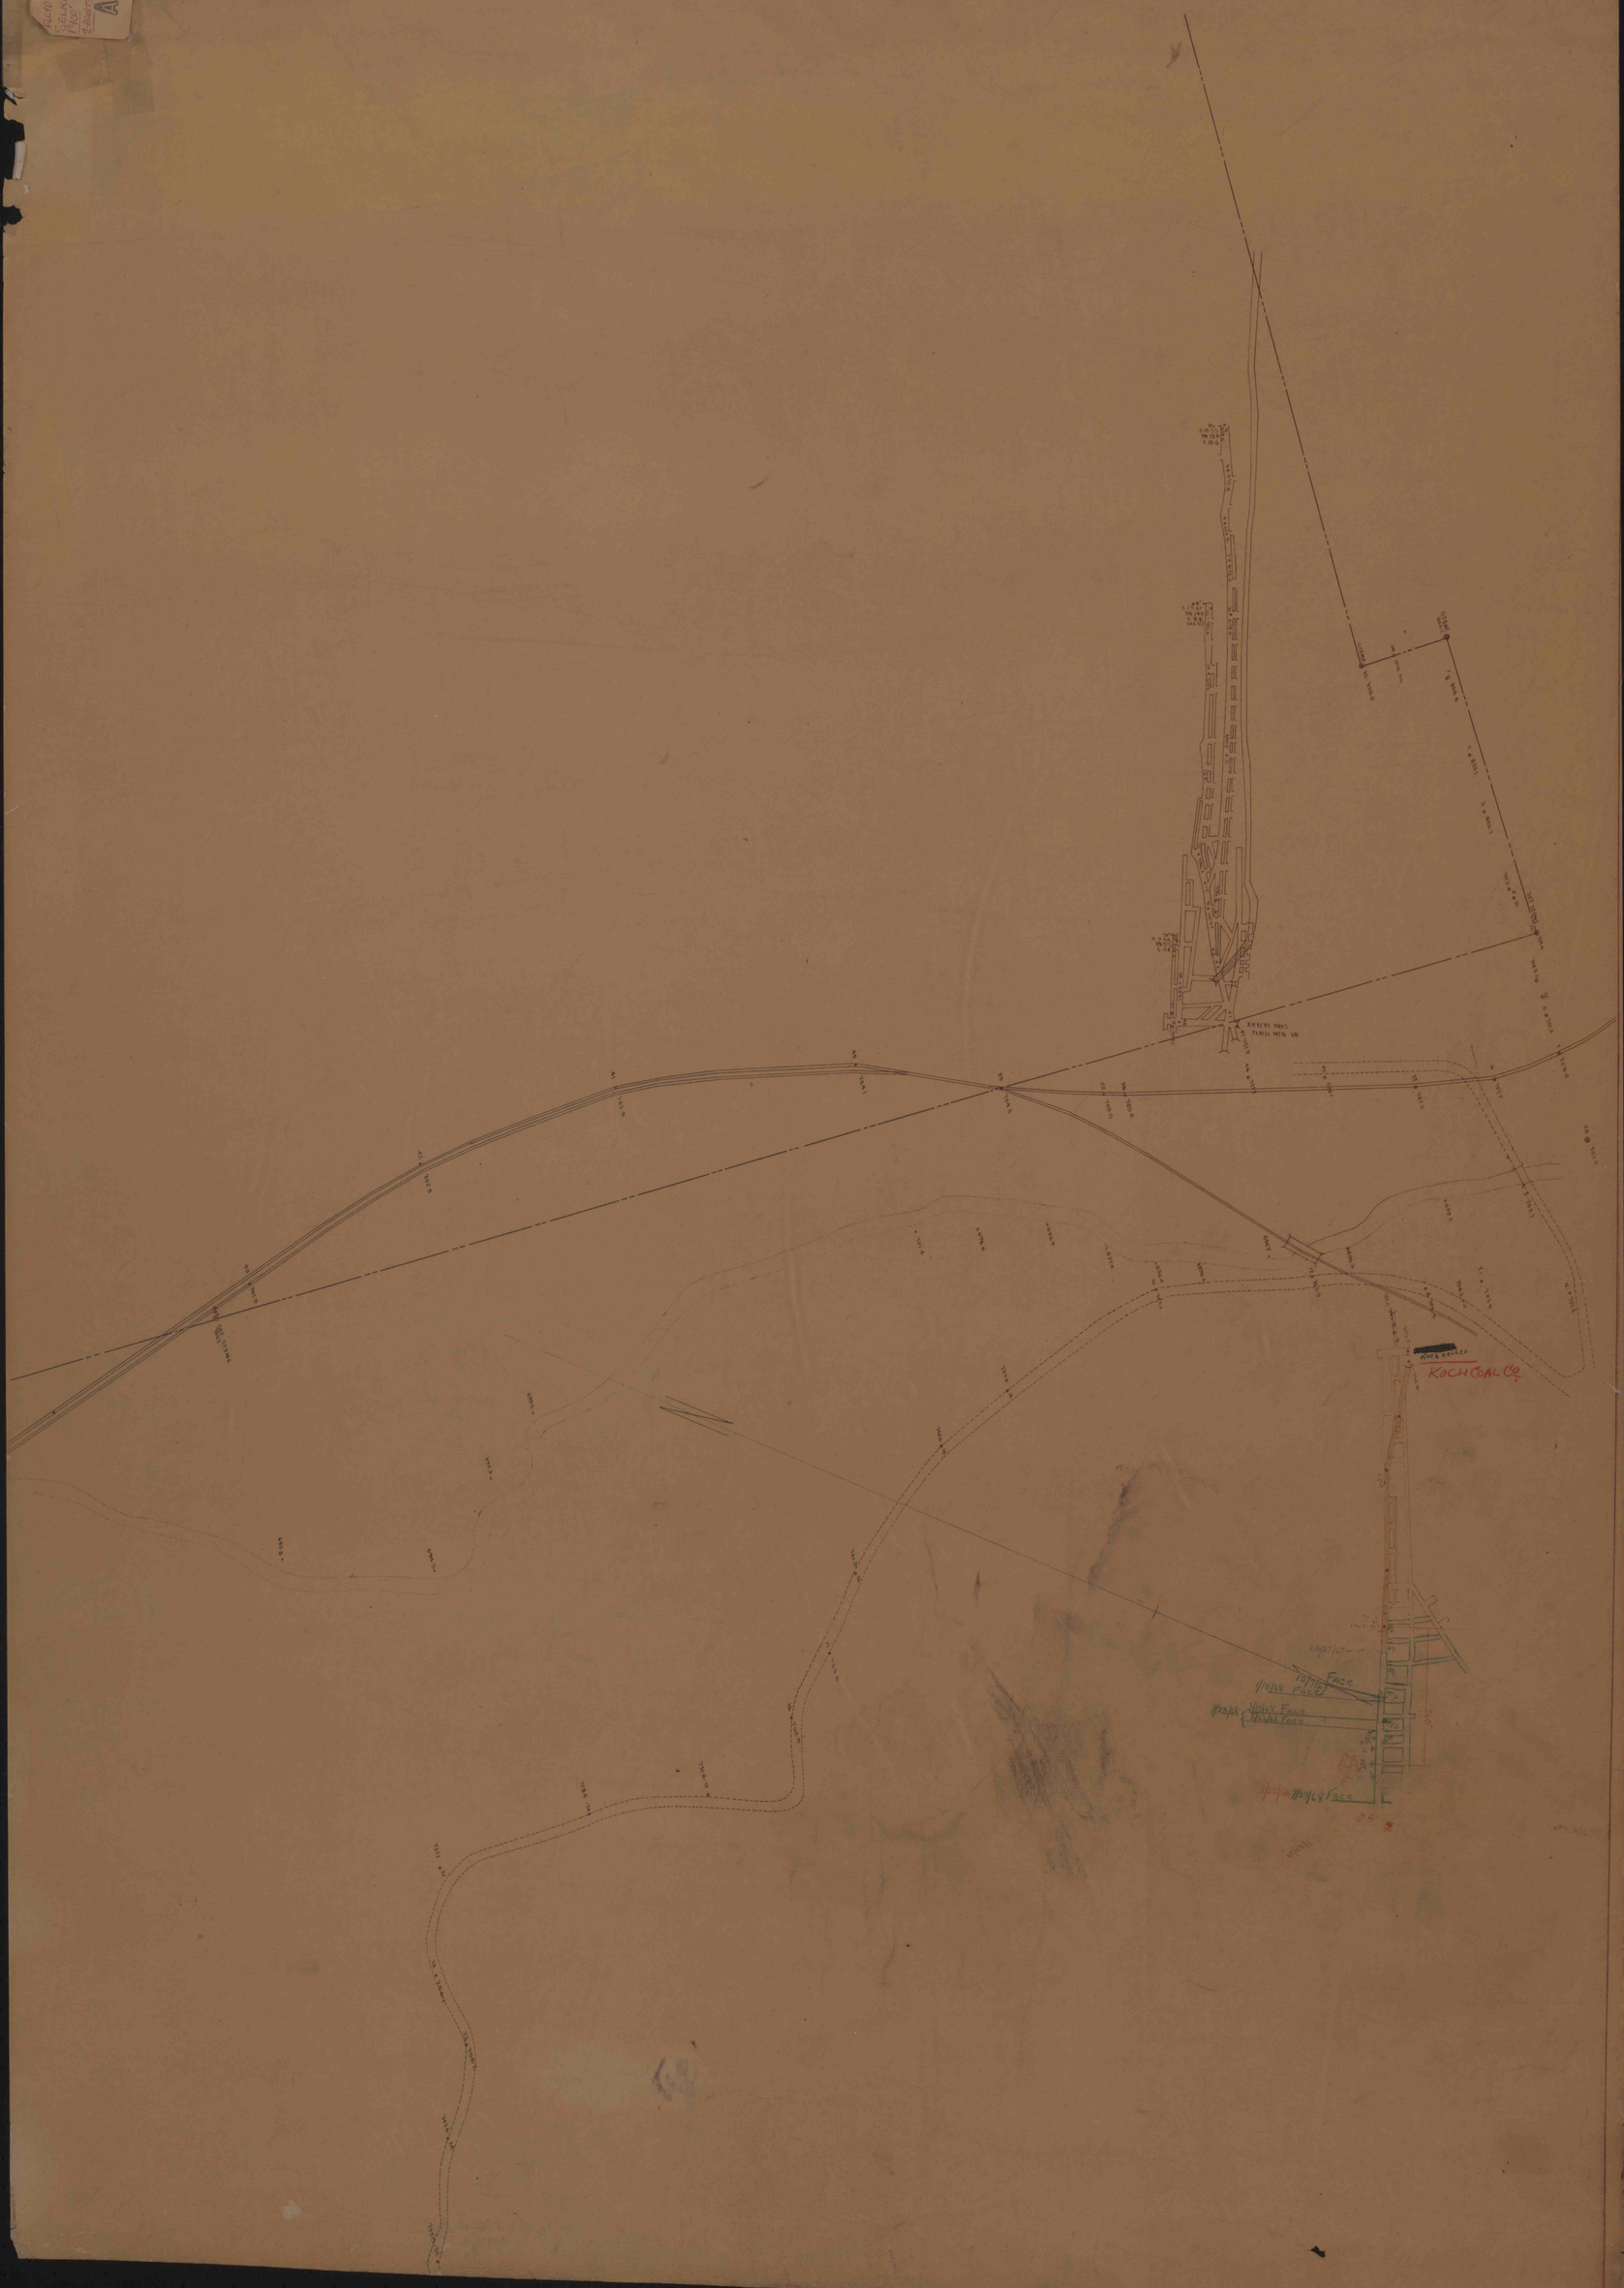
KOCH COAL CO.