


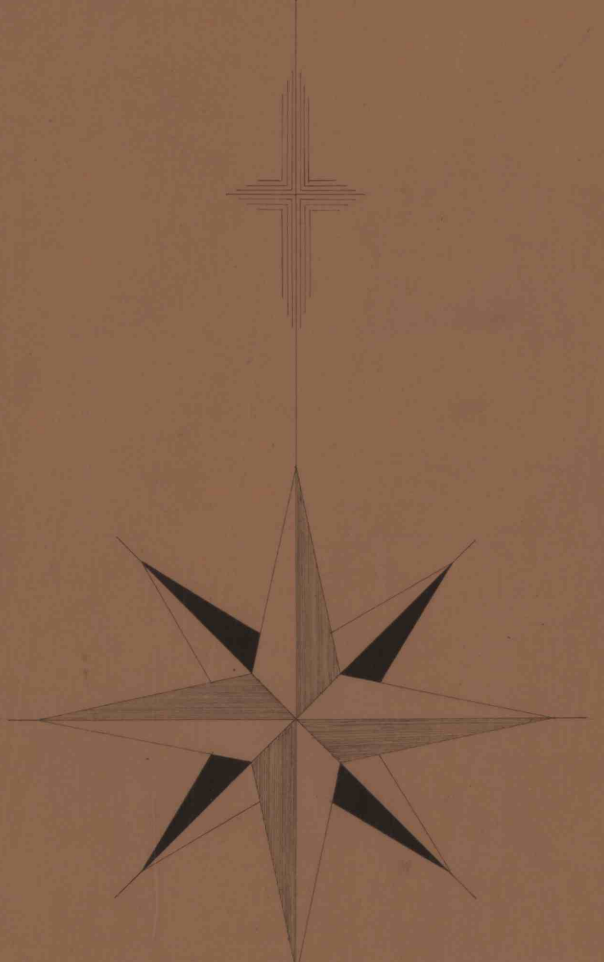

SOUTHERN FIELD
MAP
OF THE
SHORT MOUNTAIN COAL COMPANY'S
LANDS & MINES
AT
WICONISCO, DAUPHIN COUNTY, PA.

HENRY THOMAS C. & M.E.

1859

SURVEY OF MINES, JULY 21, 1859, BY PHILADELPHIA
ENGINEER J. M. JAMES, JUNE 10, 1859

Scale of Feet

JOHN BICKEL JR.
283° 116'

JOHN BICKEL SR.
283° 116'

JACOB MEASH
158° 106'

NORTH MINE

LINE OF

LINE OF

WORKED OUT

WORKED OUT

WORKED OUT

WORKED OUT

WORKED OUT

WORKED OUT

SOUTHERN
FIELD
SHORT MOUNTAIN
CO. LANDS & MINES
WICONISCO
DAUPHIN CO.