


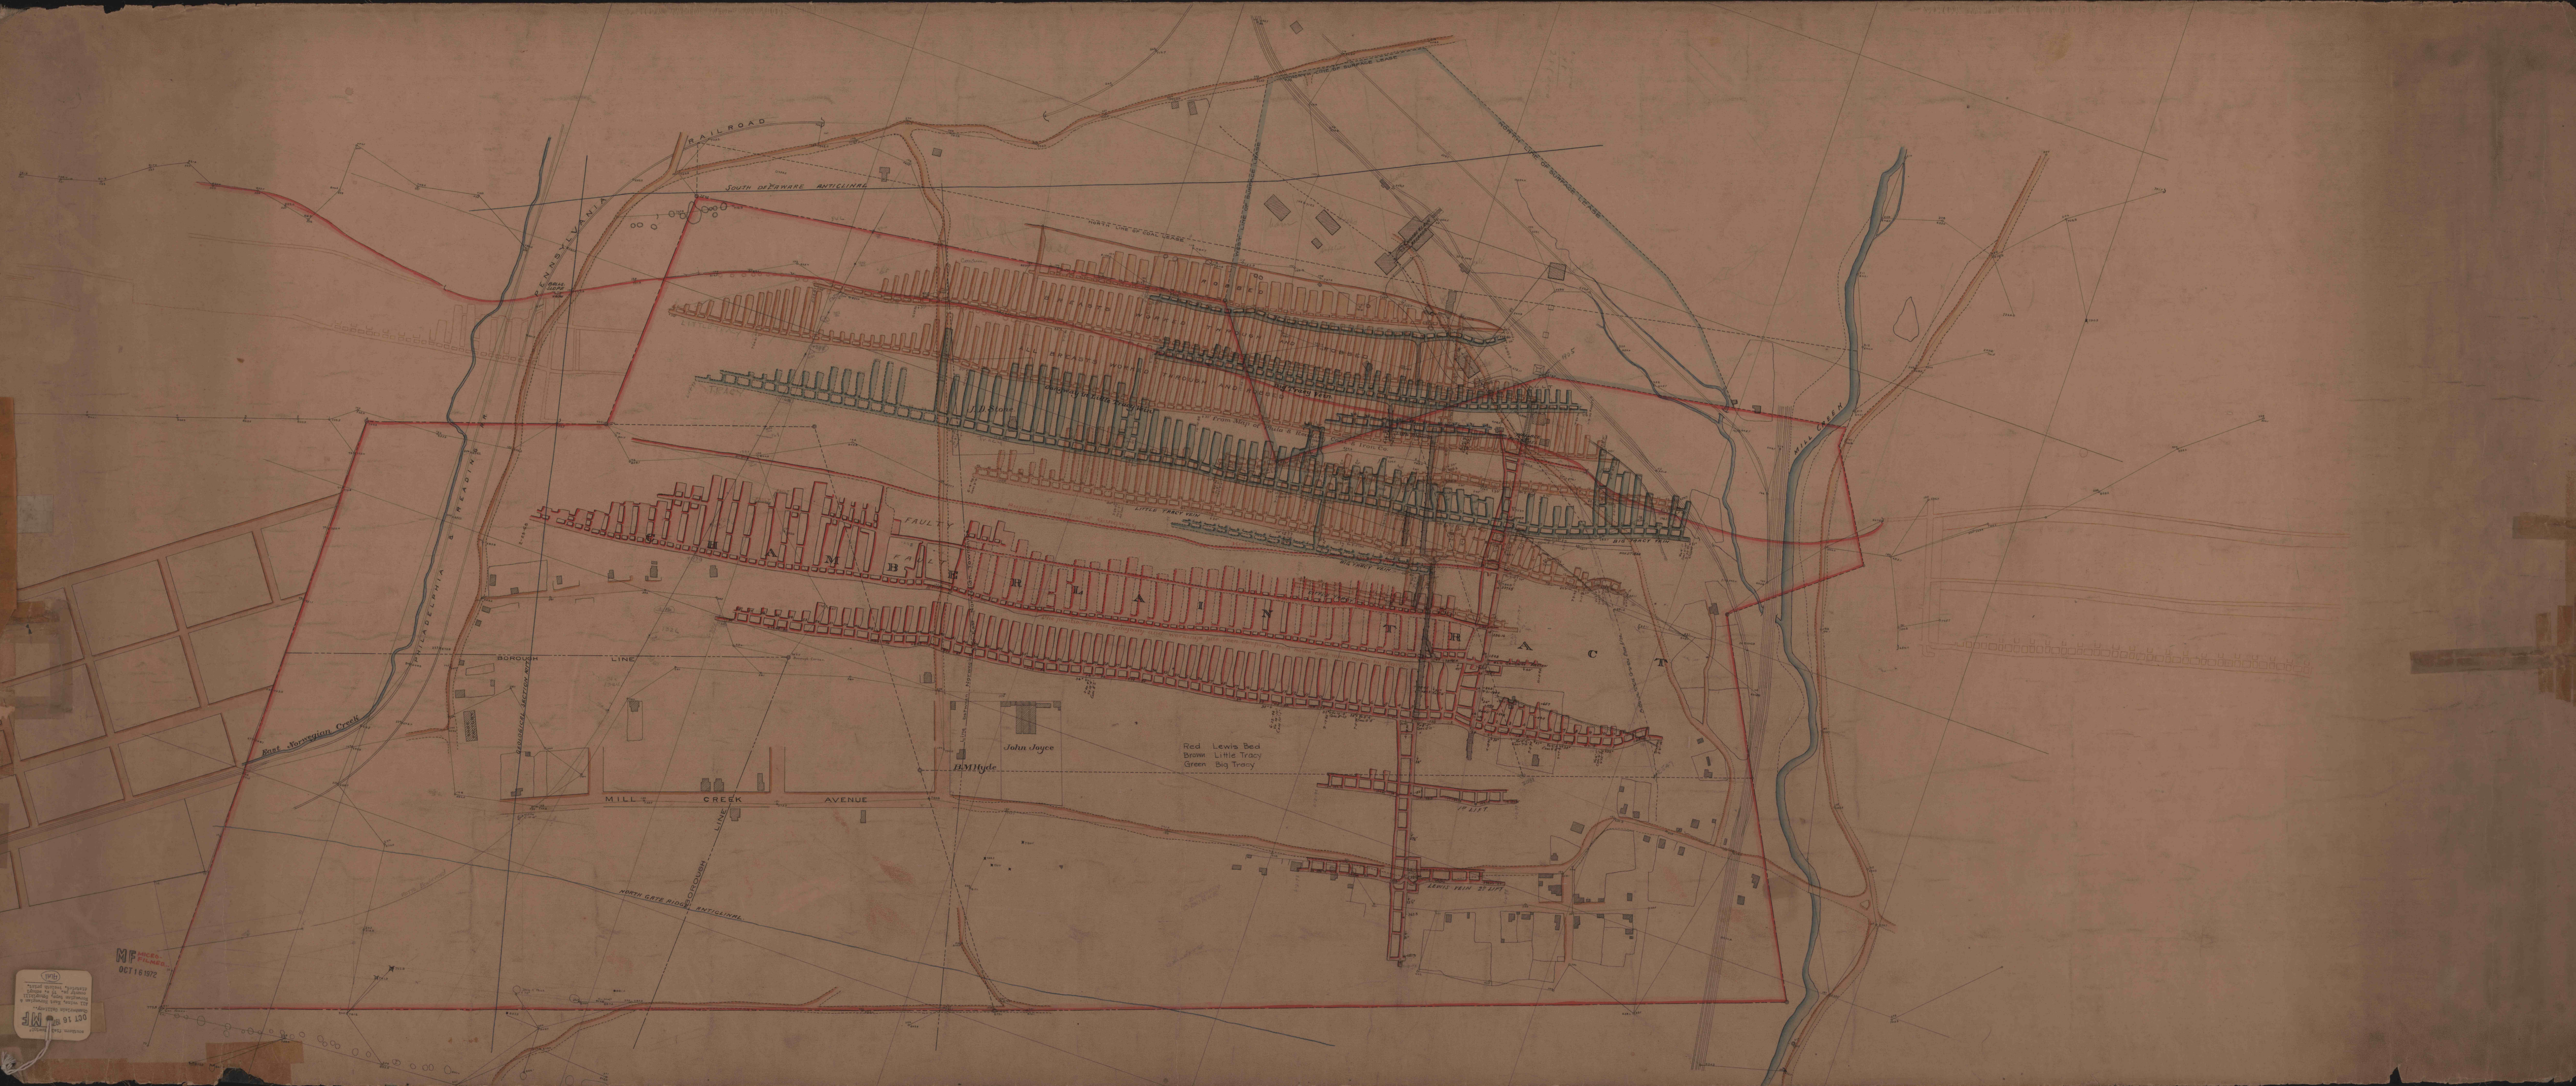

MF
OCT 16 1972
