


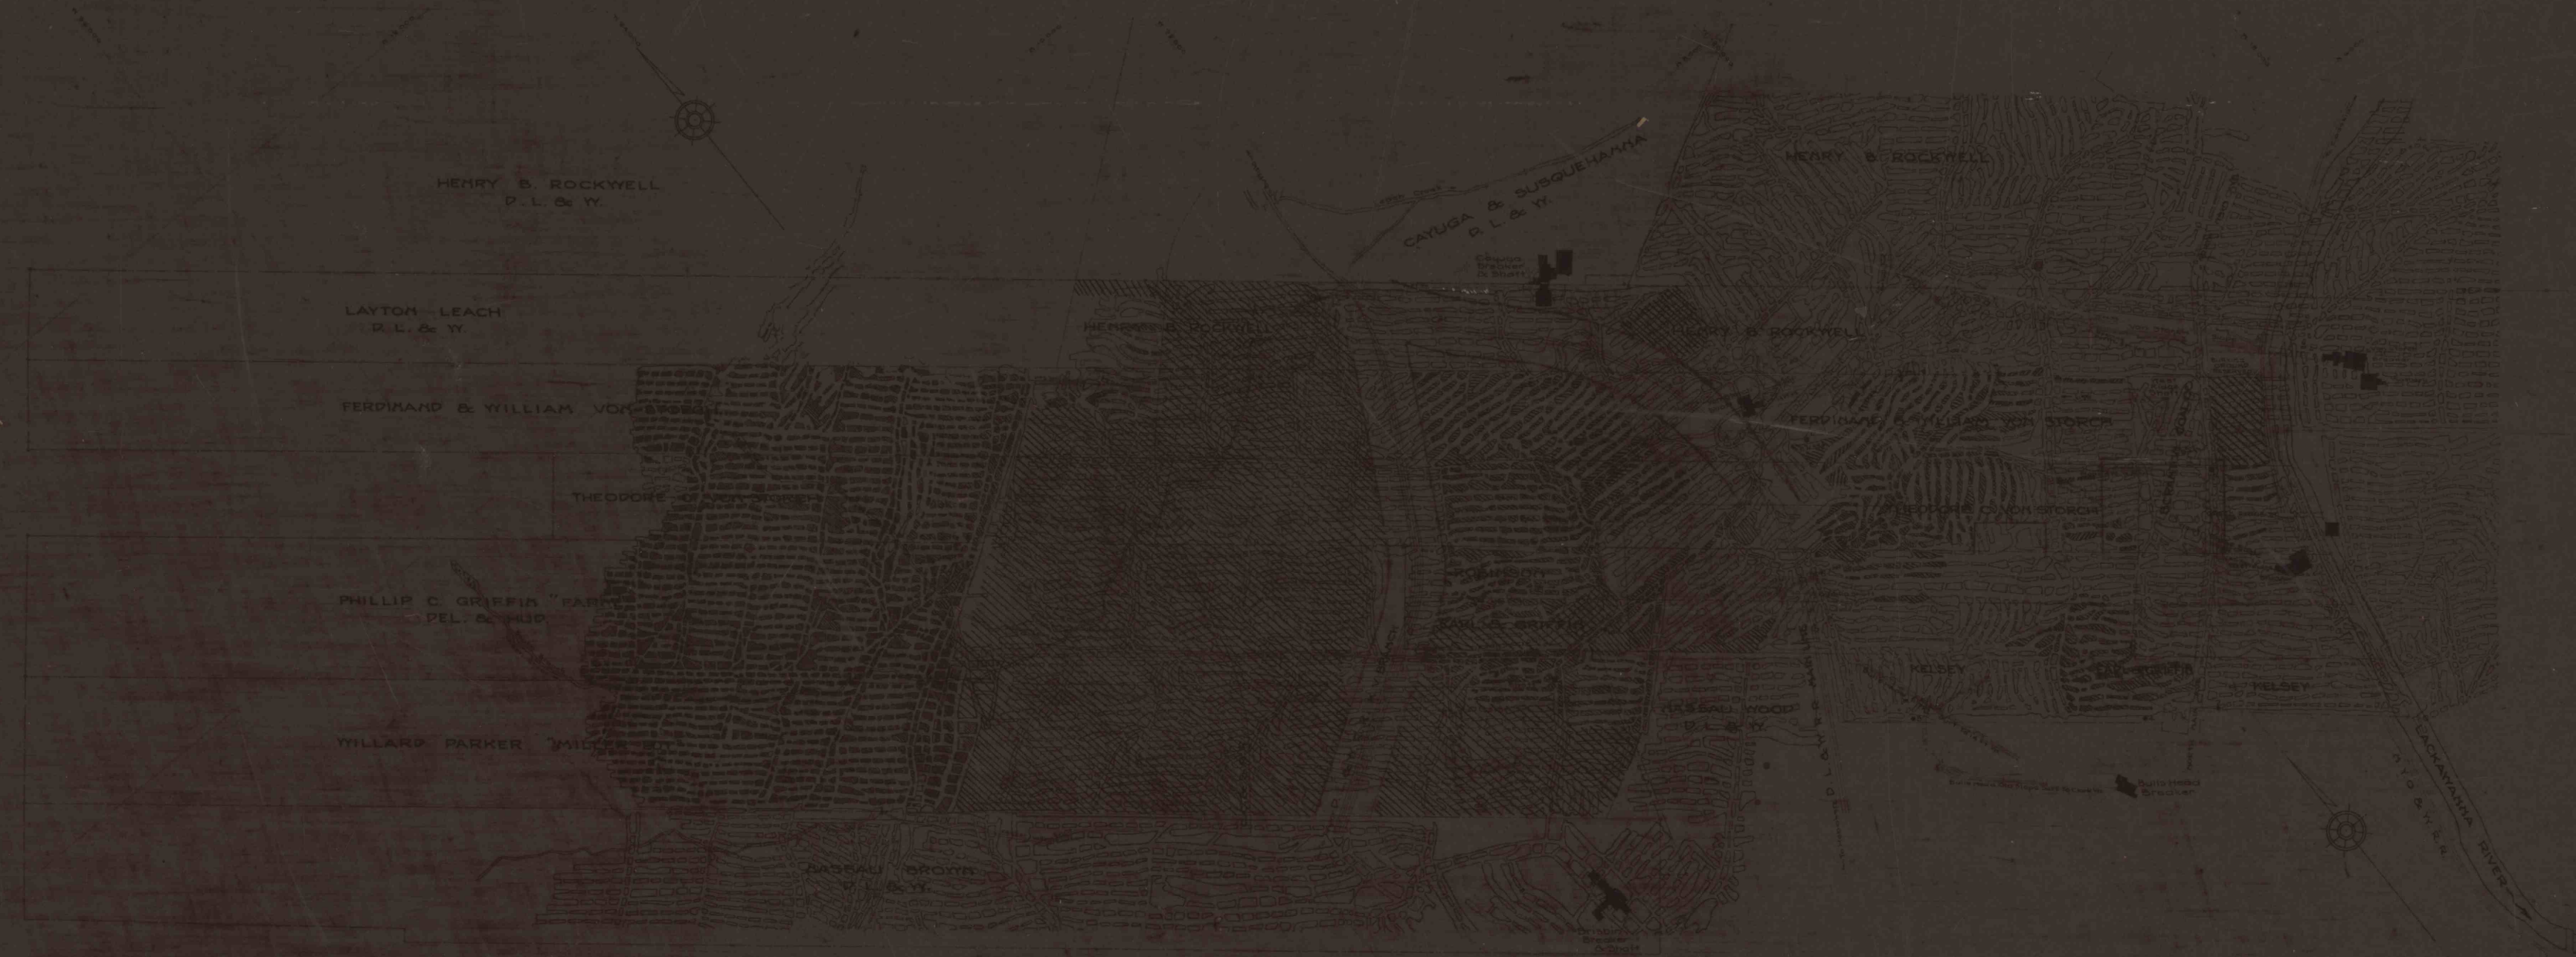

VON STORCH COLLIERY CO.
VON STORCH
CLARK
Office of Mining Engs. Scranton, Pa.
Scale 1"=400' Aug. 20, 1923.
Index 79

Photo 200V

Clark