


MINING ENGINEERING
SLEEN ALDEN COAL CO.
WILKES BARRE, PA.
JAMES W. SLEEN
1881-1968

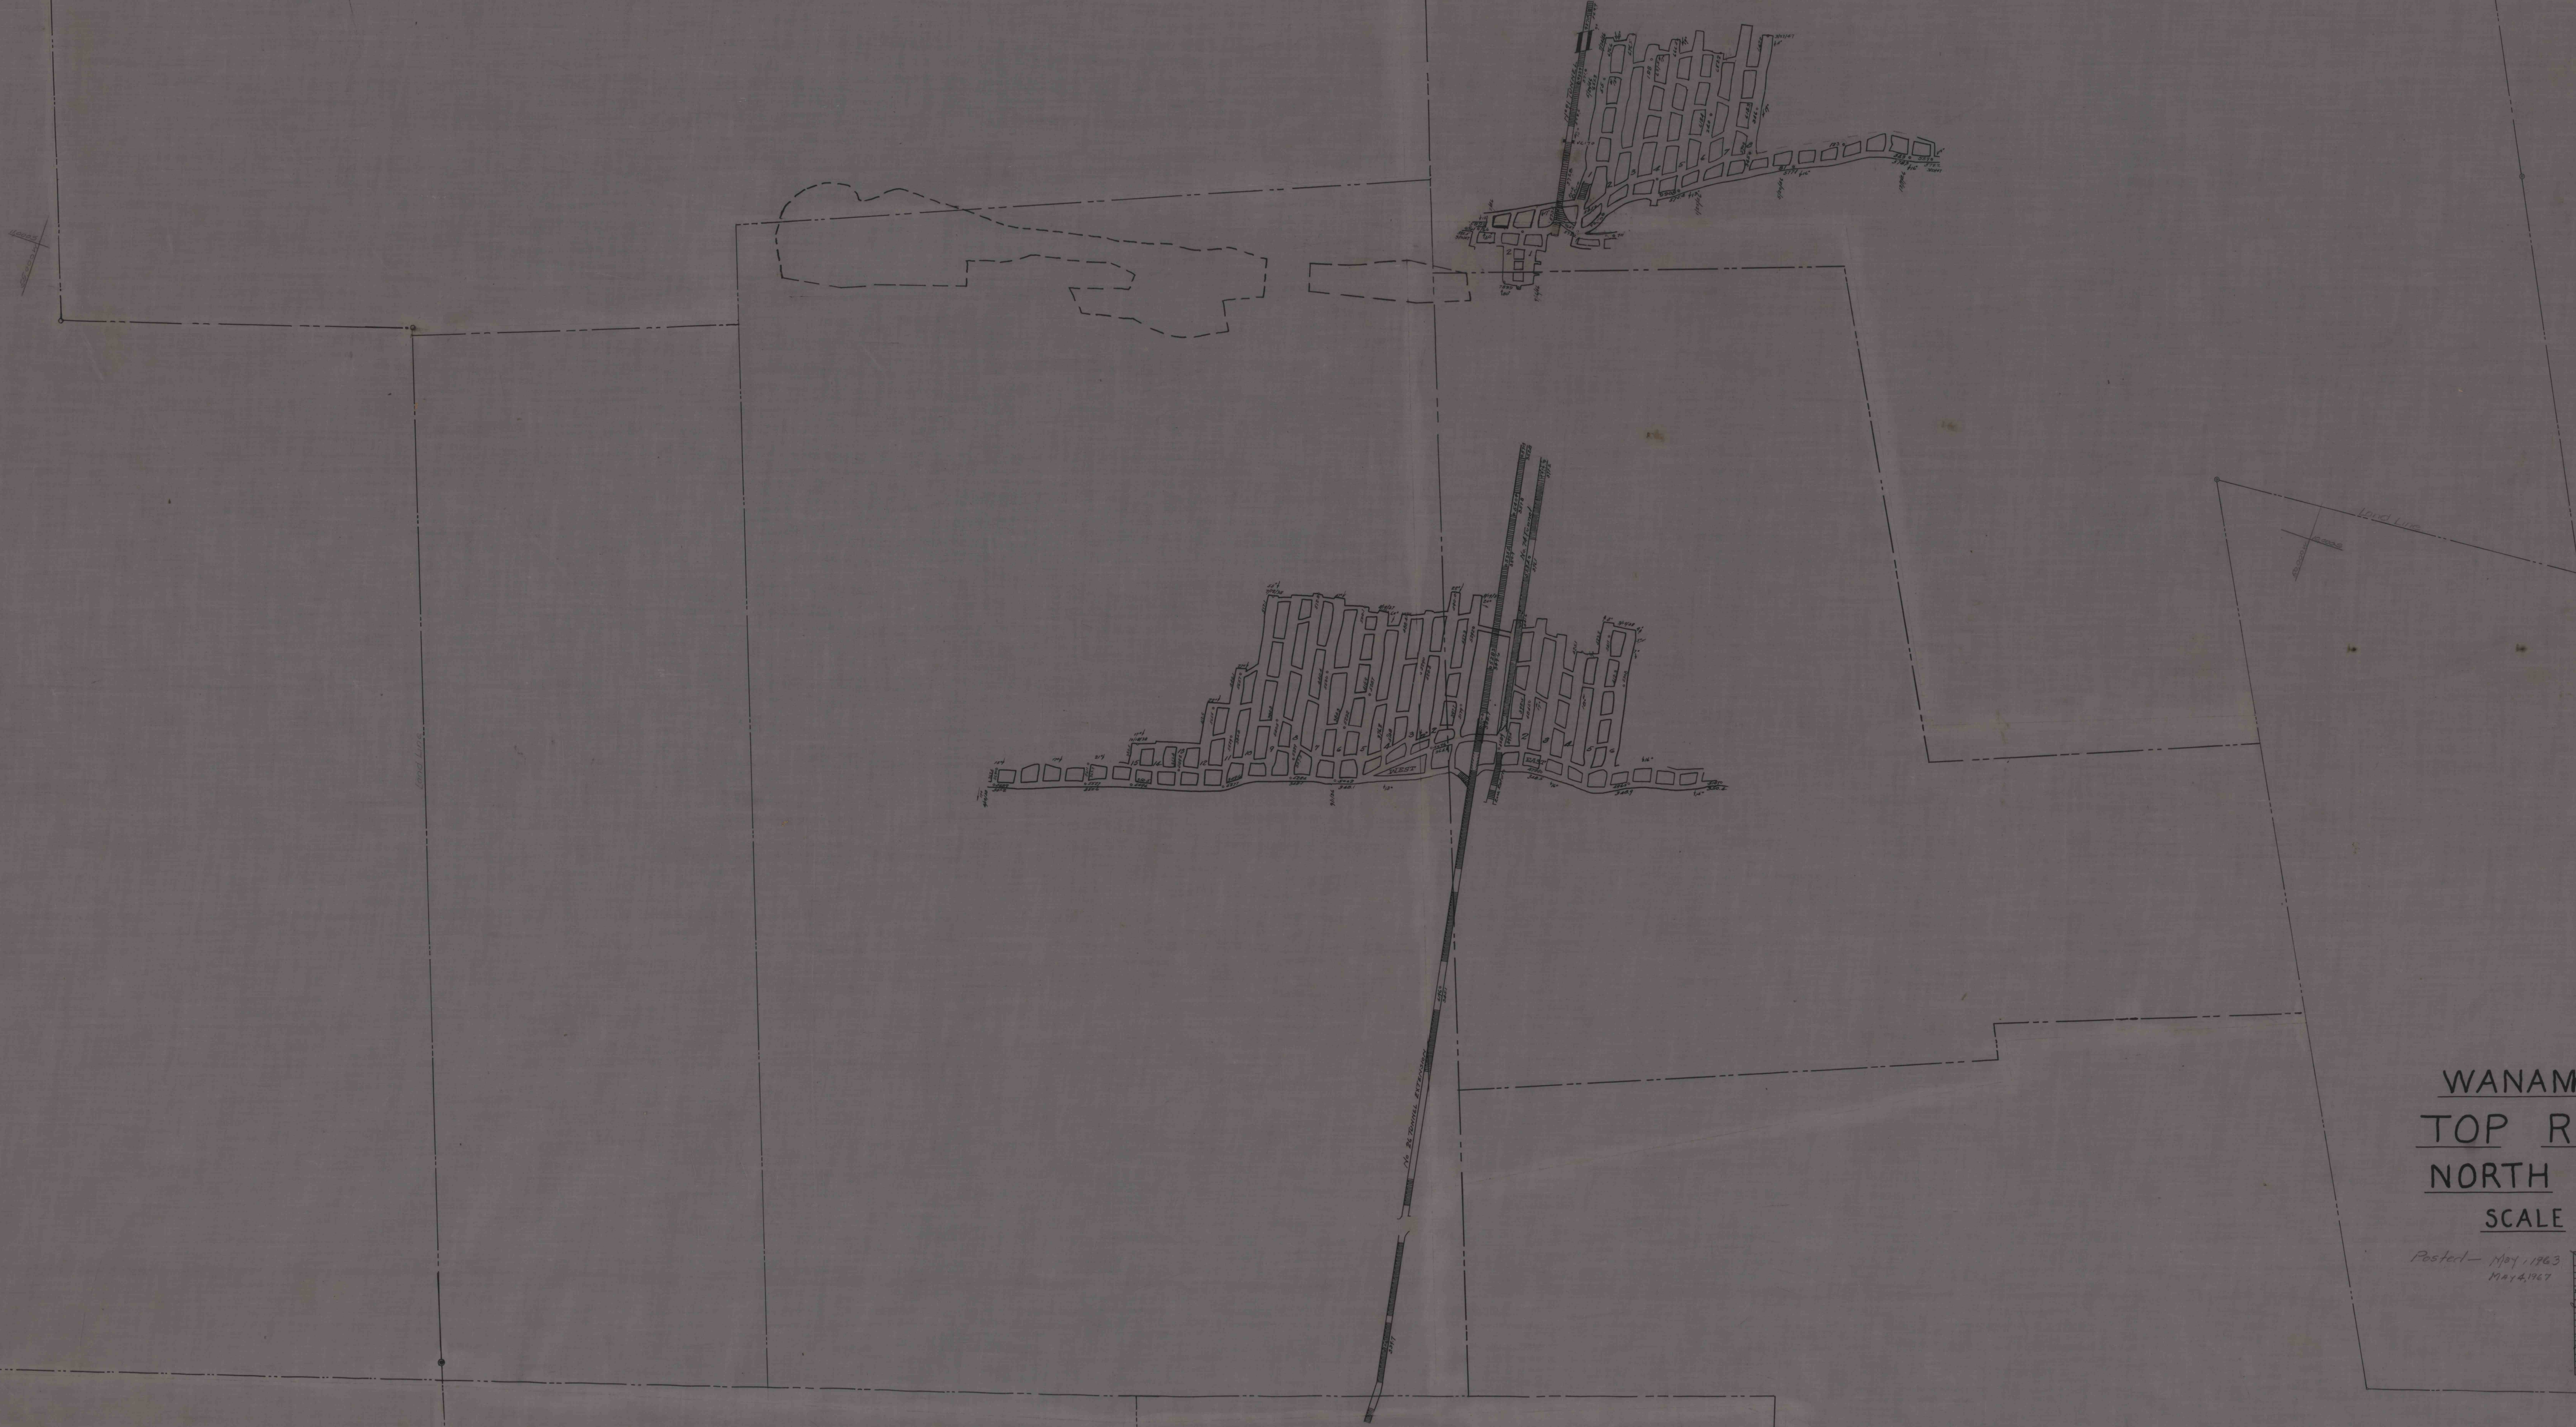

WANAMIE NO 19
TOP ROSS VEIN
NORTH SECTION
SCALE 1"=100'

Poster - May 1, 1963
May 6, 1967

DATE OF EXTENSION
1881
1882
MINING ENGINEERING
SLEEN ALDEN COAL CO.
WILKES BARRE, PA.
JAMES W. SLEEN
1881-1968