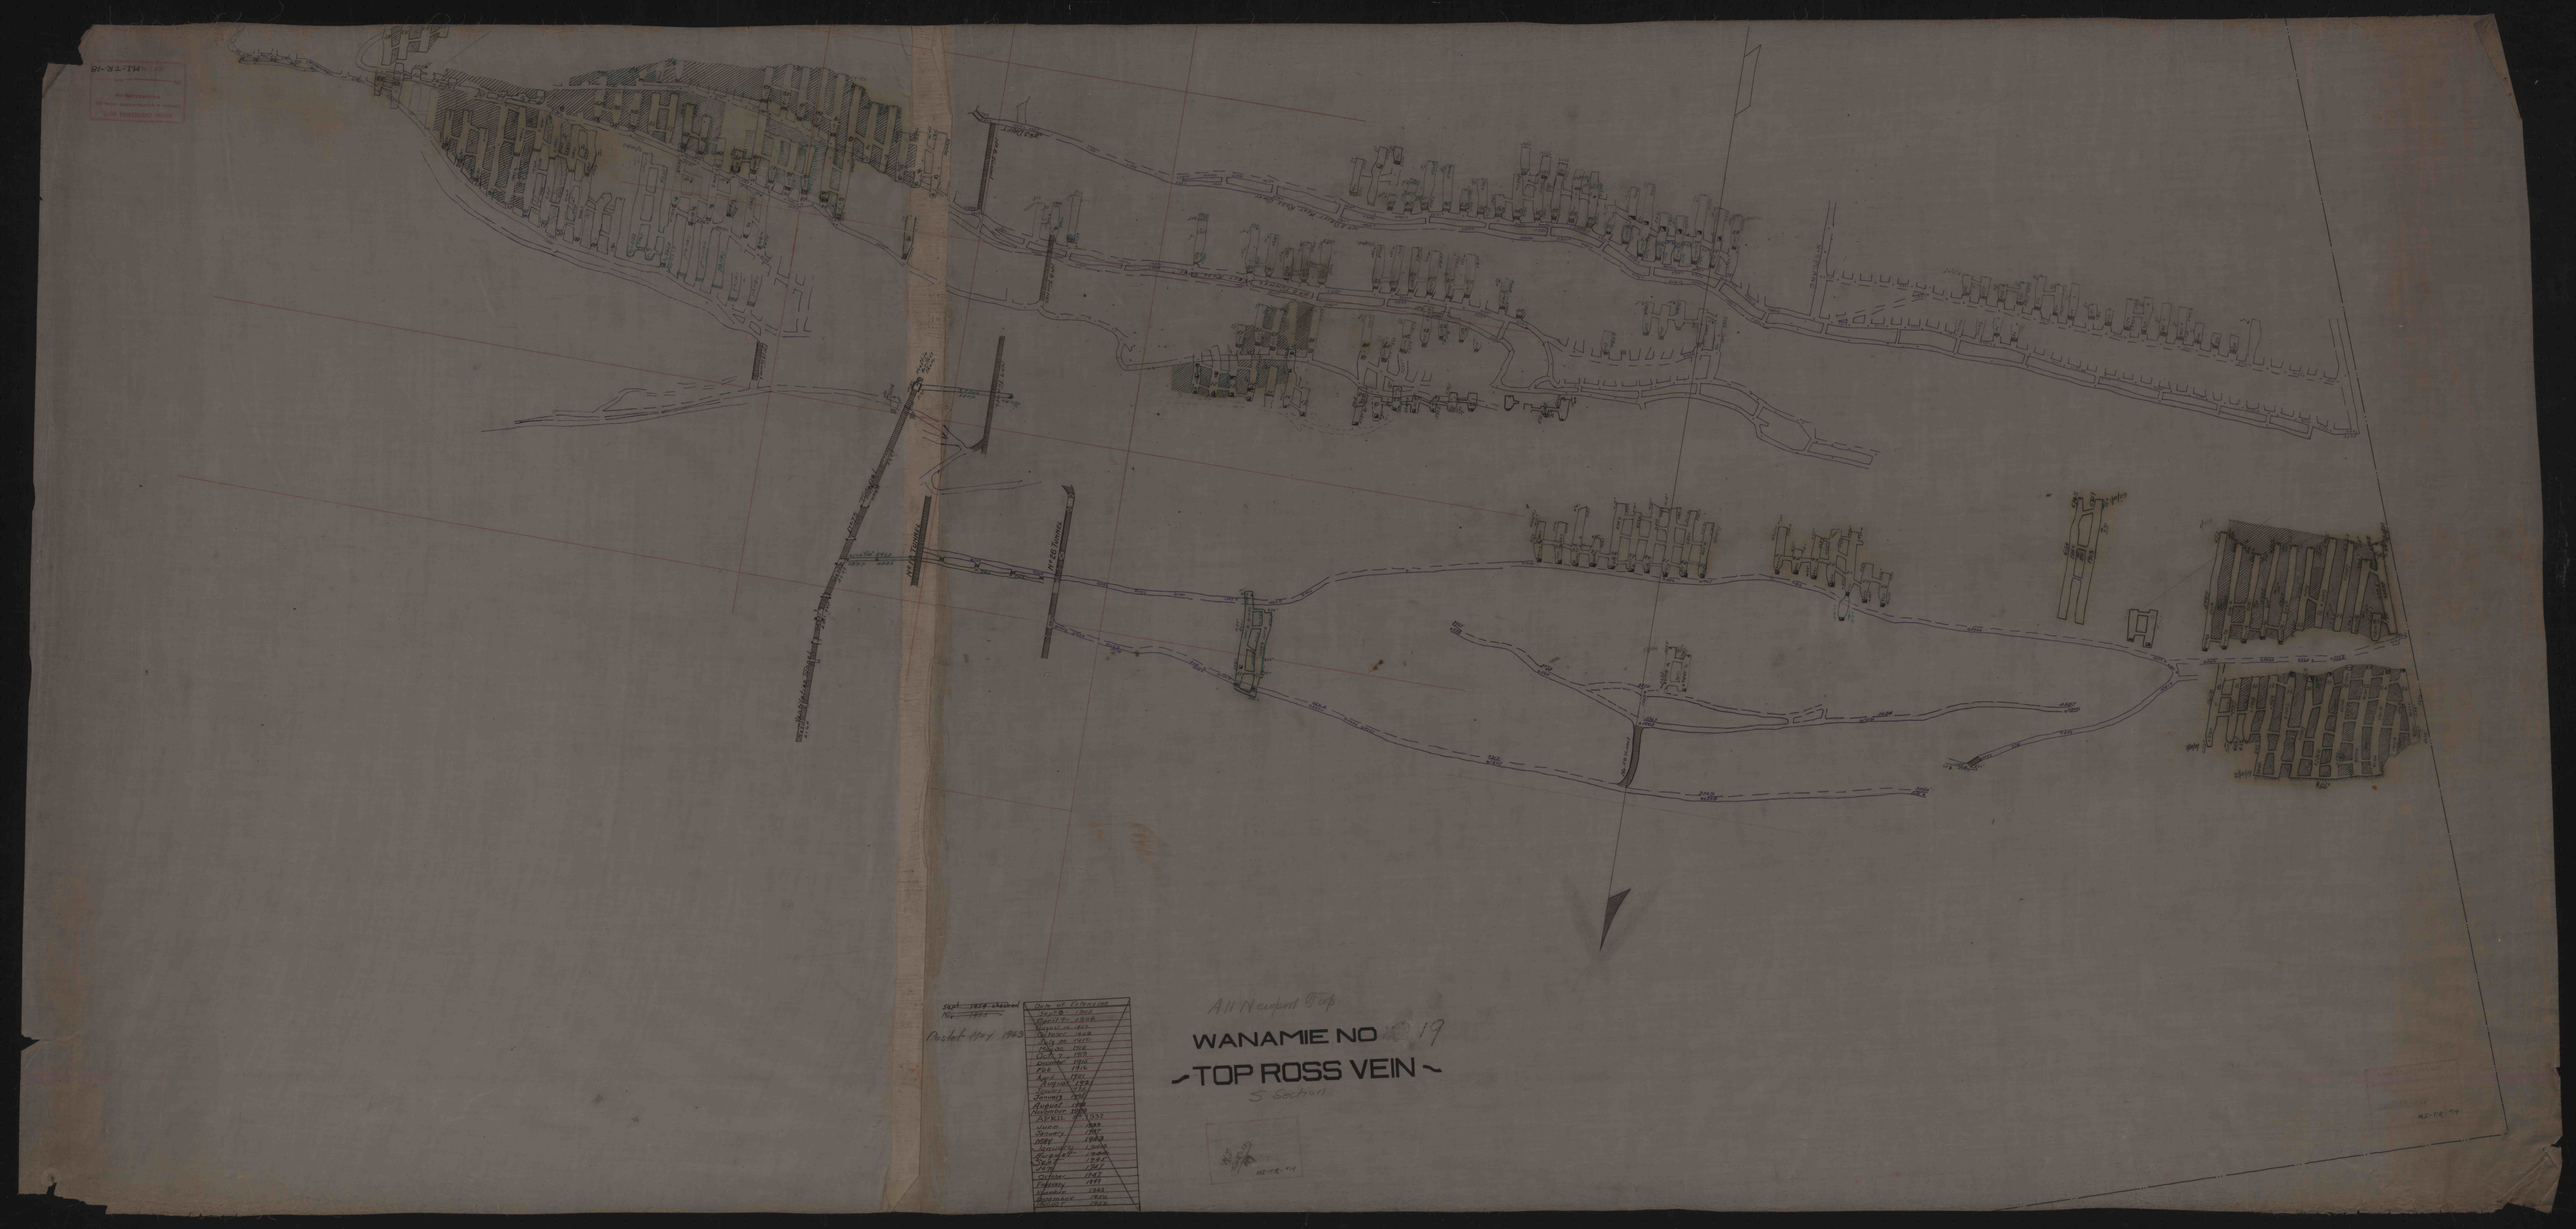
Sept 1914 revised
No. 1917
Posted Nov 1943
Date of Extraction
Sept 8 1908
April 8 1908
August 1913
October 1913
Dec 30 1913
Oct 7 1913
March 1914
Feb 1914
Jan 1914
August 1914
June 1914
January 1915
August 1916
October 1916
APRIL 1932
June 1933
January 1937
1939
June 1940
August 1940
Sept 1941
Oct 1941
October 1942
February 1943
March 1943
September 1943
October 1943
All Newport Grp
WANAMIE NO 19
TOP ROSS VEIN
5 Section