


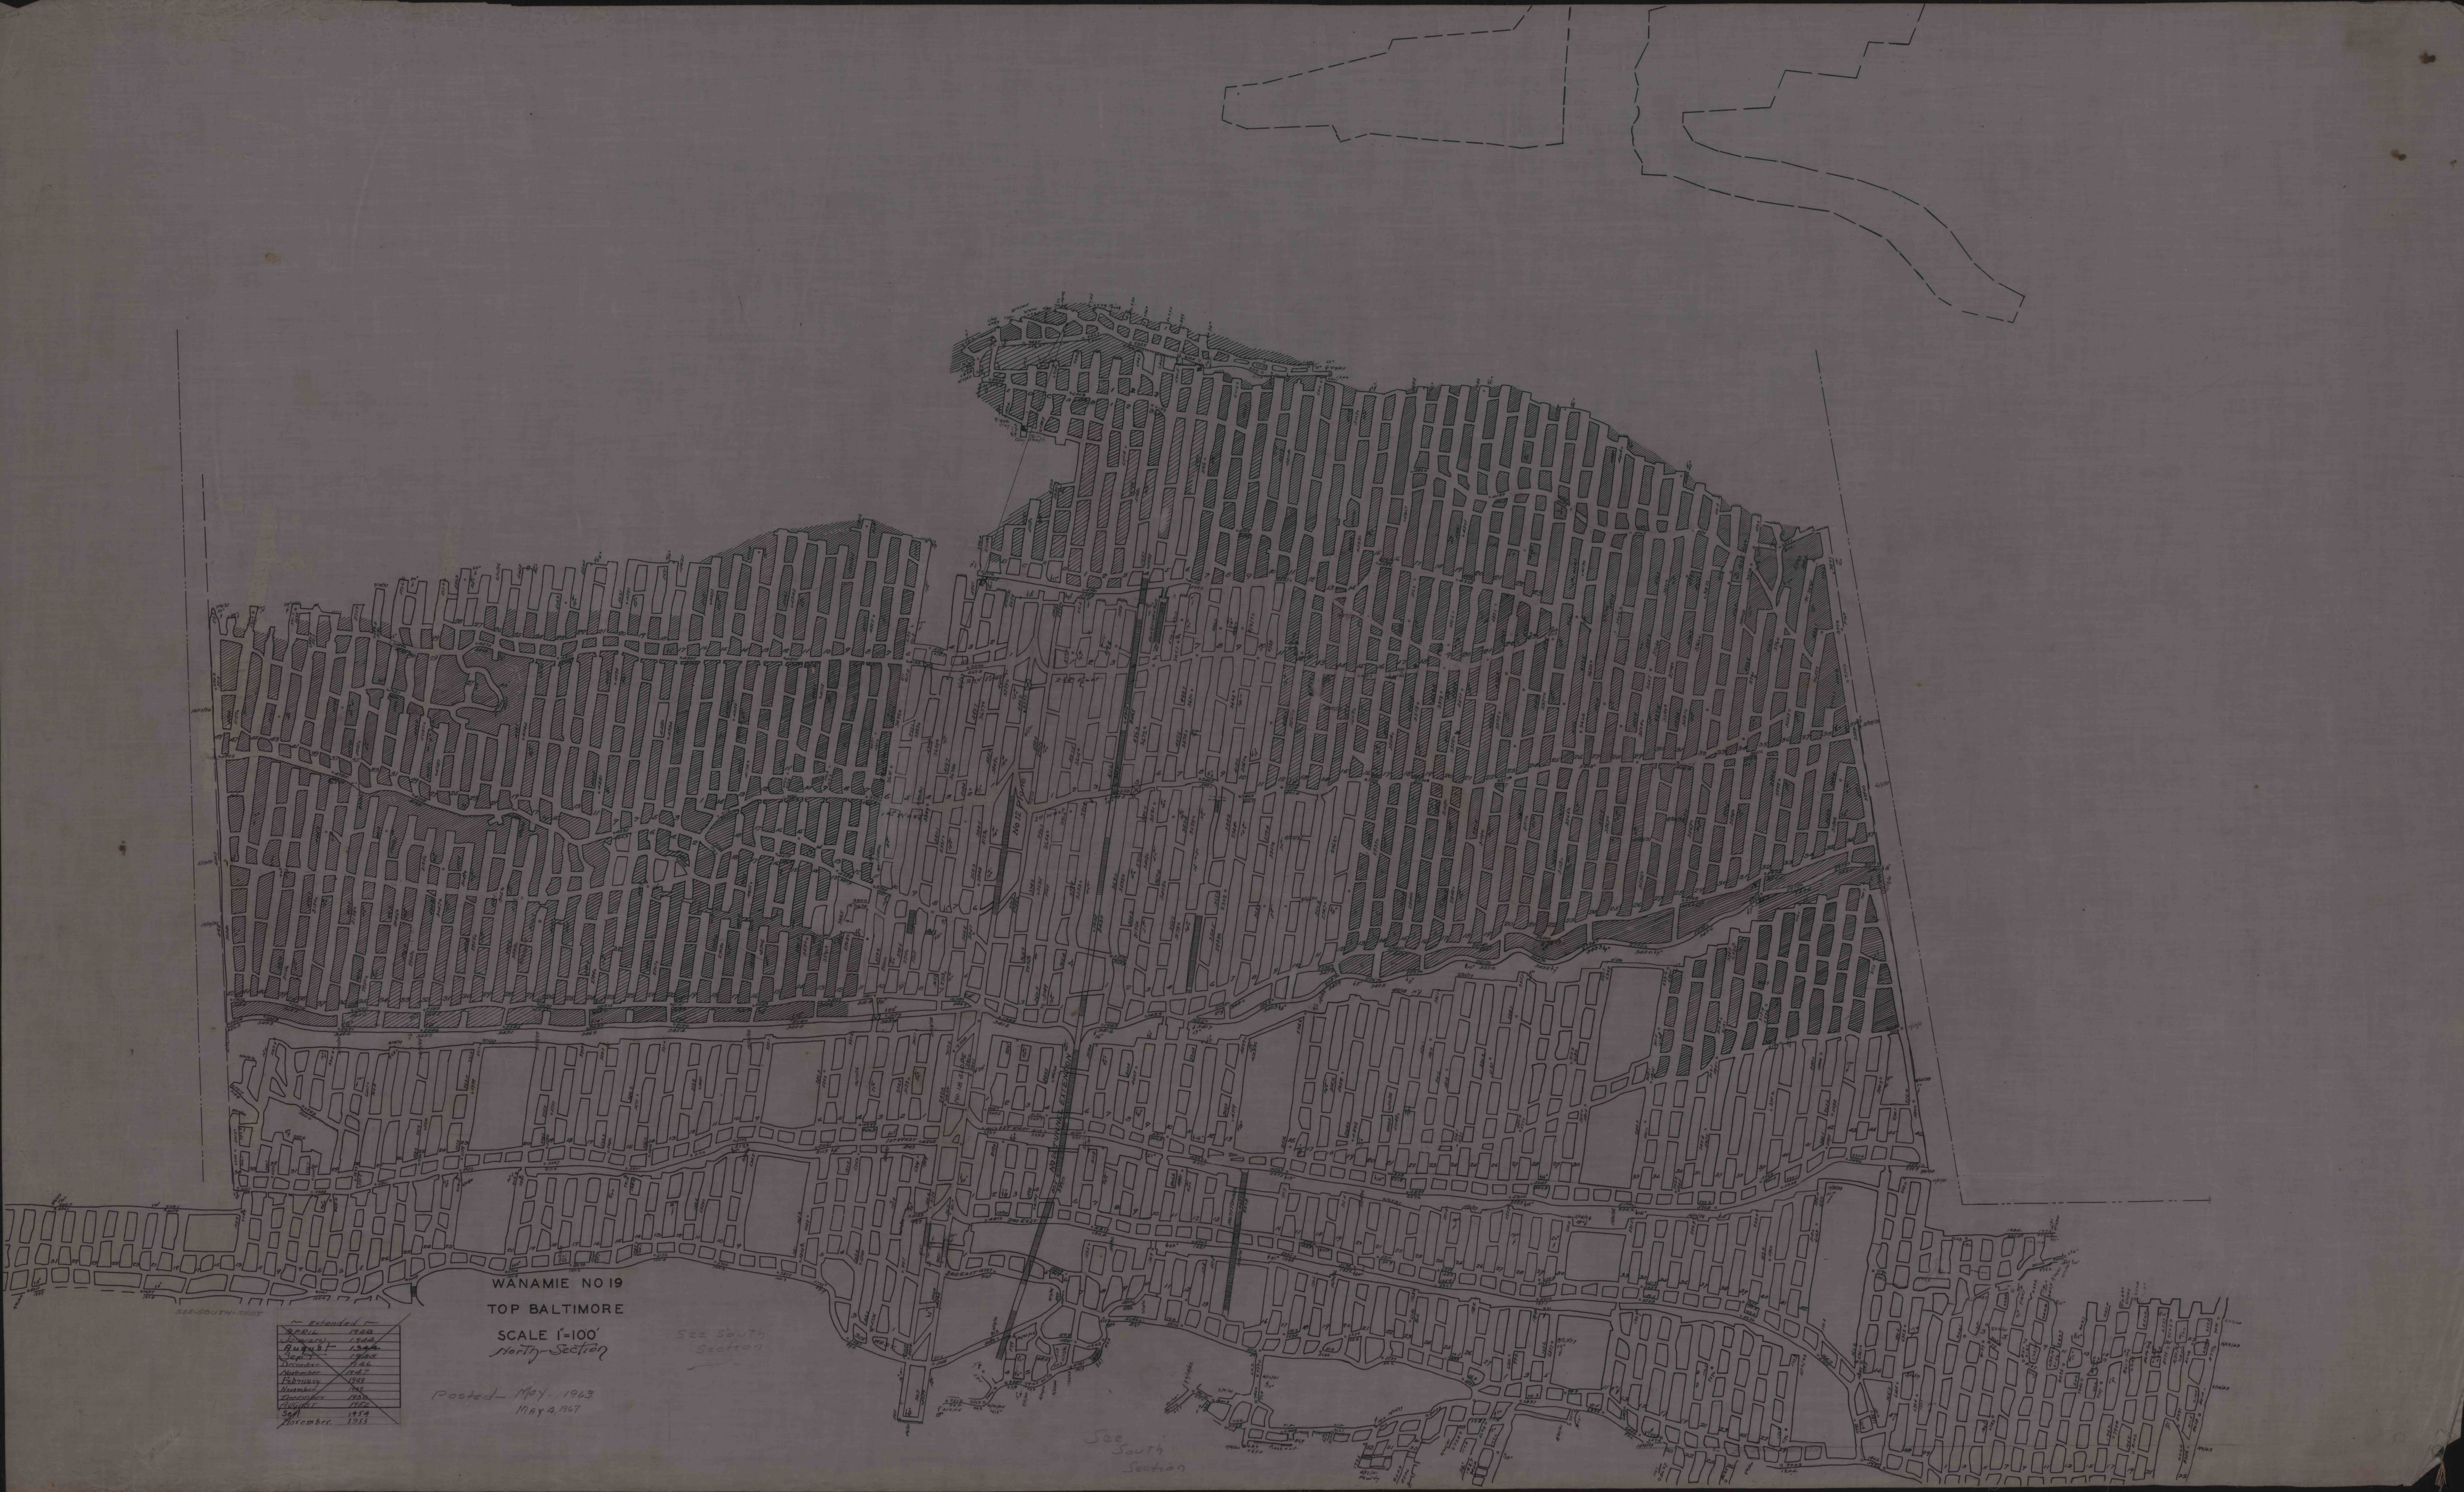

WANAMIE NO 19
TOP BALTIMORE

SCALE 1"=100'
North Section

See South
Section

Extended	1963
March	1963
April	1963
May	1963
June	1963
July	1963
August	1963
September	1963
October	1963
November	1963
December	1963
January	1964
February	1964
March	1964
April	1964
May	1964
June	1964
July	1964
August	1964
September	1964
October	1964
November	1964
December	1964

Posted May 1963
MAY 2, 1967

See South
Section