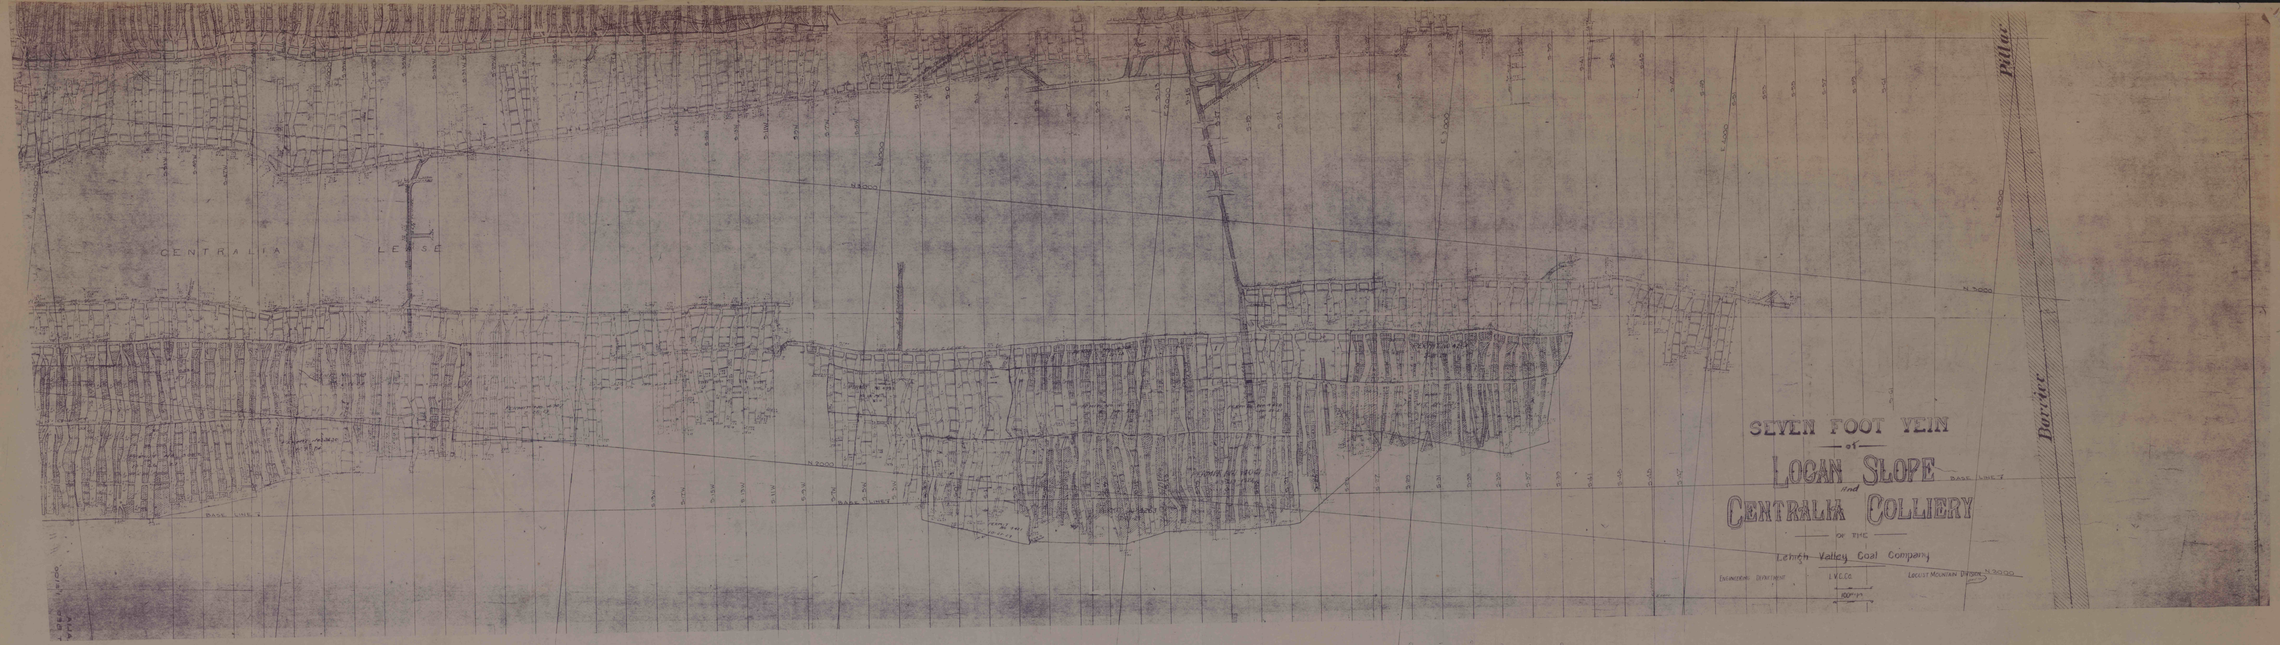
CENTRALIA LEASE
SEVEN FOOT VEIN
of
LOGAN SLOPE
and
CENTRALIA COLLIERY
of the
Lehigh Valley Coal Company
Pillar
Barrier