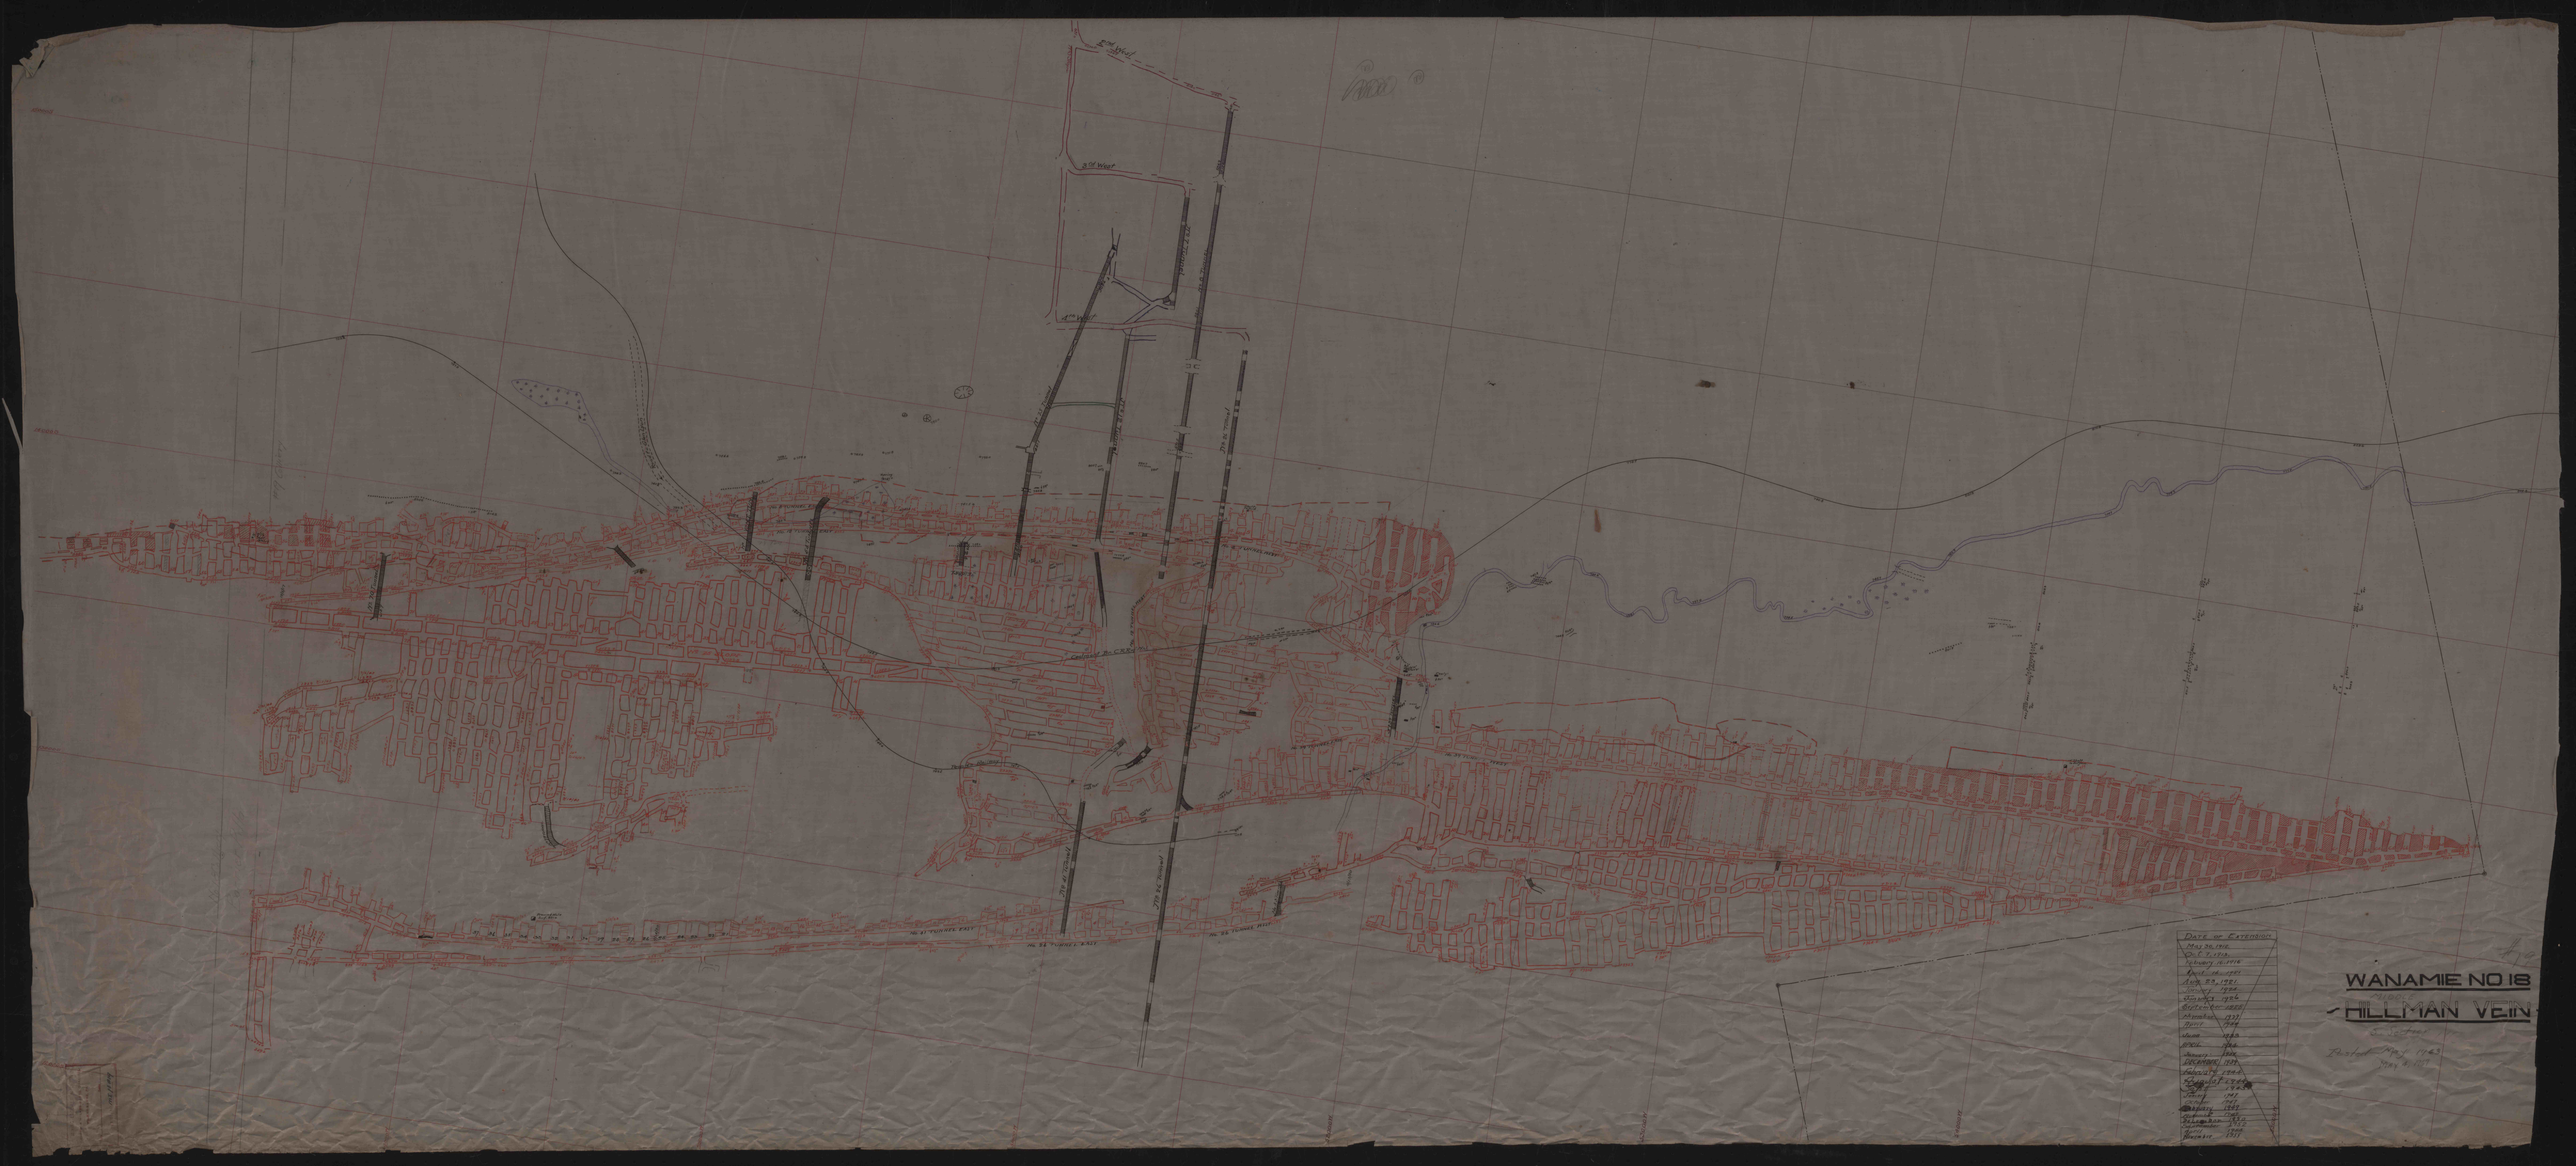
WANAMIE NO 18
HILLMAN VEIN
DATE OF EXTENSION
MAY 26, 1916
OCT 7, 1916
JANUARY 16, 1918
APRIL 15, 1921
NOV 23, 1921
JULY 1924
DEC 1924
OCTOBER 1925
MARCH 1931
JULY 1934
JUNE 1936
DEC 1936
JANUARY 1937
DECEMBER 1939
FEBRUARY 1944
AUGUST 1945
JULY 1947
JULY 1951
JANUARY 1952
JUNE 1952
DECEMBER 1952
