


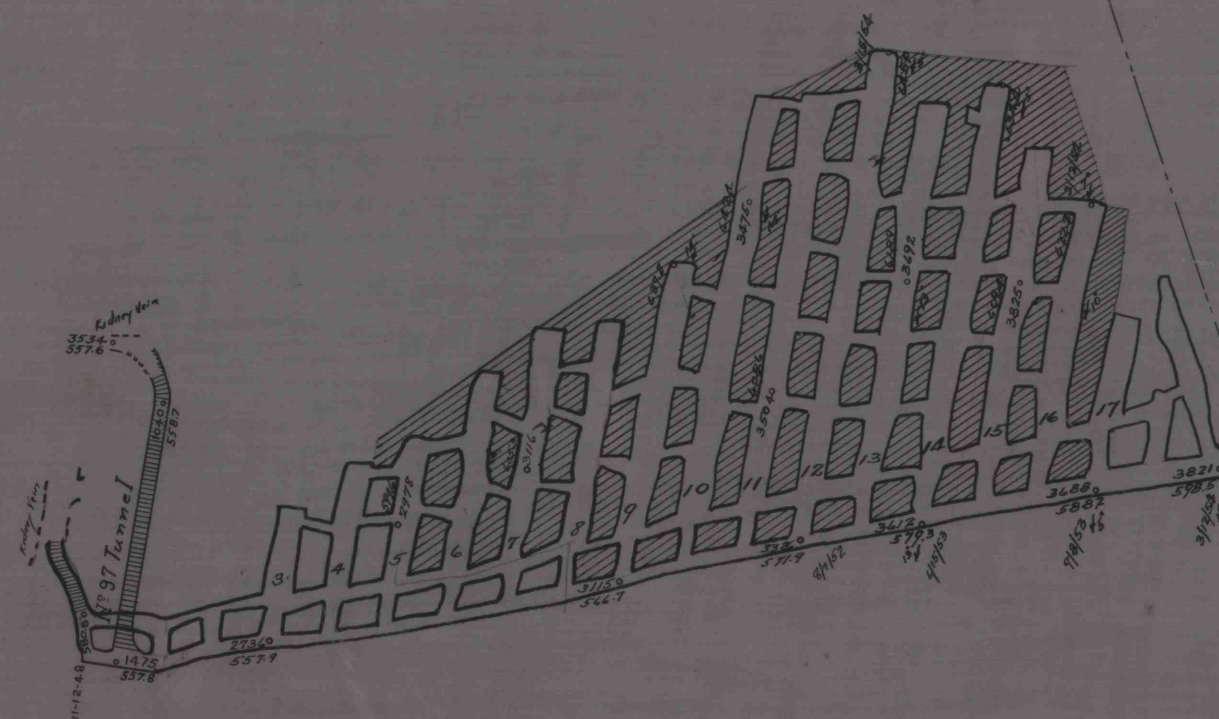

WANAMIE No. 19 COLLIERY
ABBOTT VEIN
SCALE - 1" = 100'

DATE EXTENDED	
New Freedom	Feb. 1949
November	1948
December	1950
September	1952
April	1953
November	1955
MAY 1963	
MAY 4, 1967	