


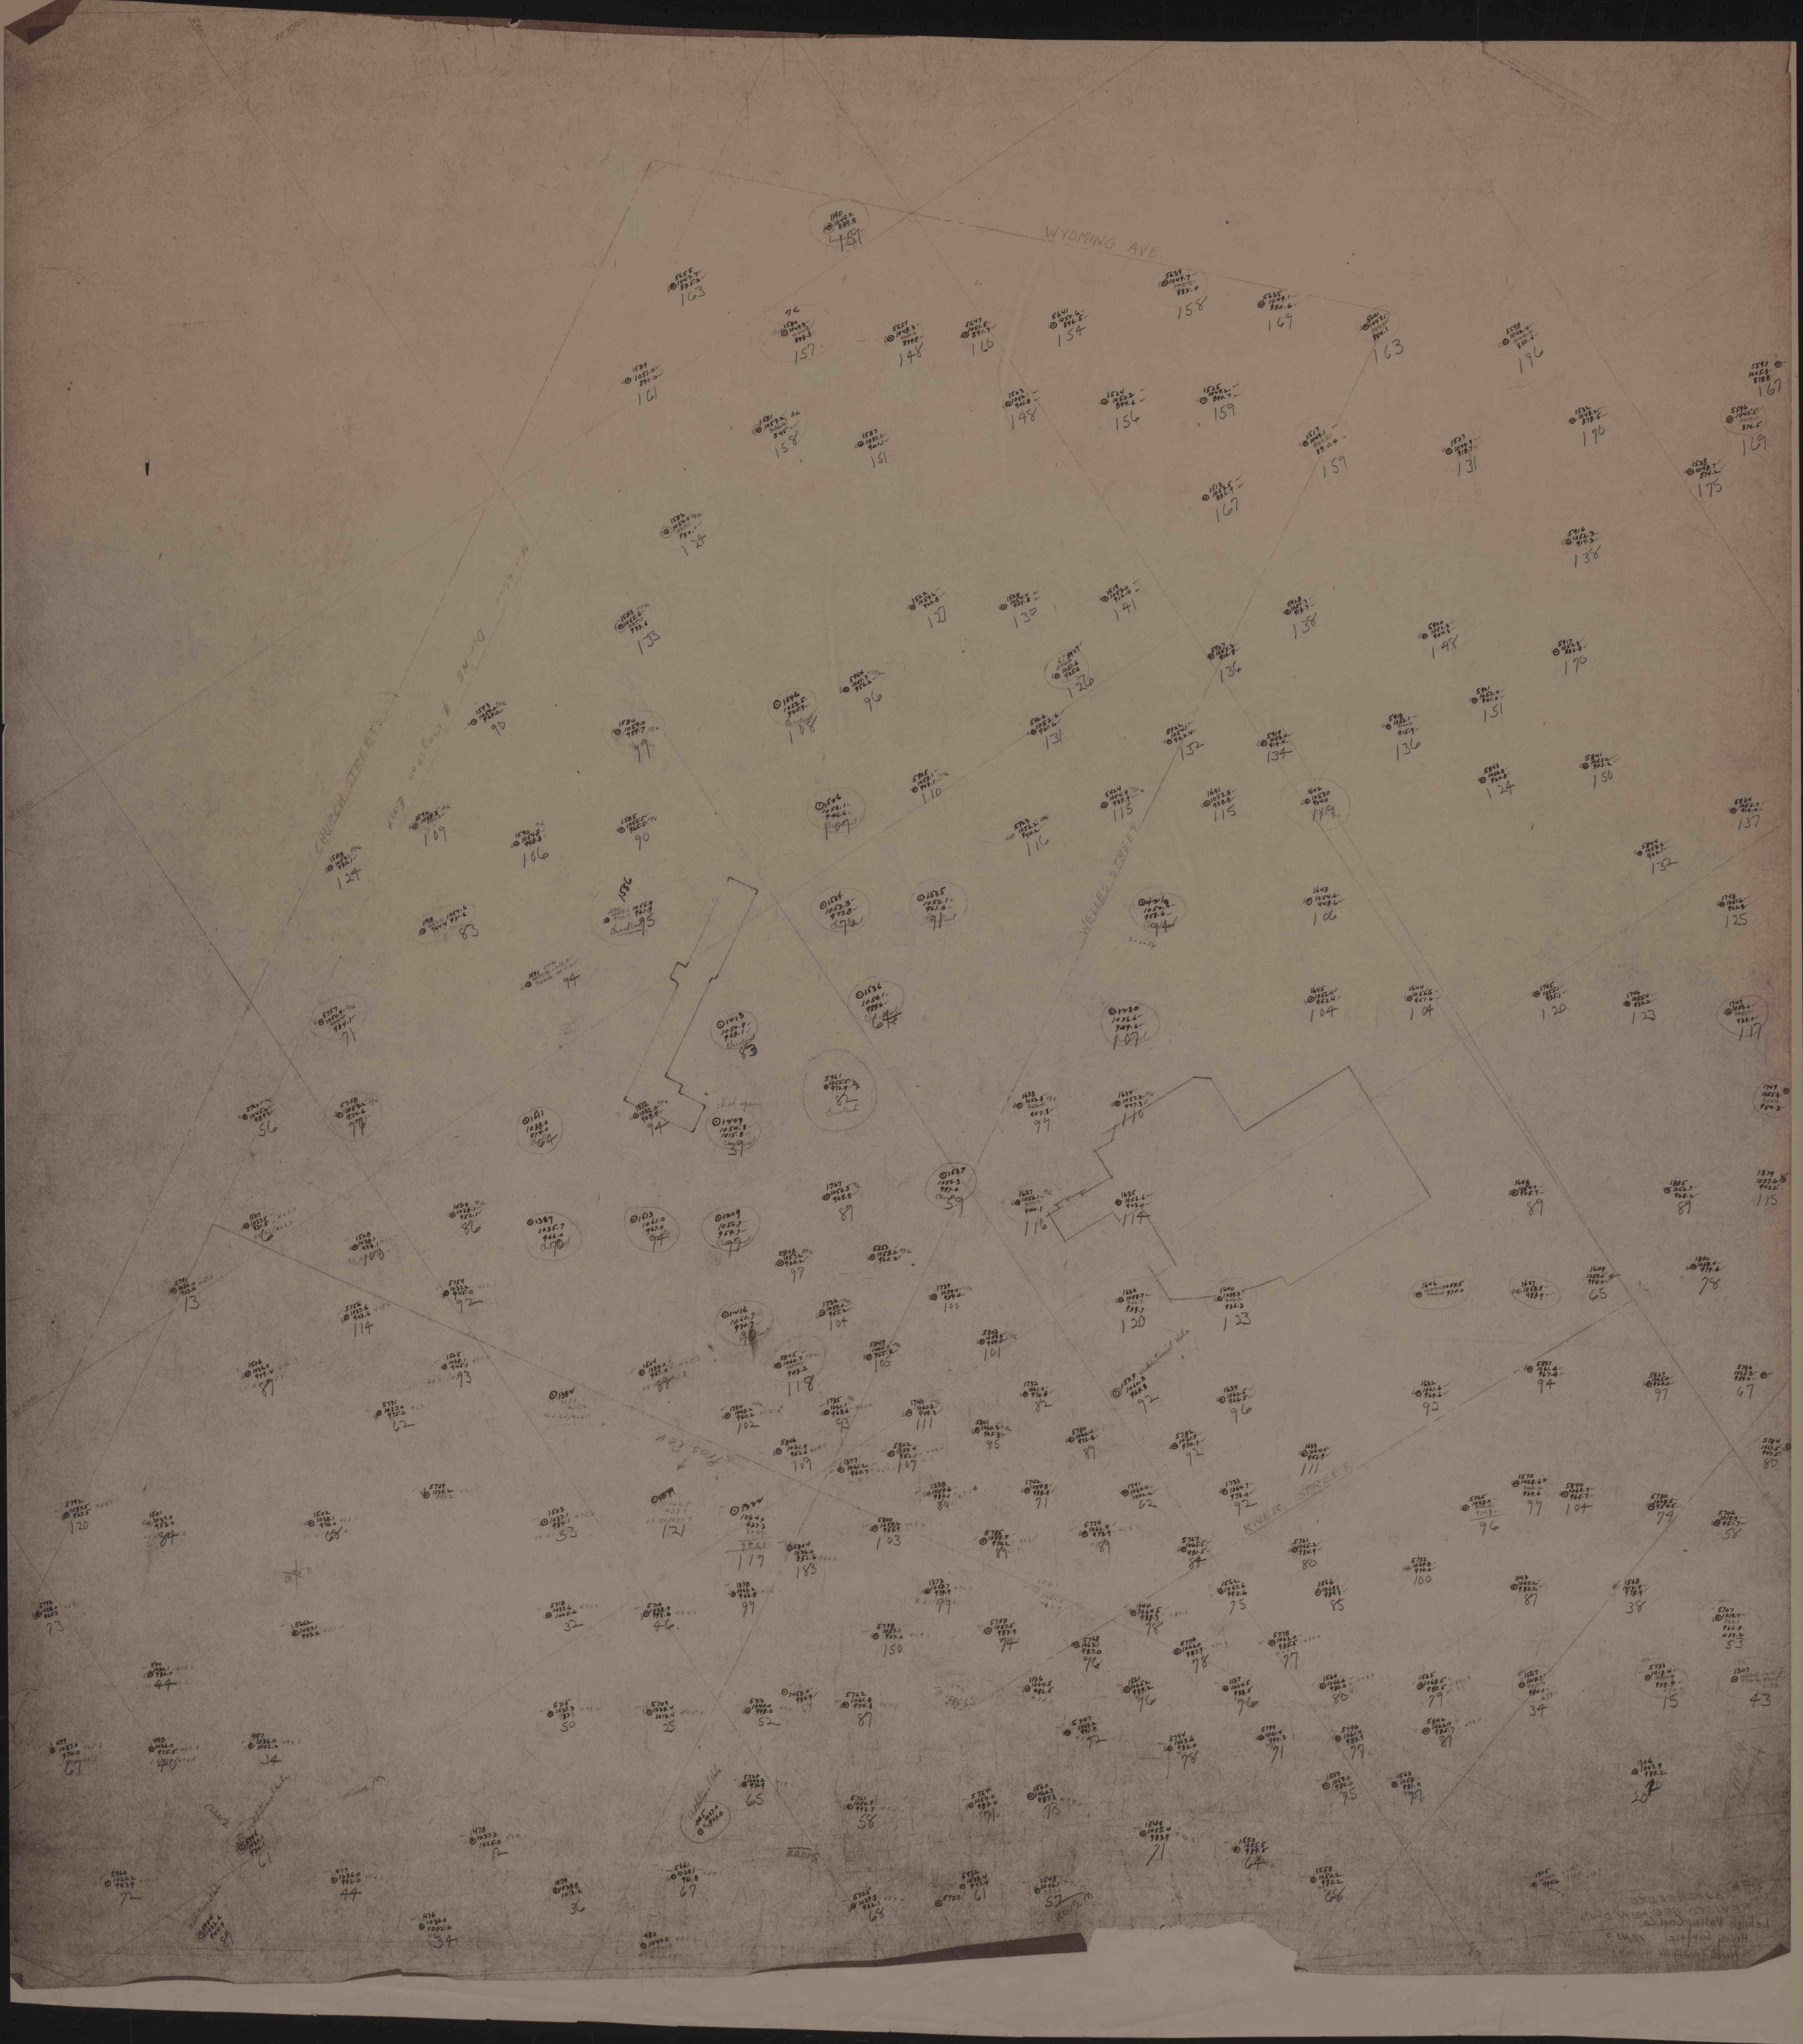

WYOMING AVE.

CHURCH STREET

WELLS STREET

RIVER STREET

