


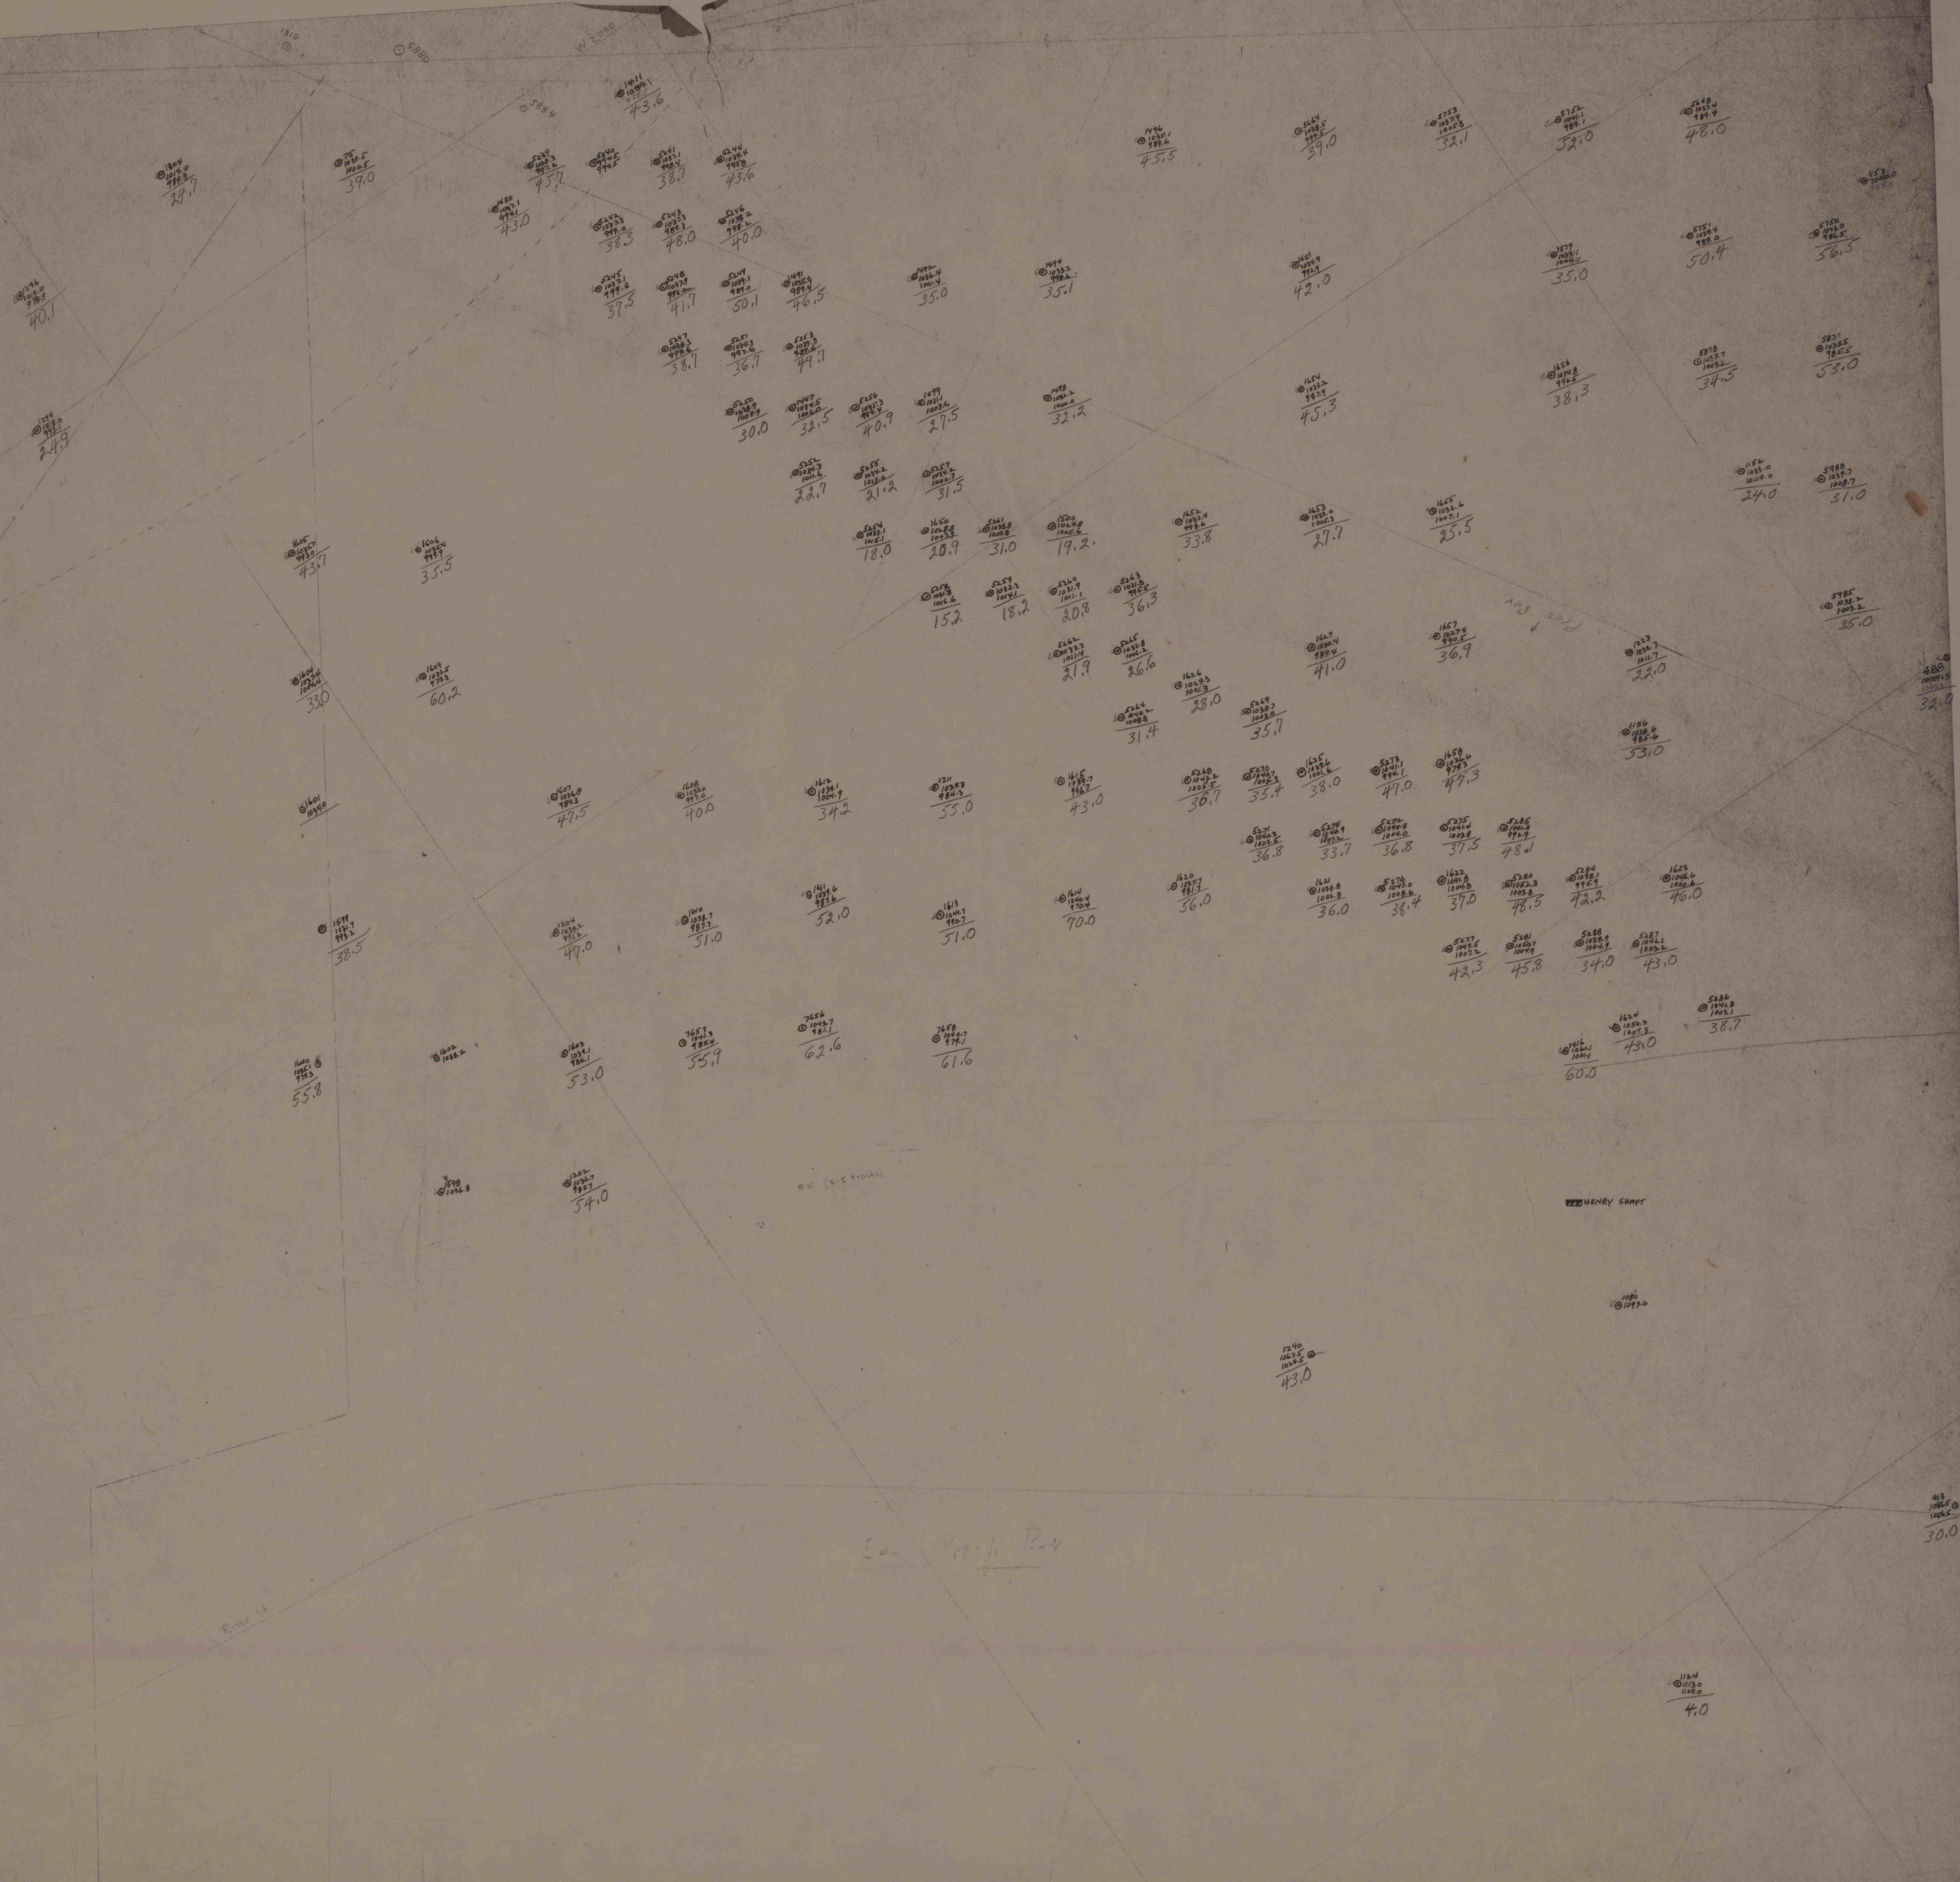

River


HENRY SHARP

4.0

30.0

43.0

61.6

62.6

55.7

53.0

55.8

55.8

60.0

38.7

40.0

42.2

48.5

37.0

36.8

33.7

36.0

36.0

70.0

51.0

51.0

52.0

34.2

40.0

47.5

47.0

47.0

60.2

33.0

43.7

24.9

40.1

24.7

39.0

43.6

43.6

43.6

43.6
















