


49D

20D

80D

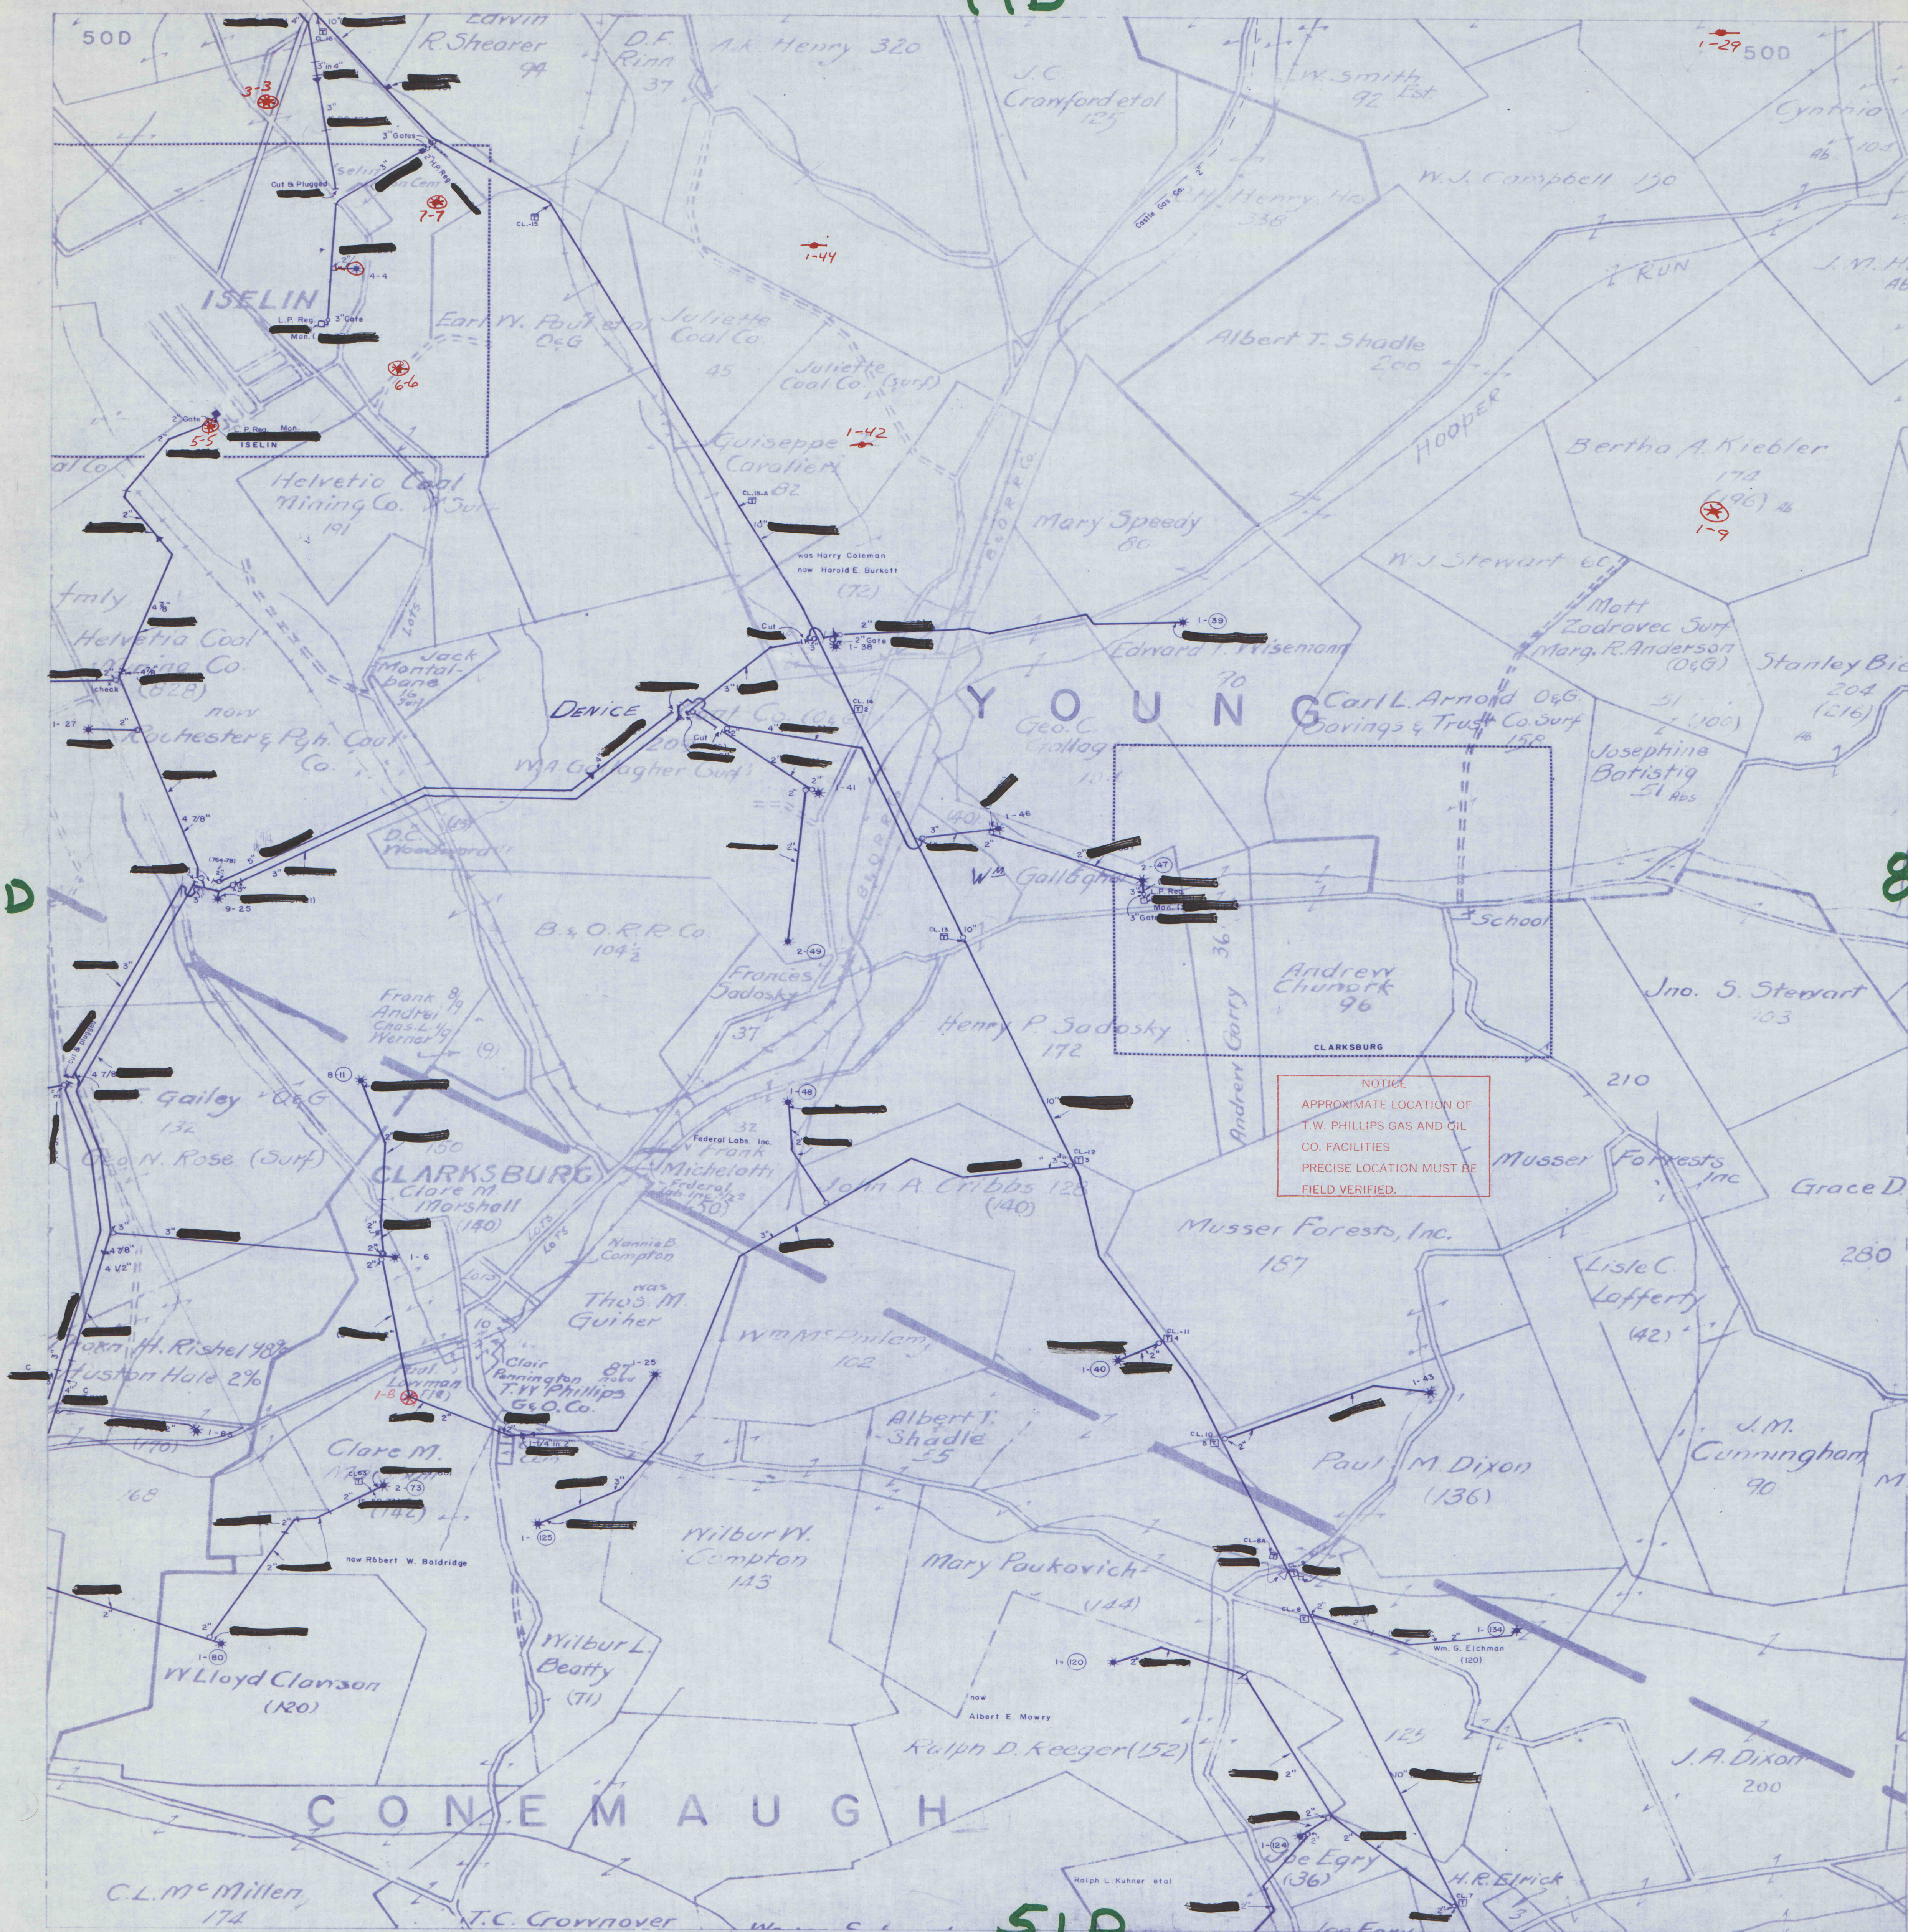

IMAPS # 10558

Indiana Co.

Index No. 50D

District Cl.

12103-92