


108D

79D

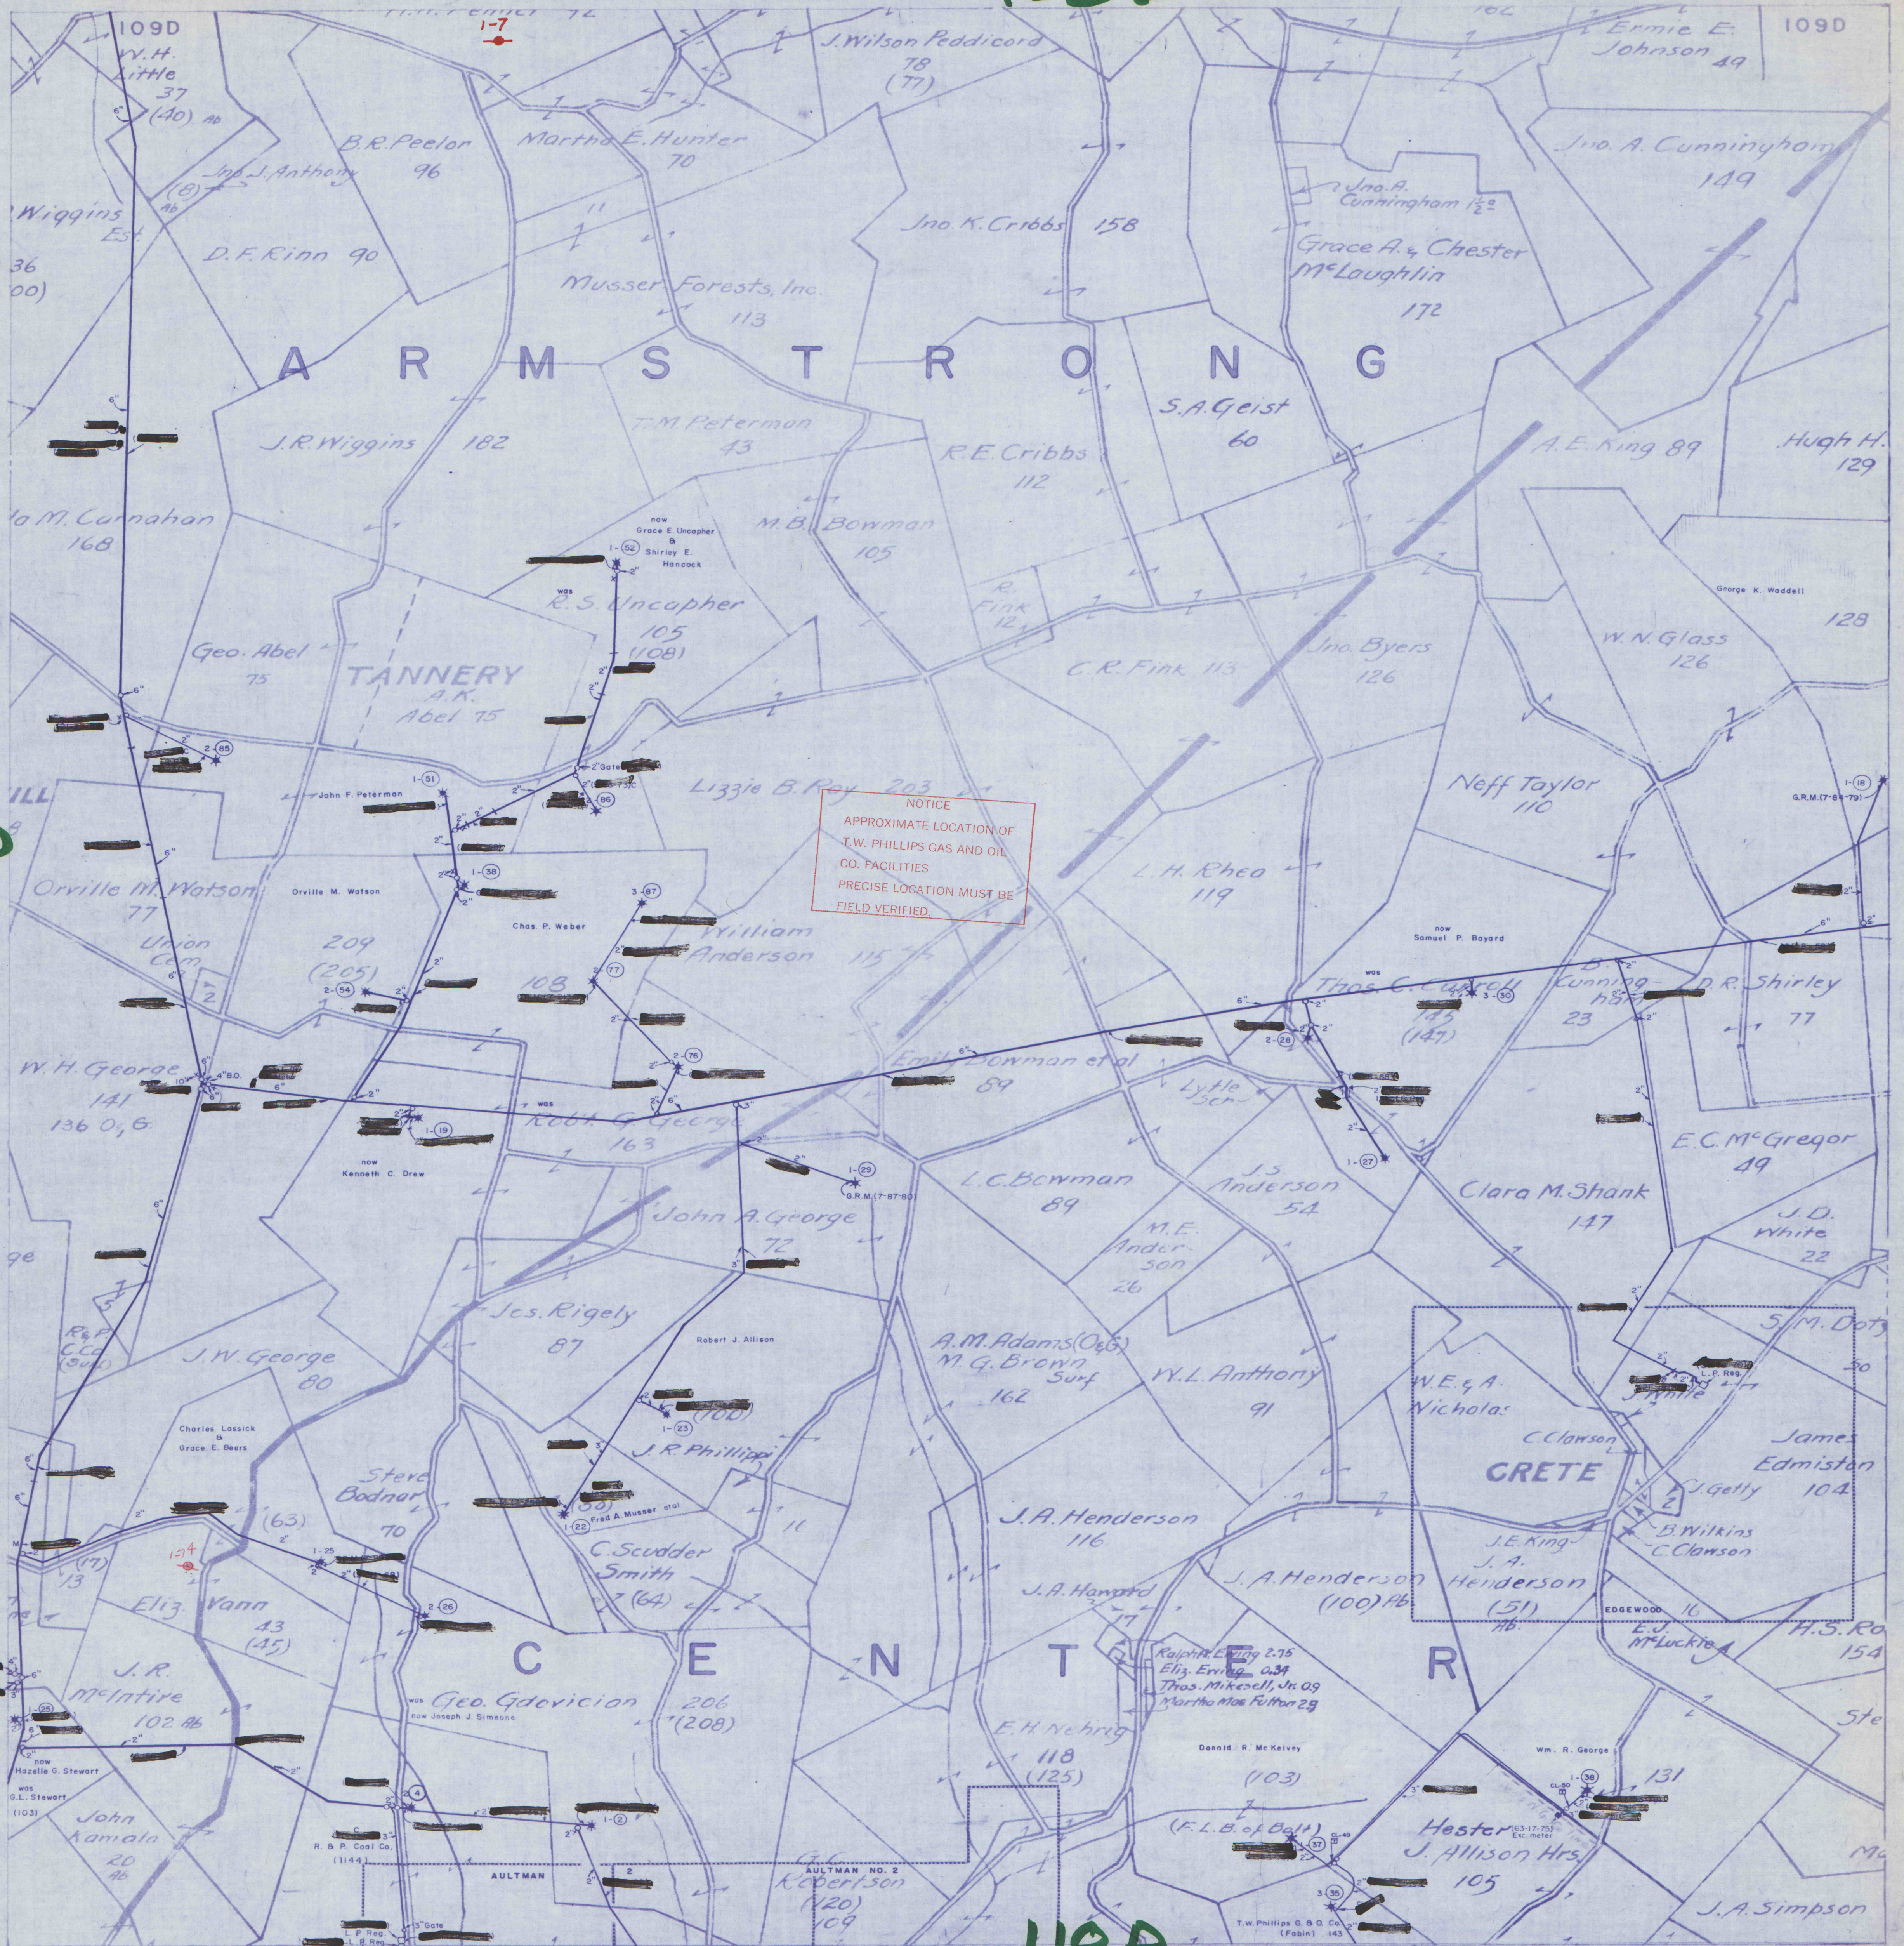

NOTICE
APPROXIMATE LOCATION OF
T.W. PHILLIPS GAS AND OIL
CO. FACILITIES
PRECISE LOCATION MUST BE
FIELD VERIFIED.

MAPS # 10570

Indiana Co.

Index No. 109 D

District Cl.

12103-92