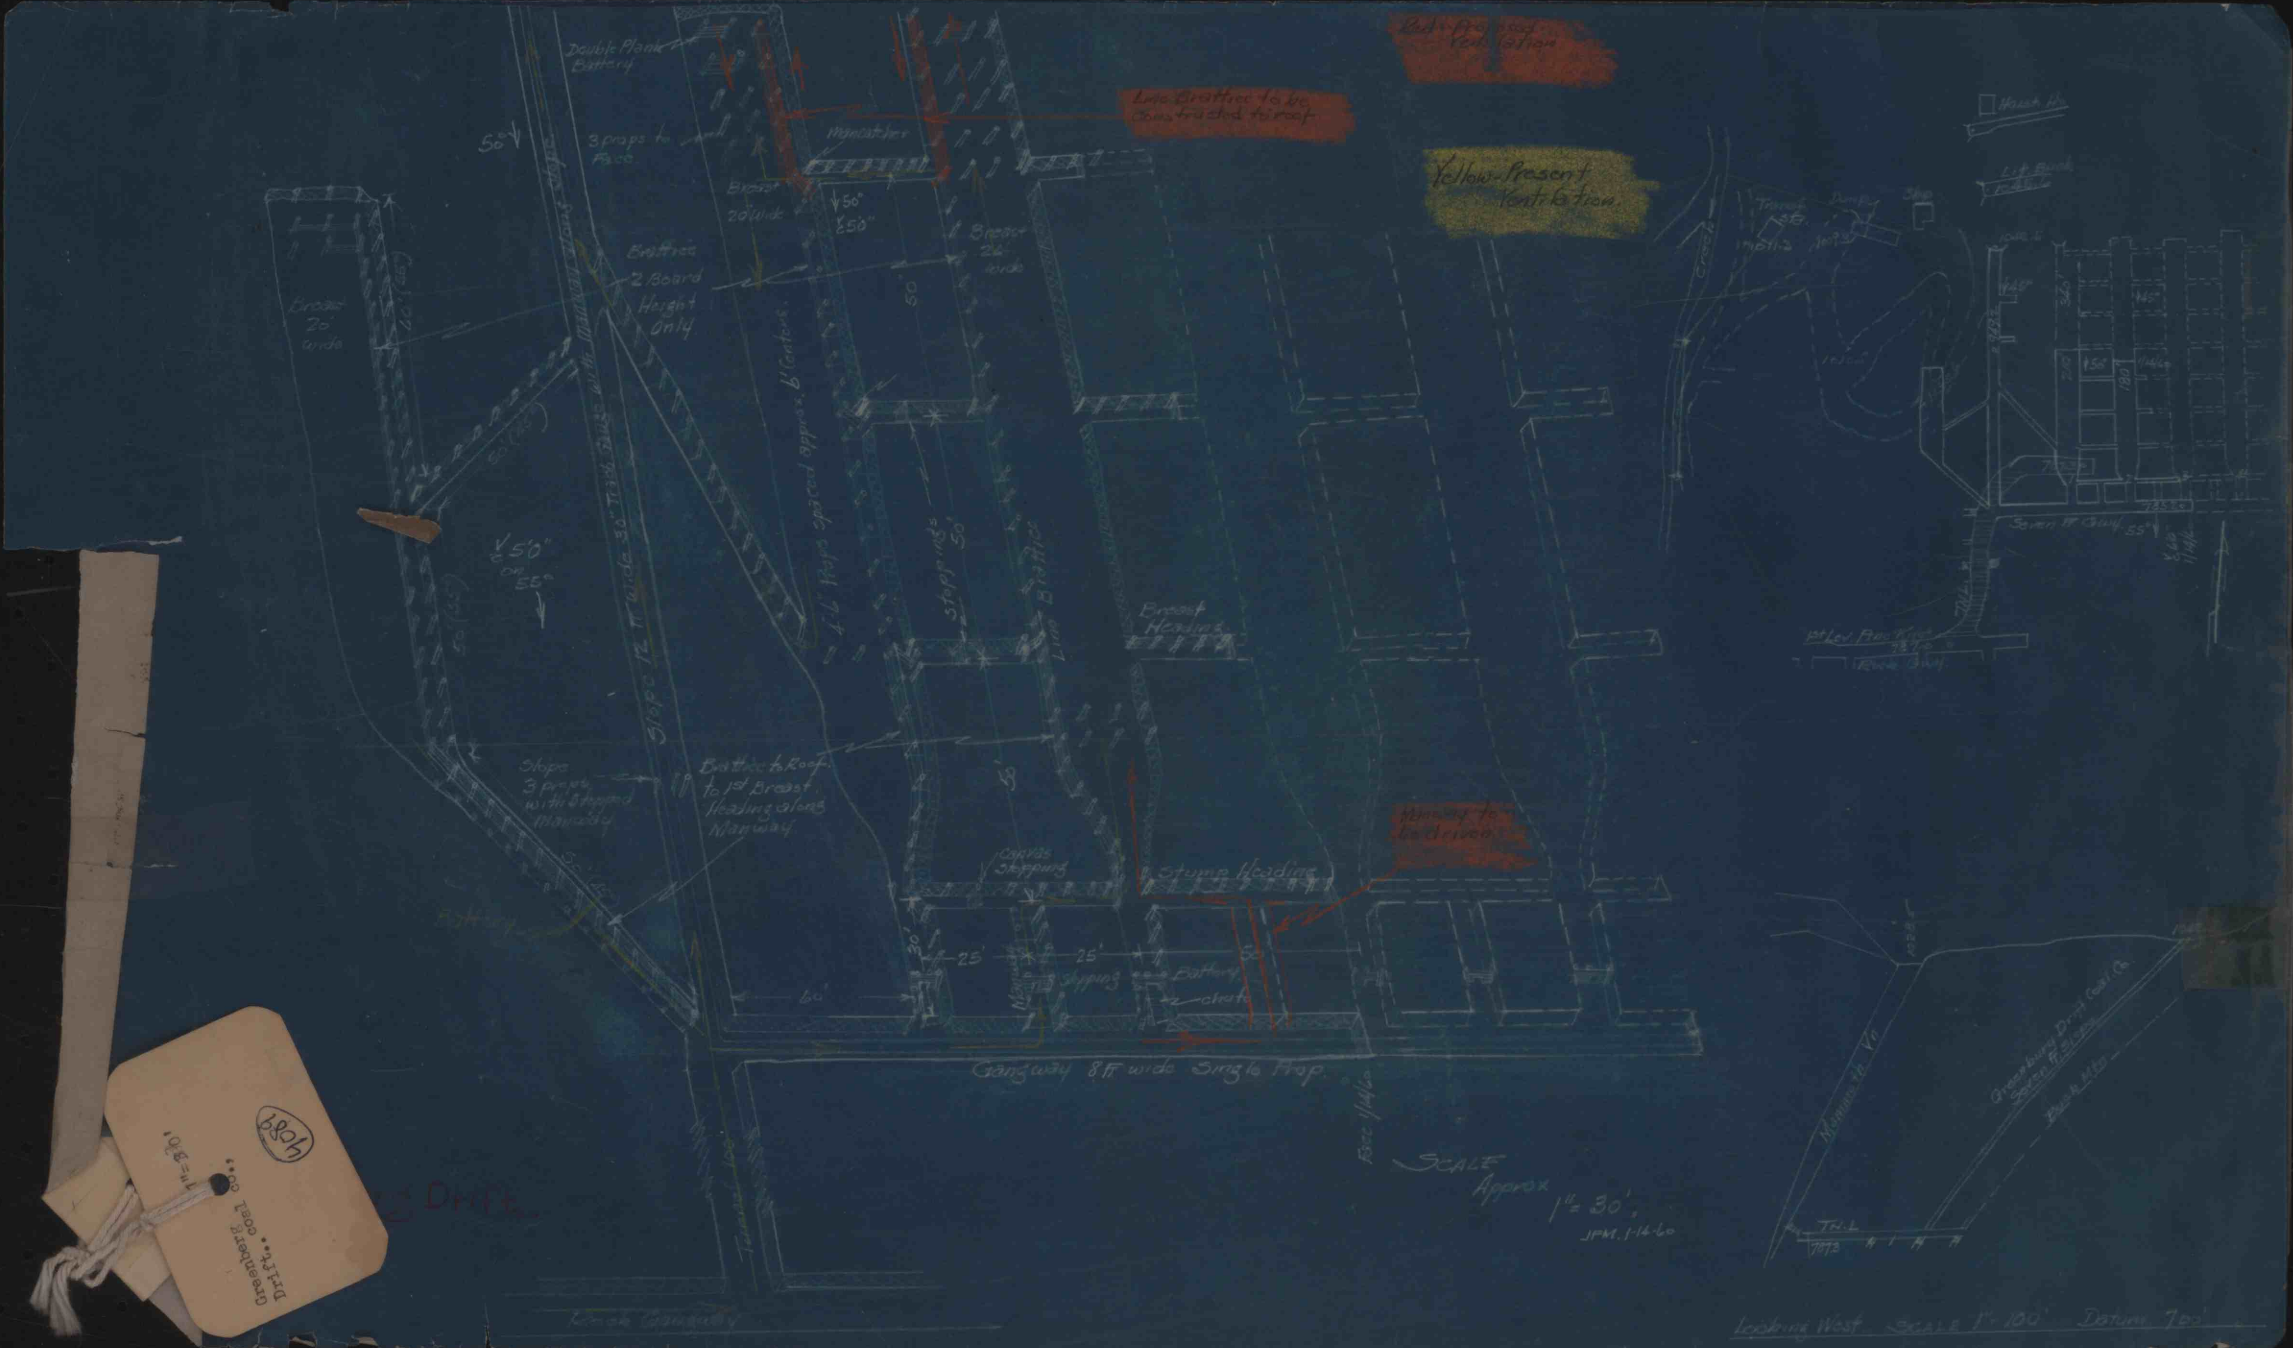

Red - Proposed Ventilation
Line Brattice to be constructed to roof
Yellow - Present Ventilation
Double Plank Battery
3 props to Face
Mancatcher
Breast 20' wide
Breast 24' wide
Brattice 2 Board Height Only
Breast 20' wide
Stopings 50'
Line Brattice
Breast Heading
Stope 3 props with Stagered Manway
Brattice to Roof to 1st Breast Heading along Manway
Canvas Stopping
Stump Heading
Manway to be driven
Battery
Stopping
Battery
Gangway 8 ft wide Single Prop.
SCALE Approx 1" = 30'
JPM. 1-14-60
Seven Ft. Chute
Looking West SCALE 1" = 100' Datum 700'
Greenberg Drift Coal Co.
Greenberg Drift coal co.
1" = 30'
4089