


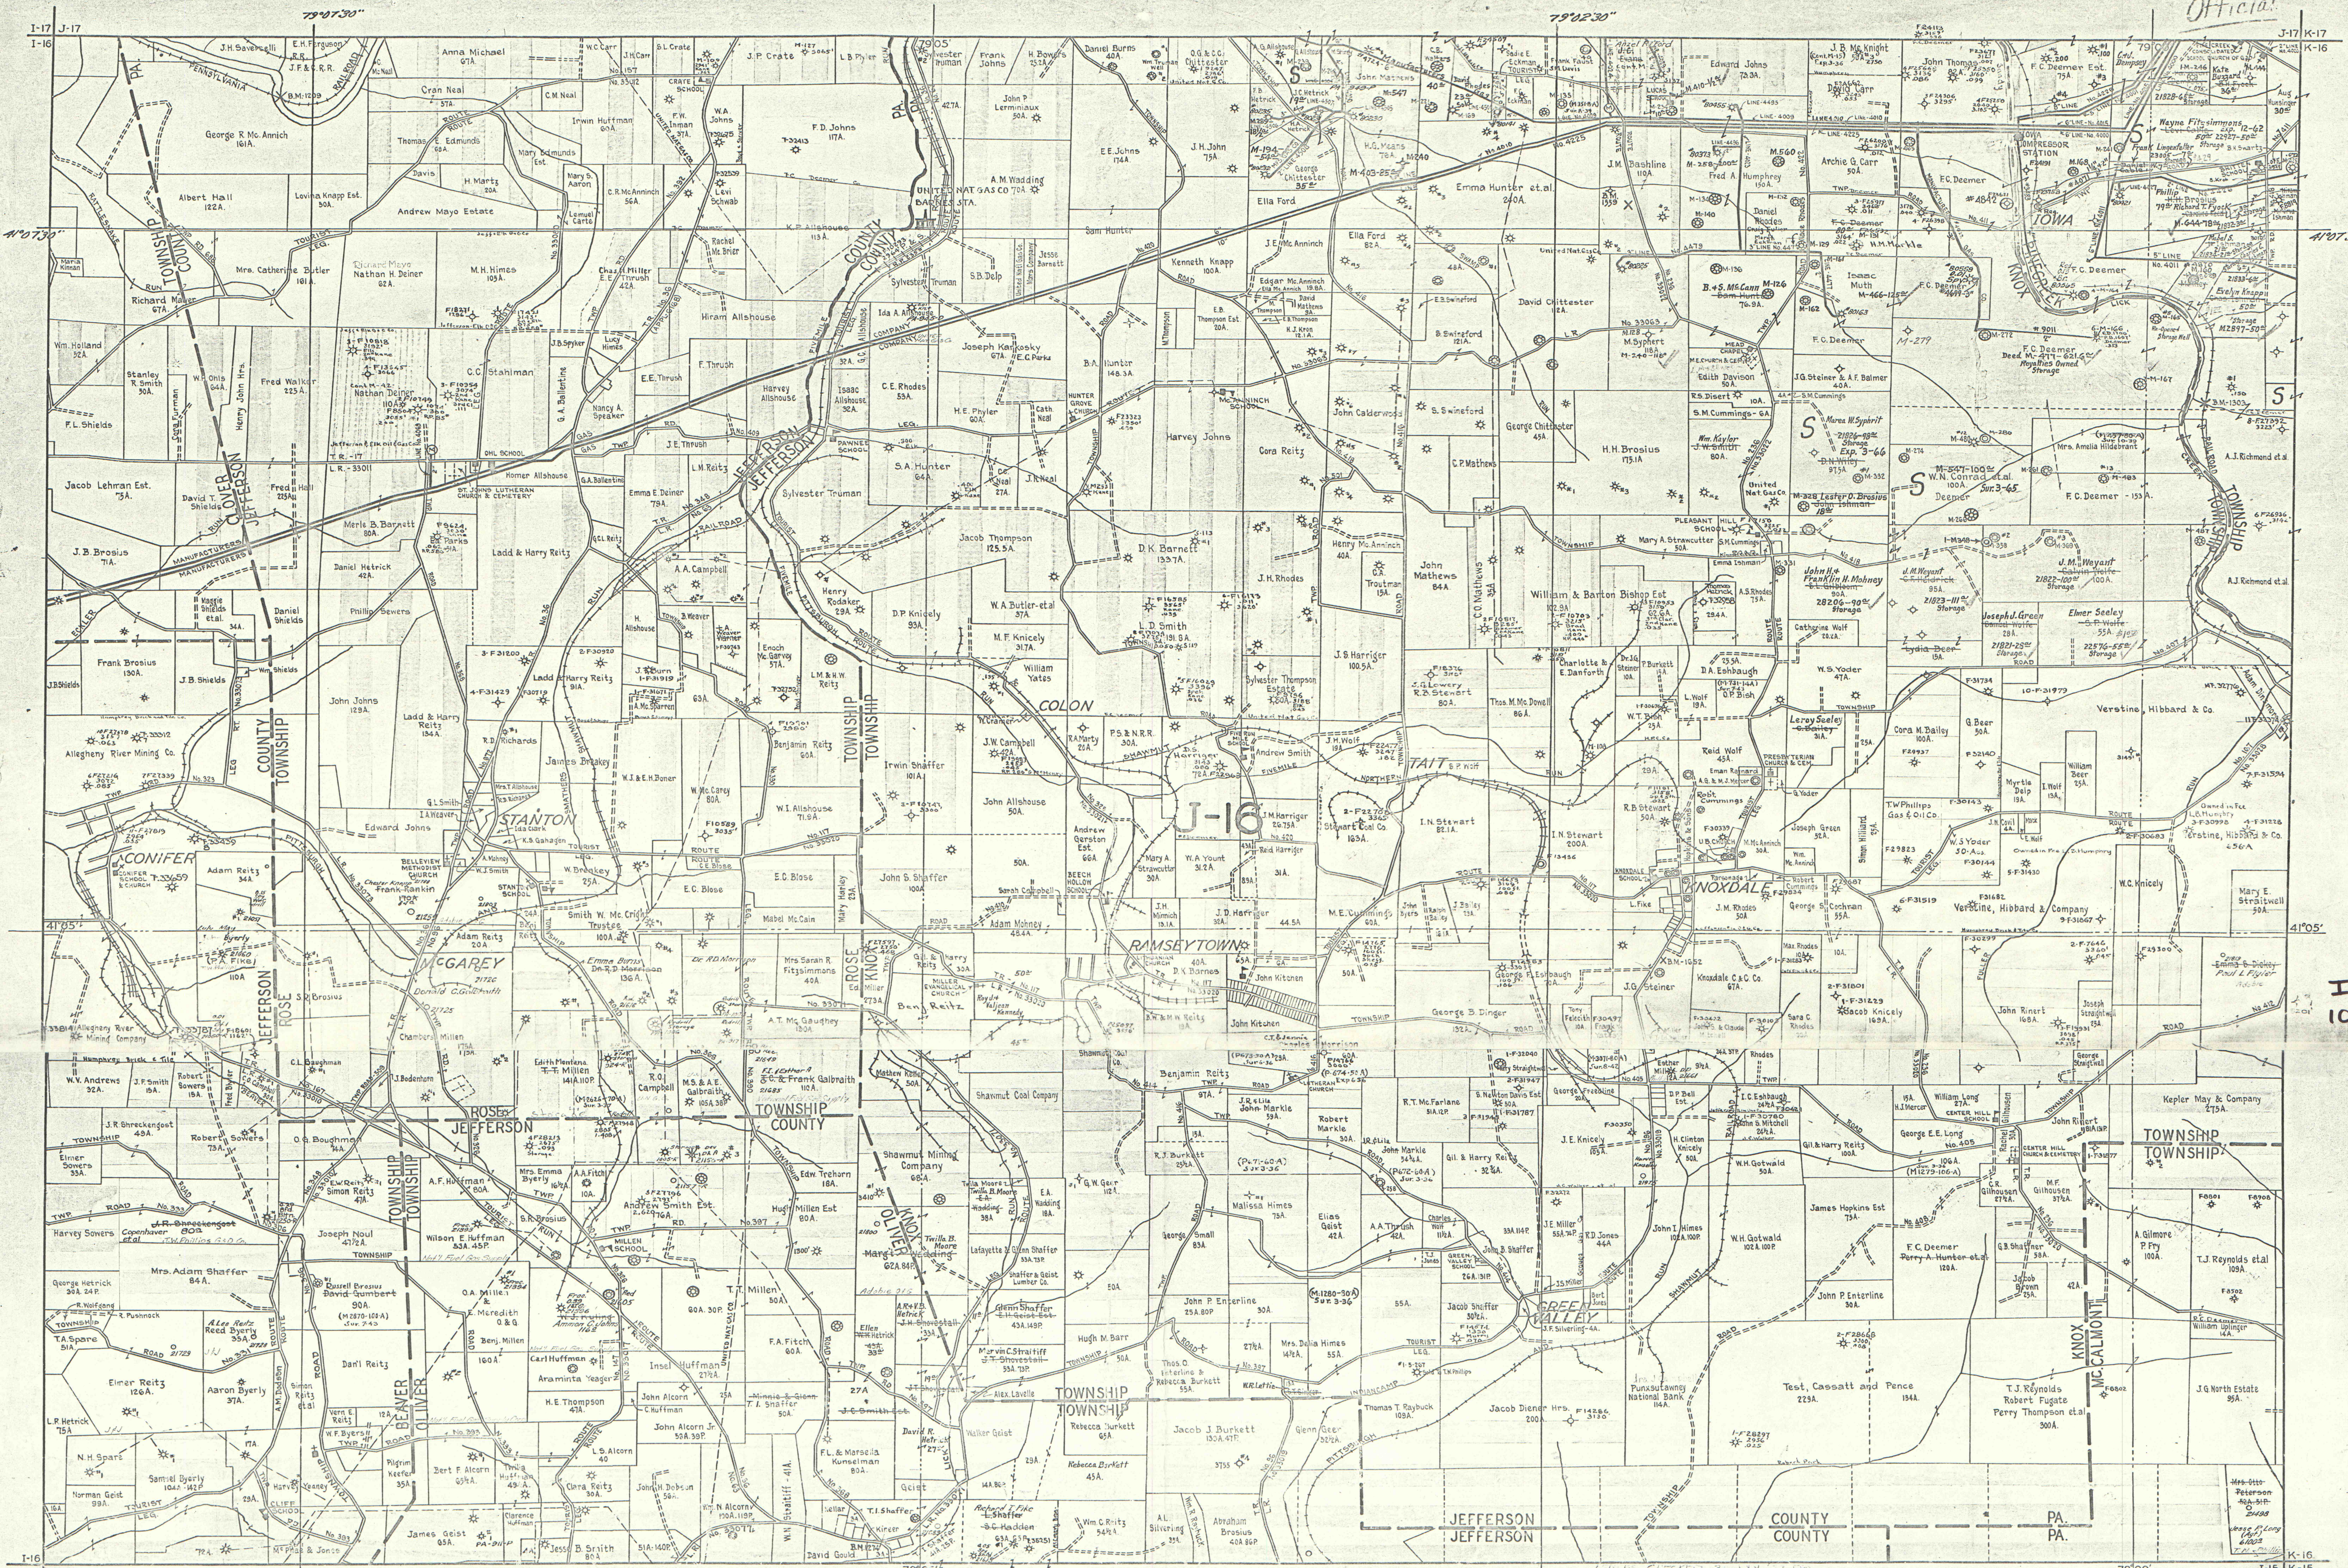

IMAPS
10623

Please Do Not Fold or Crease

B. J. HEIN & ENGINEERS, DEPT. MANUFACTURERS GAS CO. PITTSBURGH, PA. 15102