


26-E7001

NEW YORK STATE NATURAL GAS CORPORATION  
SOUTH BEND STORAGE MAP

26-E7001

1" = 1320' SCALE  
1" = 1/4 MILE

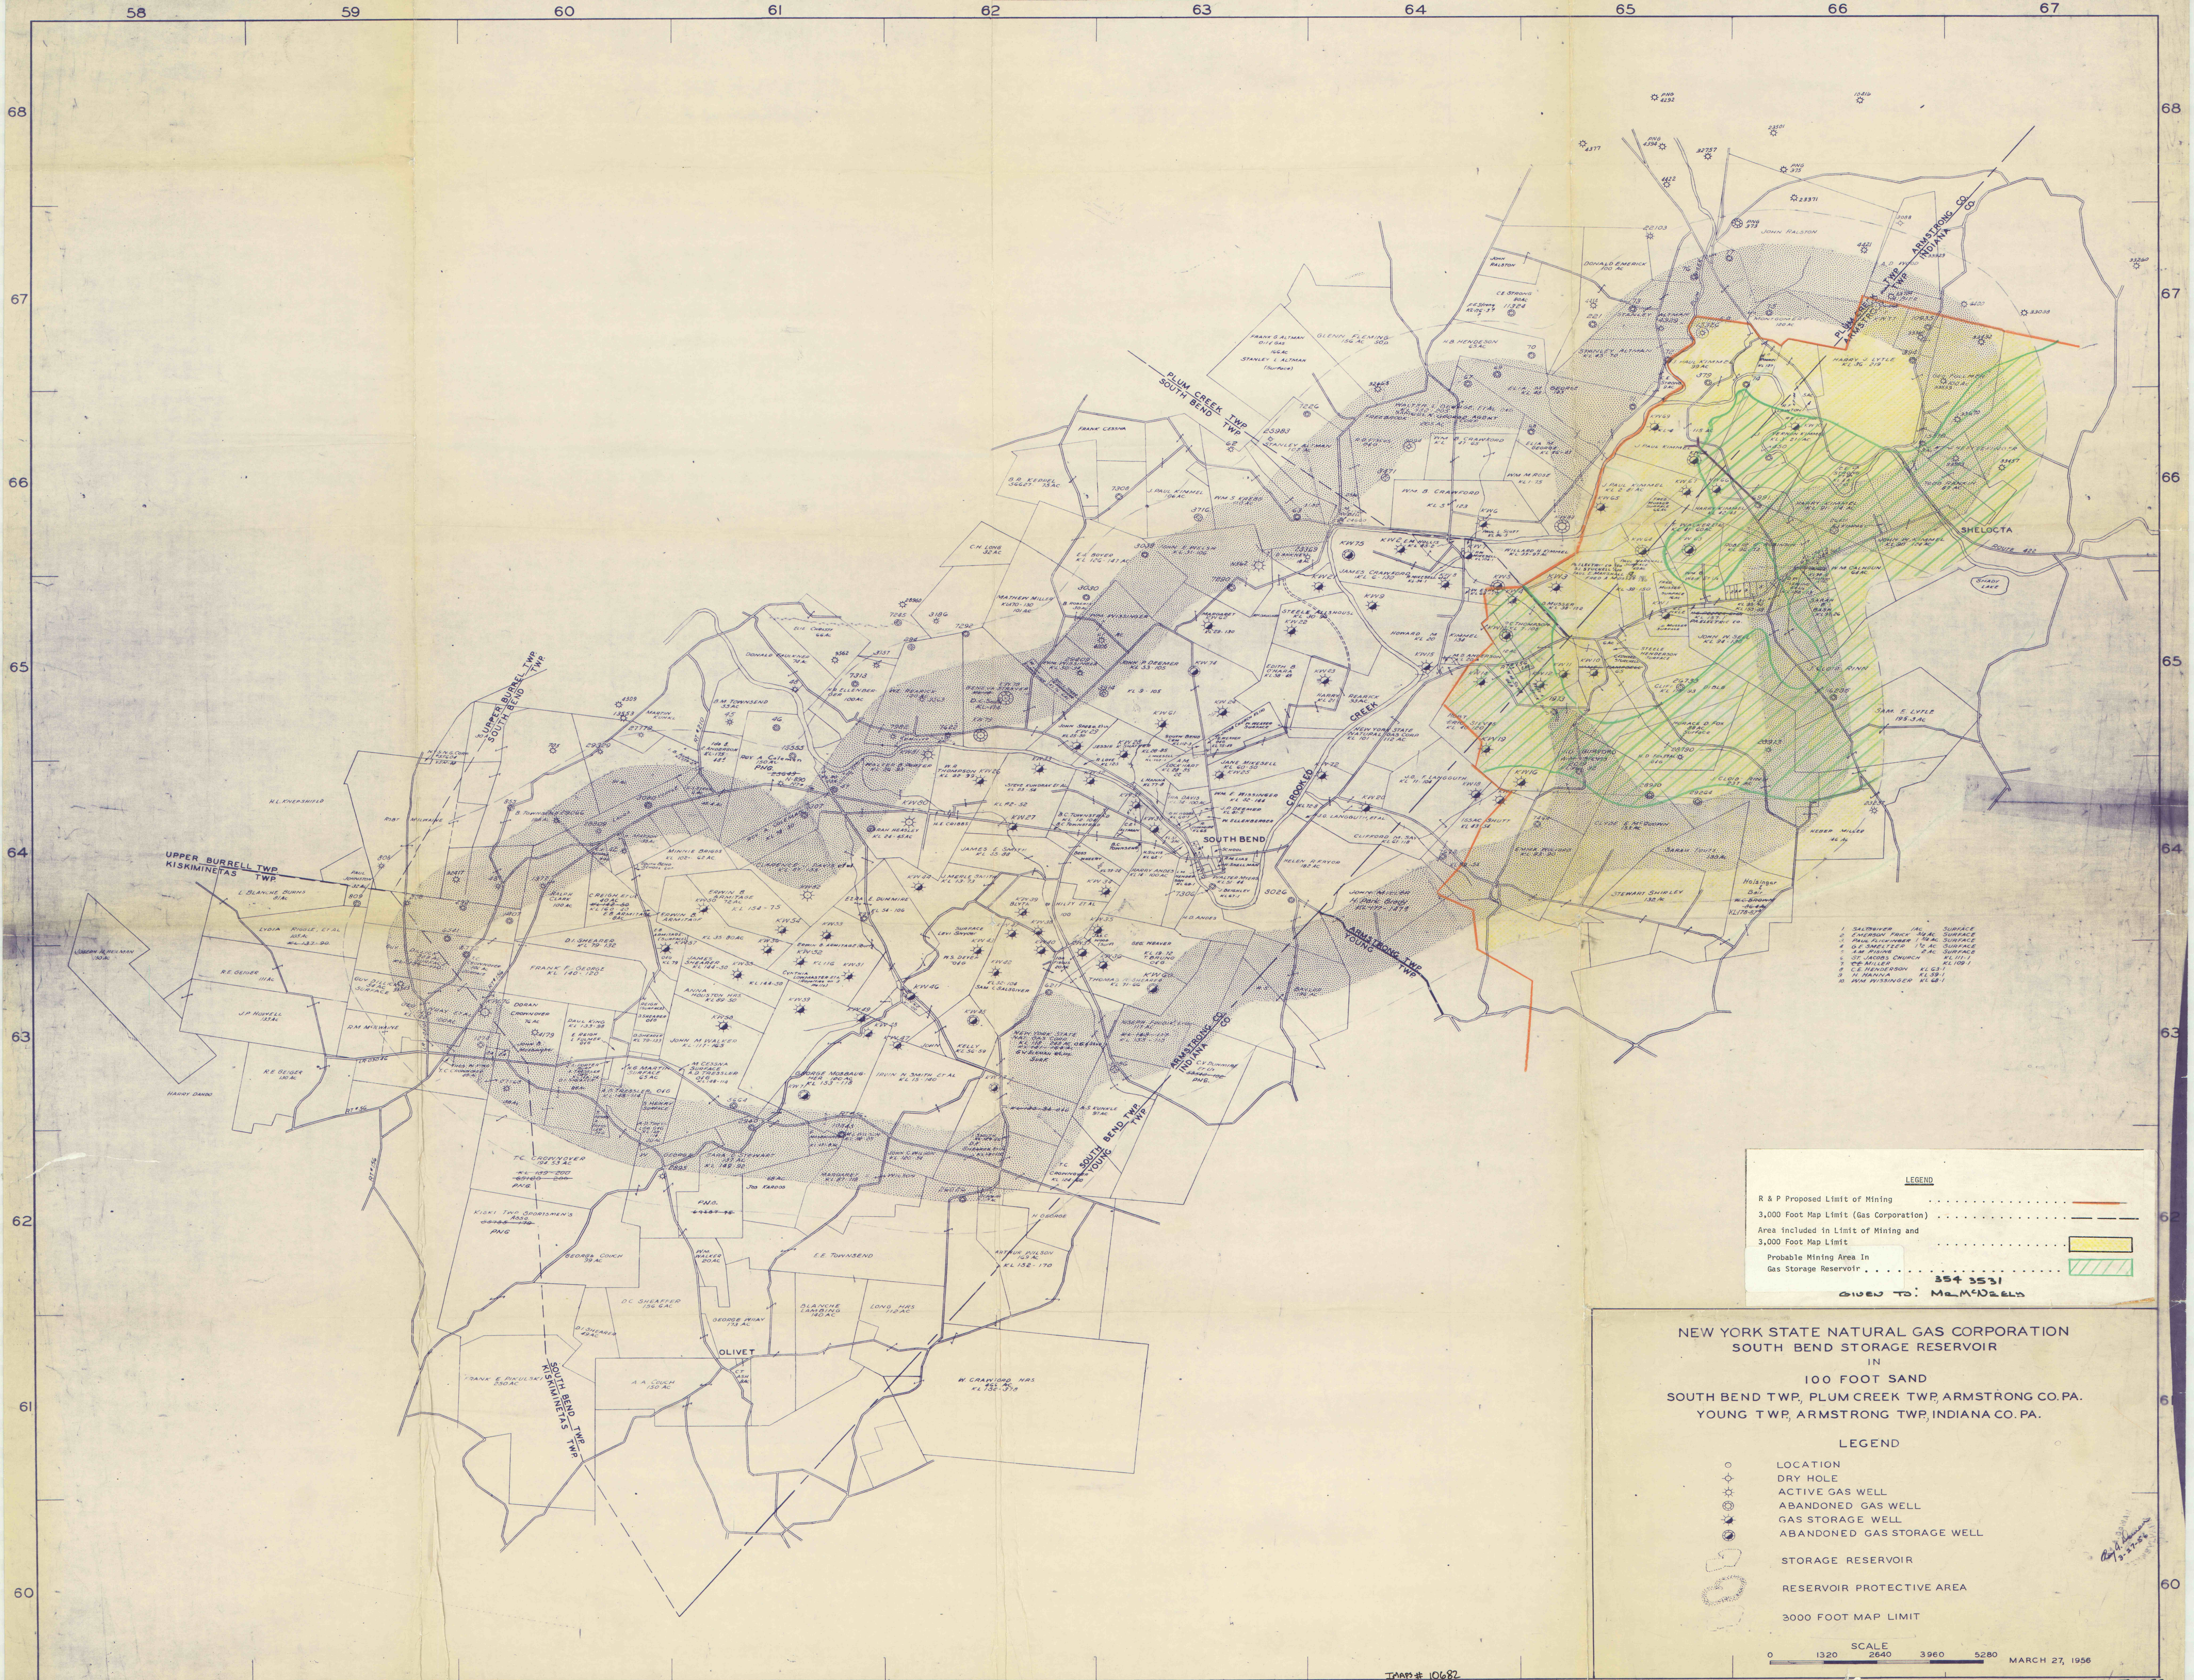

**LEGEND**

R & P Proposed Limit of Mining . . . . .

3,000 Foot Map Limit (Gas Corporation) . . . . .

Area Included in Limit of Mining and 3,000 Foot Map Limit . . . . .

Probable Mining Area In Gas Storage Reservoir . . . . .

354 3531  
GIVEN TO: M. M. D. 2.6.5

**NEW YORK STATE NATURAL GAS CORPORATION**  
**SOUTH BEND STORAGE RESERVOIR**  
IN  
**100 FOOT SAND**  
**SOUTH BEND TWP, PLUM CREEK TWP, ARMSTRONG CO. PA.**  
**YOUNG TWP, ARMSTRONG TWP, INDIANA CO. PA.**

**LEGEND**

○ LOCATION

⊕ DRY HOLE

⊕ ACTIVE GAS WELL

⊕ ABANDONED GAS WELL

⊕ GAS STORAGE WELL

⊕ ABANDONED GAS STORAGE WELL

STORAGE RESERVOIR

RESERVOIR PROTECTIVE AREA

3000 FOOT MAP LIMIT

SCALE  
0 1320 2640 3960 5280  
MARCH 27, 1956