New J.M. Jancher
Armstrong Twp.

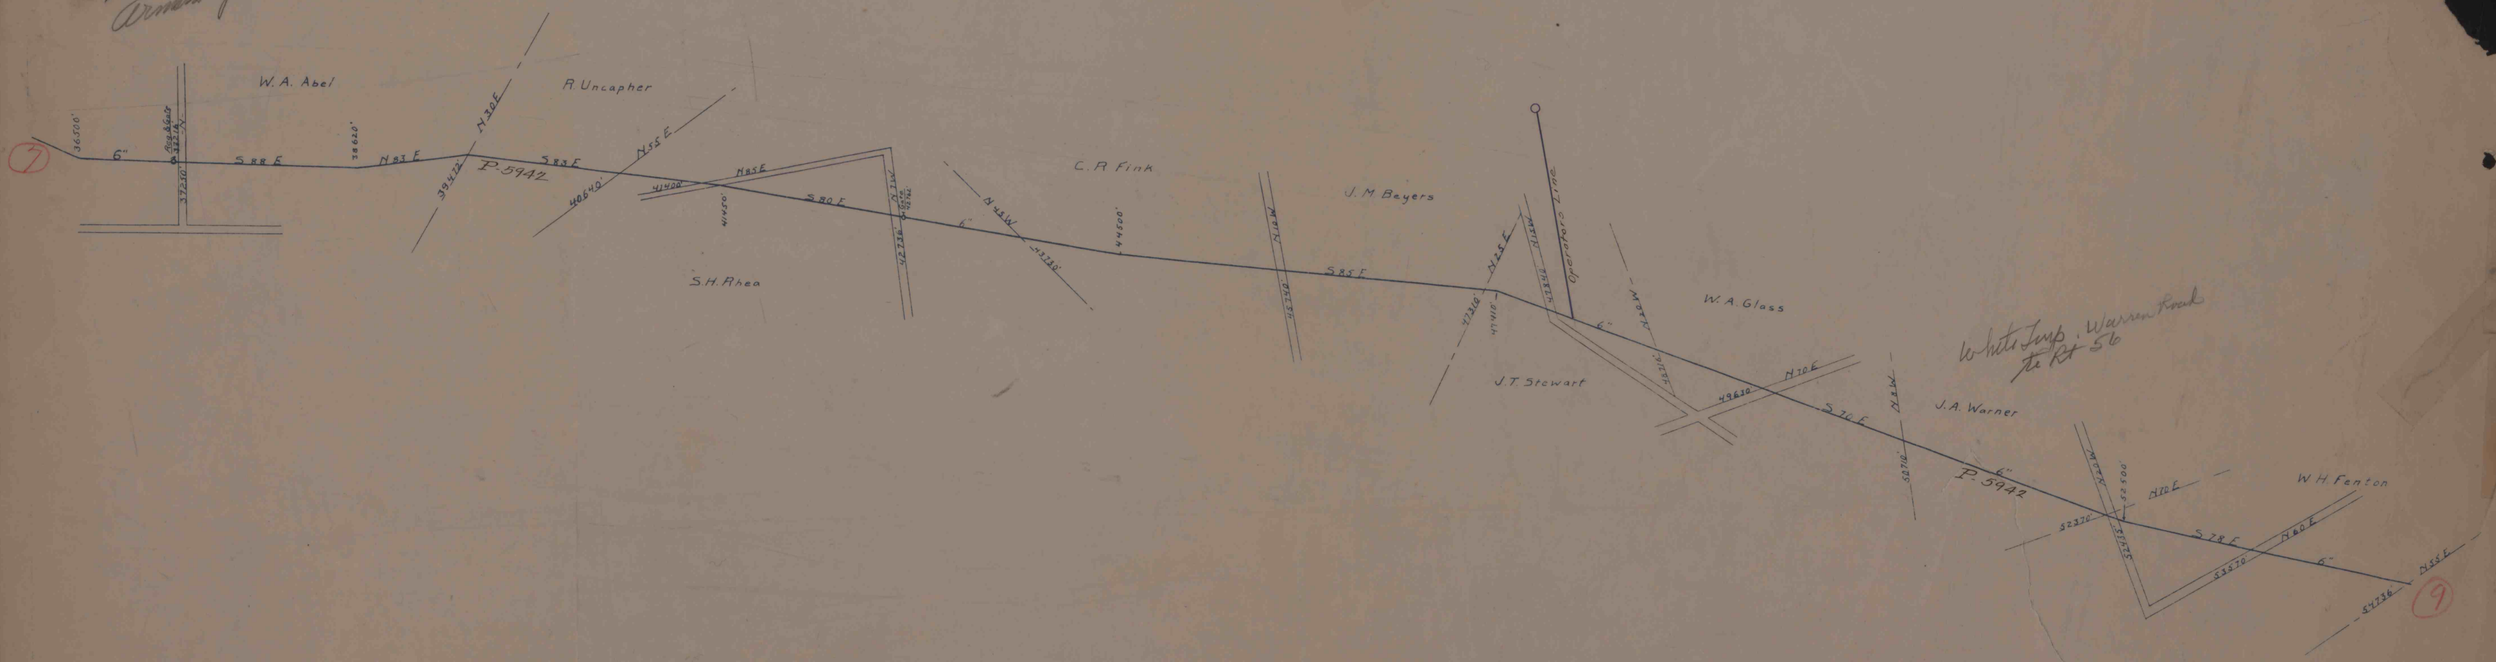

White Twp. Warren Road
to Rt. 56

W.2.1009-1109

Gas Line
Right of Way

2491-92 (?)

IMAPS 10691

2491-92