
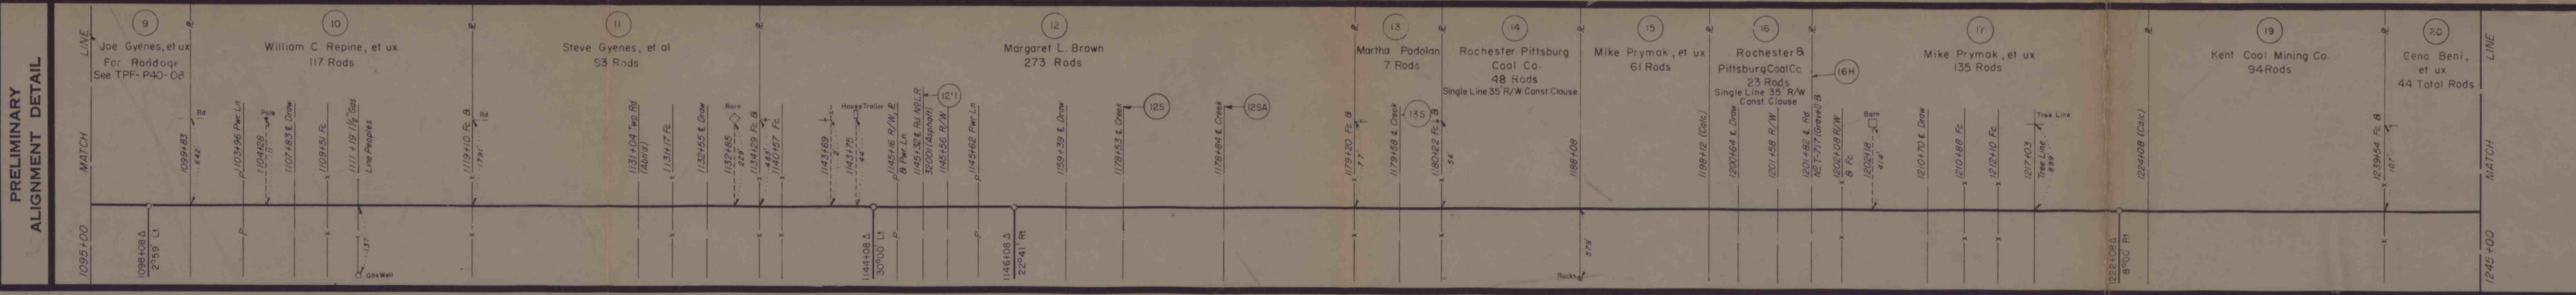
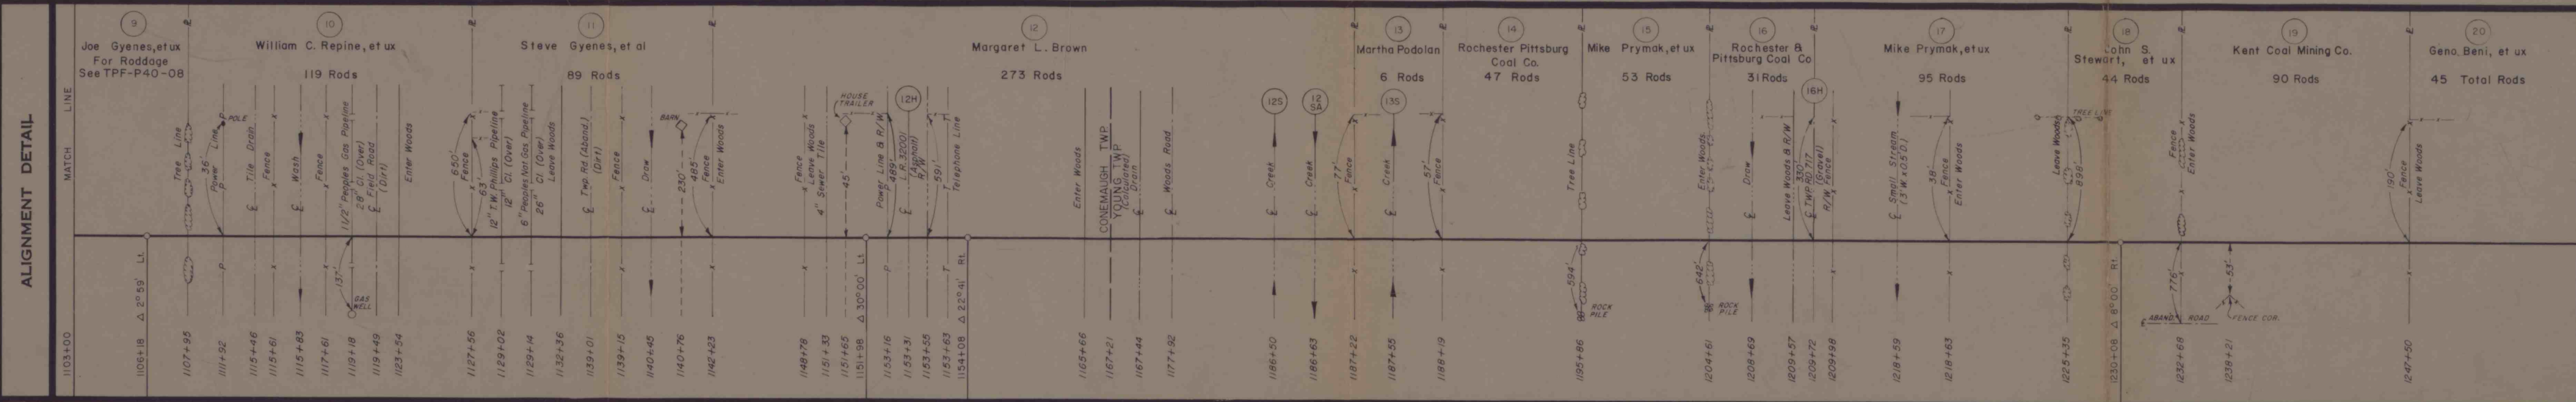


81701 # 230
D.D.H # 230

GENERAL AERIAL SURVEYS CO. HOUSTON - 17, TEXAS

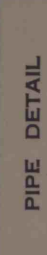

D BOOK NO. 14, PAGES 3-10

(Size & Length)

10

9-28-64	DATE	As Built Per W.O.C-1848 Constr
REV	REVISION	

100

3-30-64	Checked B	Corrected	BY	APP.