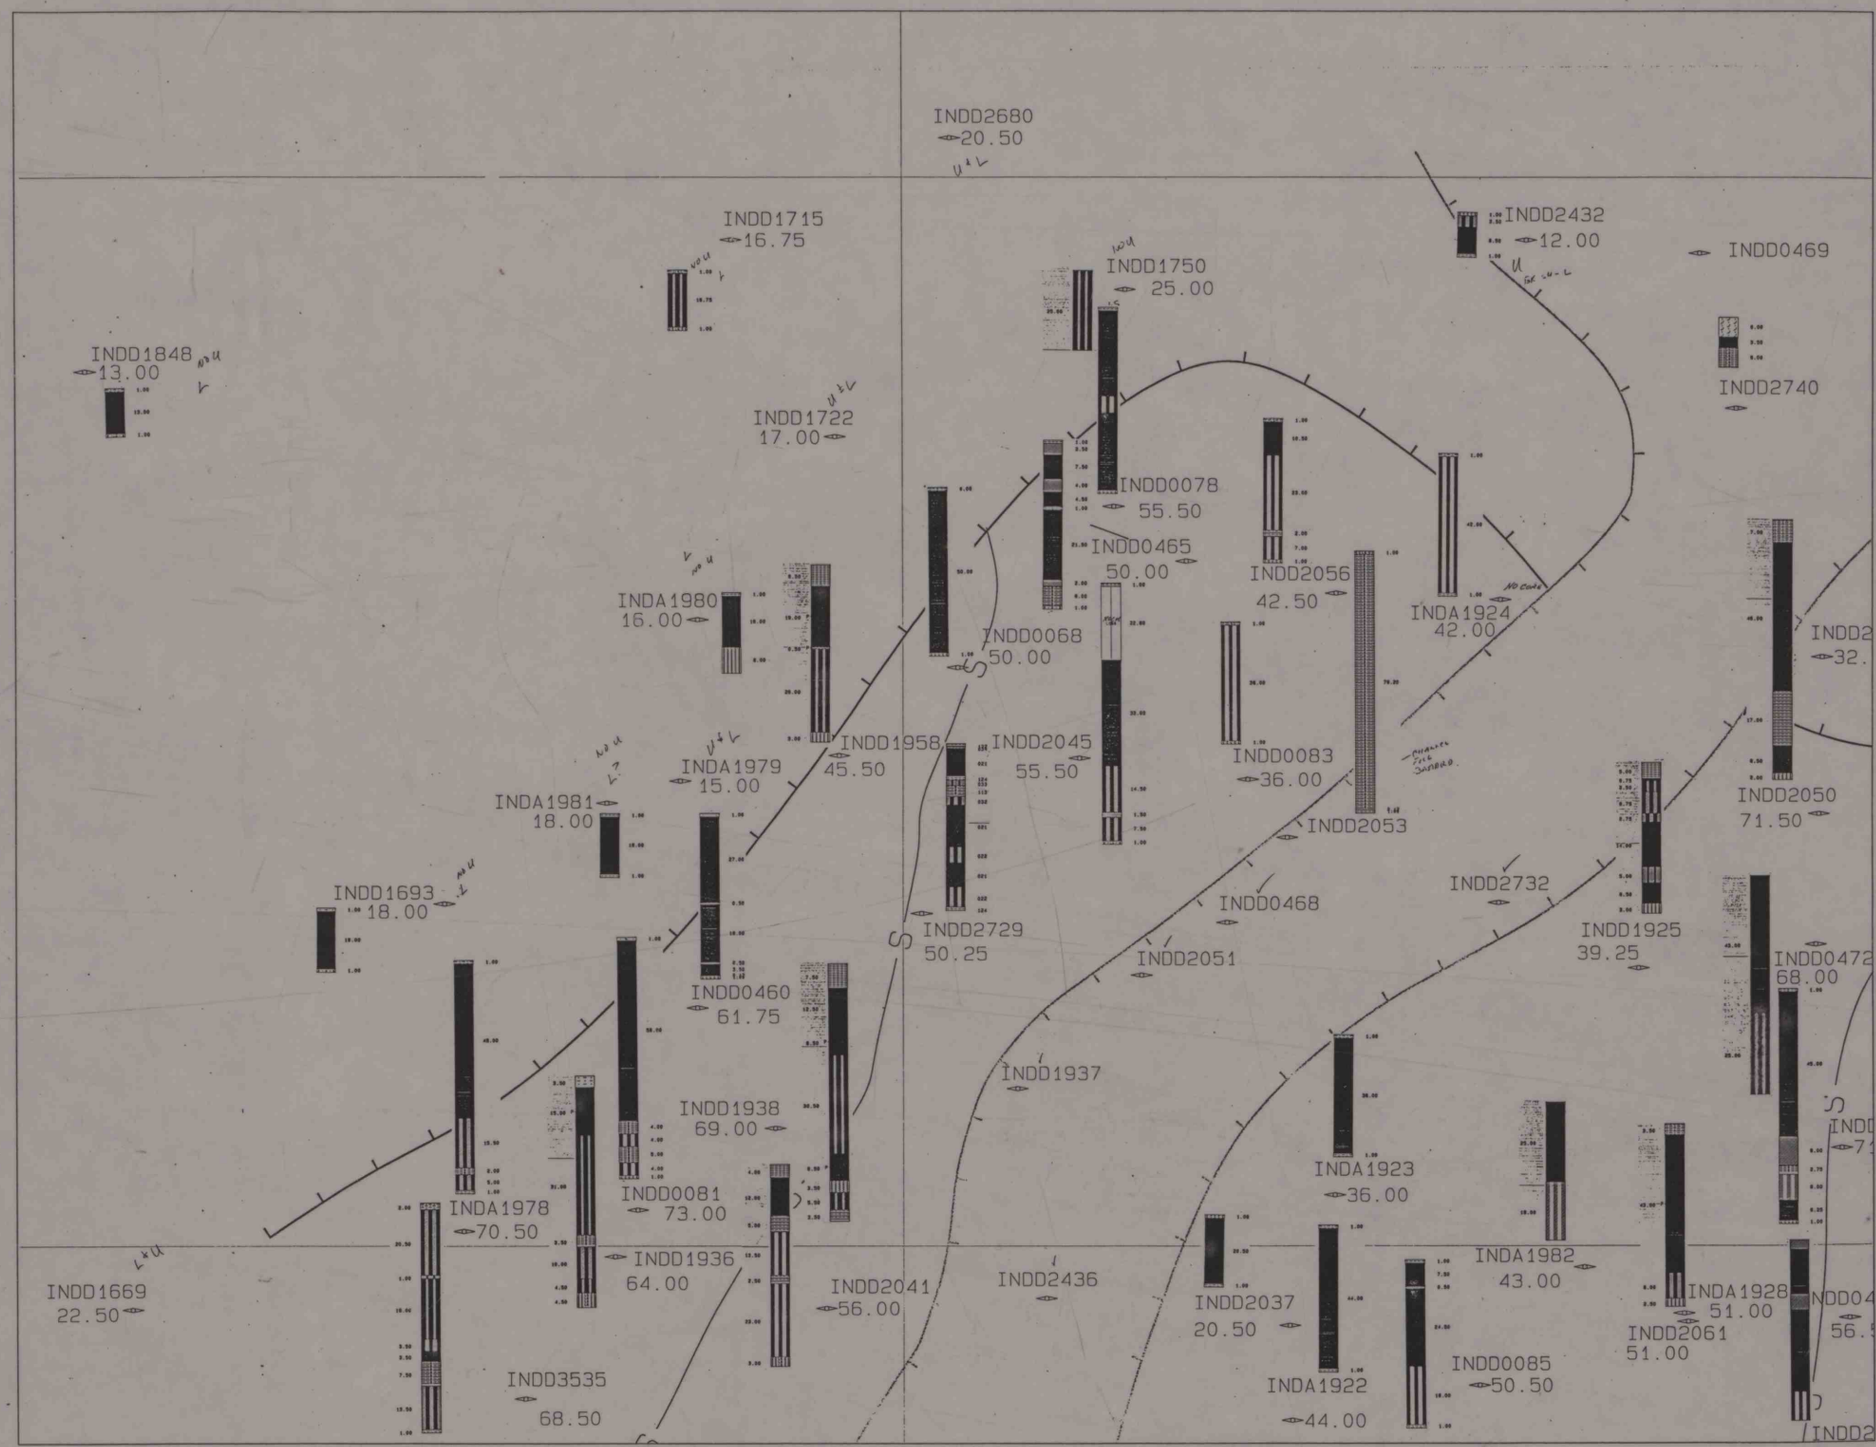
INDD2680
20.50
INDD1715
16.75
INDD1848
13.00
INDD1722
17.00
INDD1750
25.00
INDD2432
12.00
INDD0469
INDD2740
INDD0078
55.50
INDD0465
50.00
INDD2056
42.50
INDA1924
42.00
INDA1980
16.00
INDD0068
50.00
INDD1958
45.50
INDD2045
55.50
INDD0083
36.00
INDA1979
15.00
INDA1981
18.00
INDD2053
INDD2050
71.50
INDD1693
18.00
INDD2732
INDD0468
INDD2729
50.25
INDD2051
INDD1925
39.25
INDD0460
61.75
INDD0472
68.00
INDD1937
INDD1938
69.00
INDA1923
36.00
INDA1978
70.50
INDD0081
73.00
INDD1936
64.00
INDD2041
56.00
INDD2436
INDA1982
43.00
INDD1669
22.50
INDD2037
20.50
INDA1928
51.00
INDD2061
51.00
INDD3535
68.50
INDA1922
44.00
INDD0085
50.50

IMAPS# 10776