


MINED OUT



BEAVER COUNTY

1 / 250,000

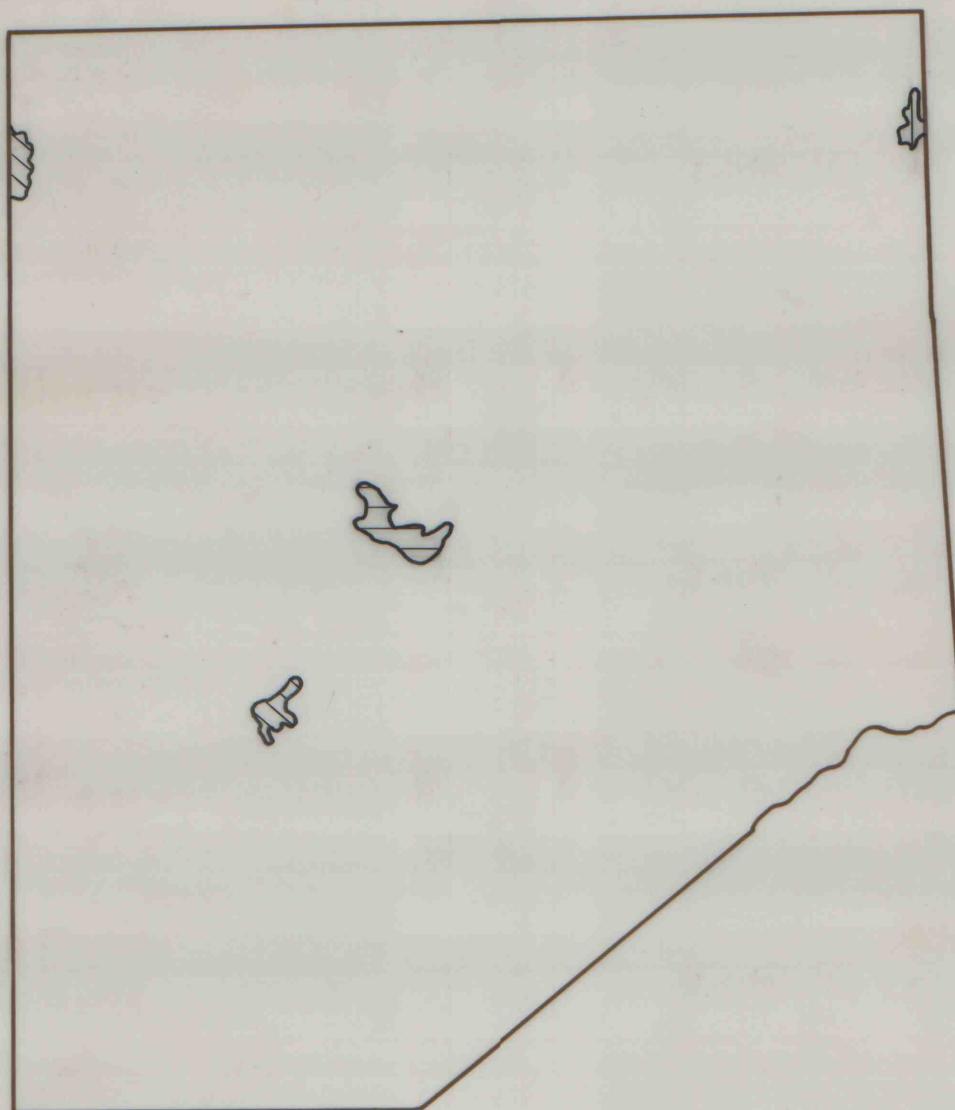

UF



MK



LK

IMAPS# 10846