
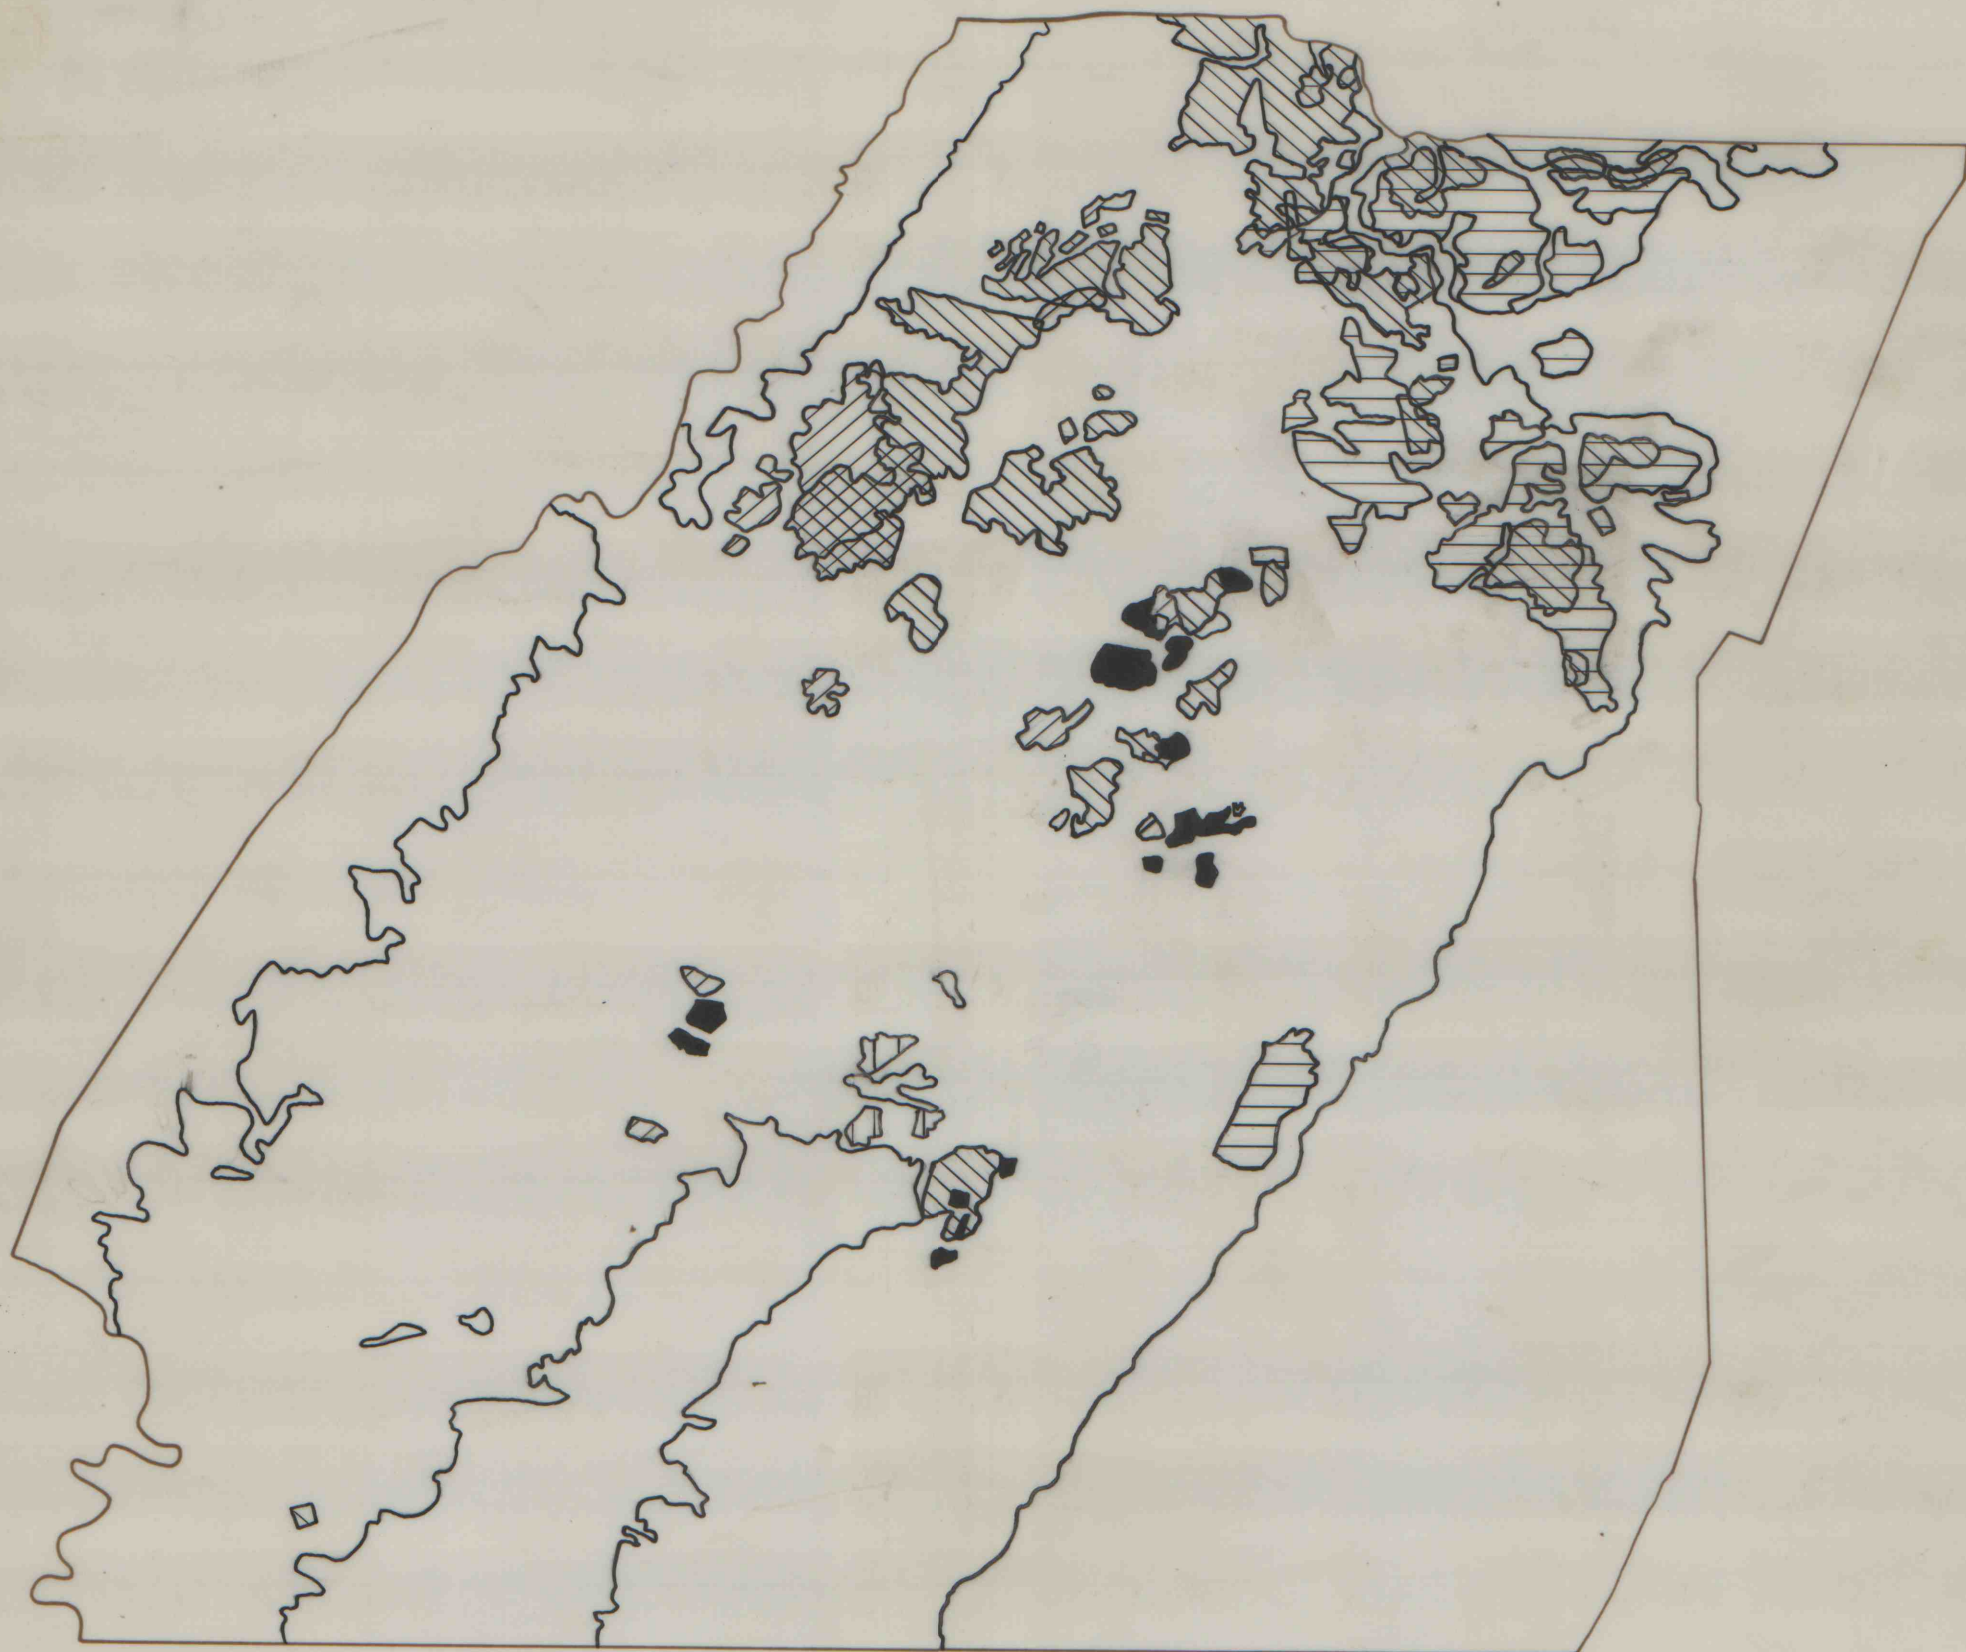
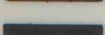


MINED OUT

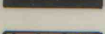

SOMERSET COUNTY
1 / 250,000

	BKV
	LK
	UK
	LF
	UF

IMAPS 10853