


MINED OUT

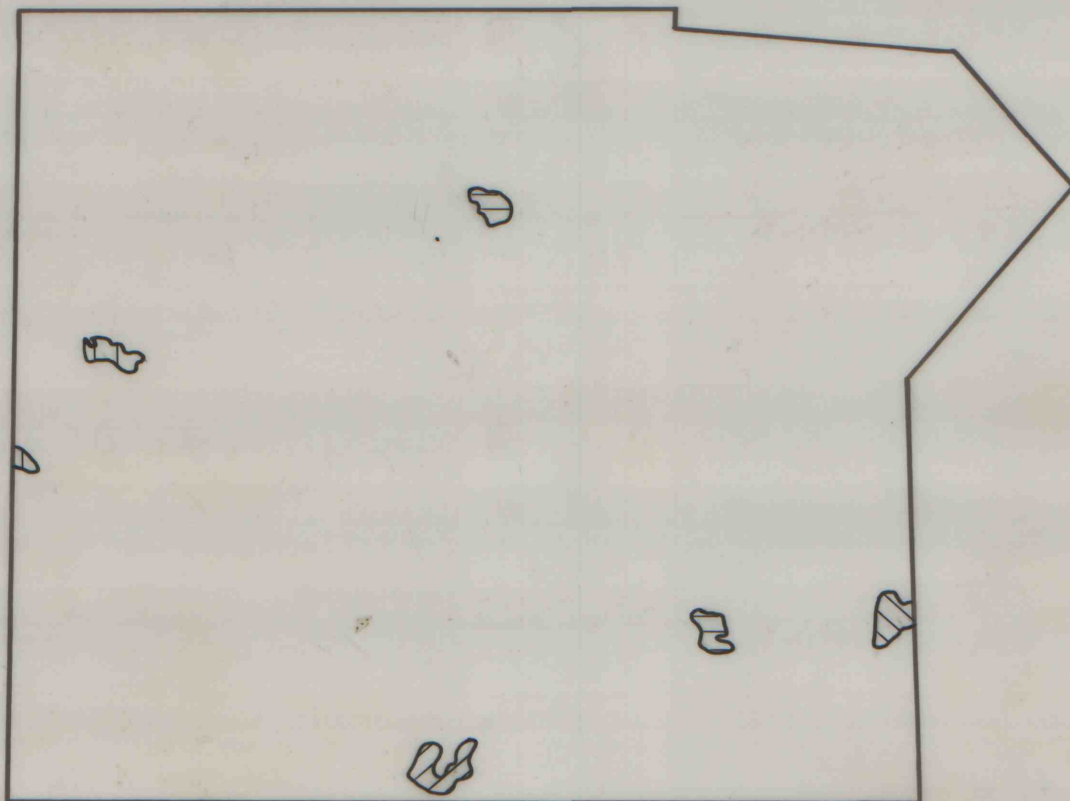

LAWRENCE COUNTY

1 / 250,000



UF



LF



MK



LK

IMAPS # 10865