


MINED OUT

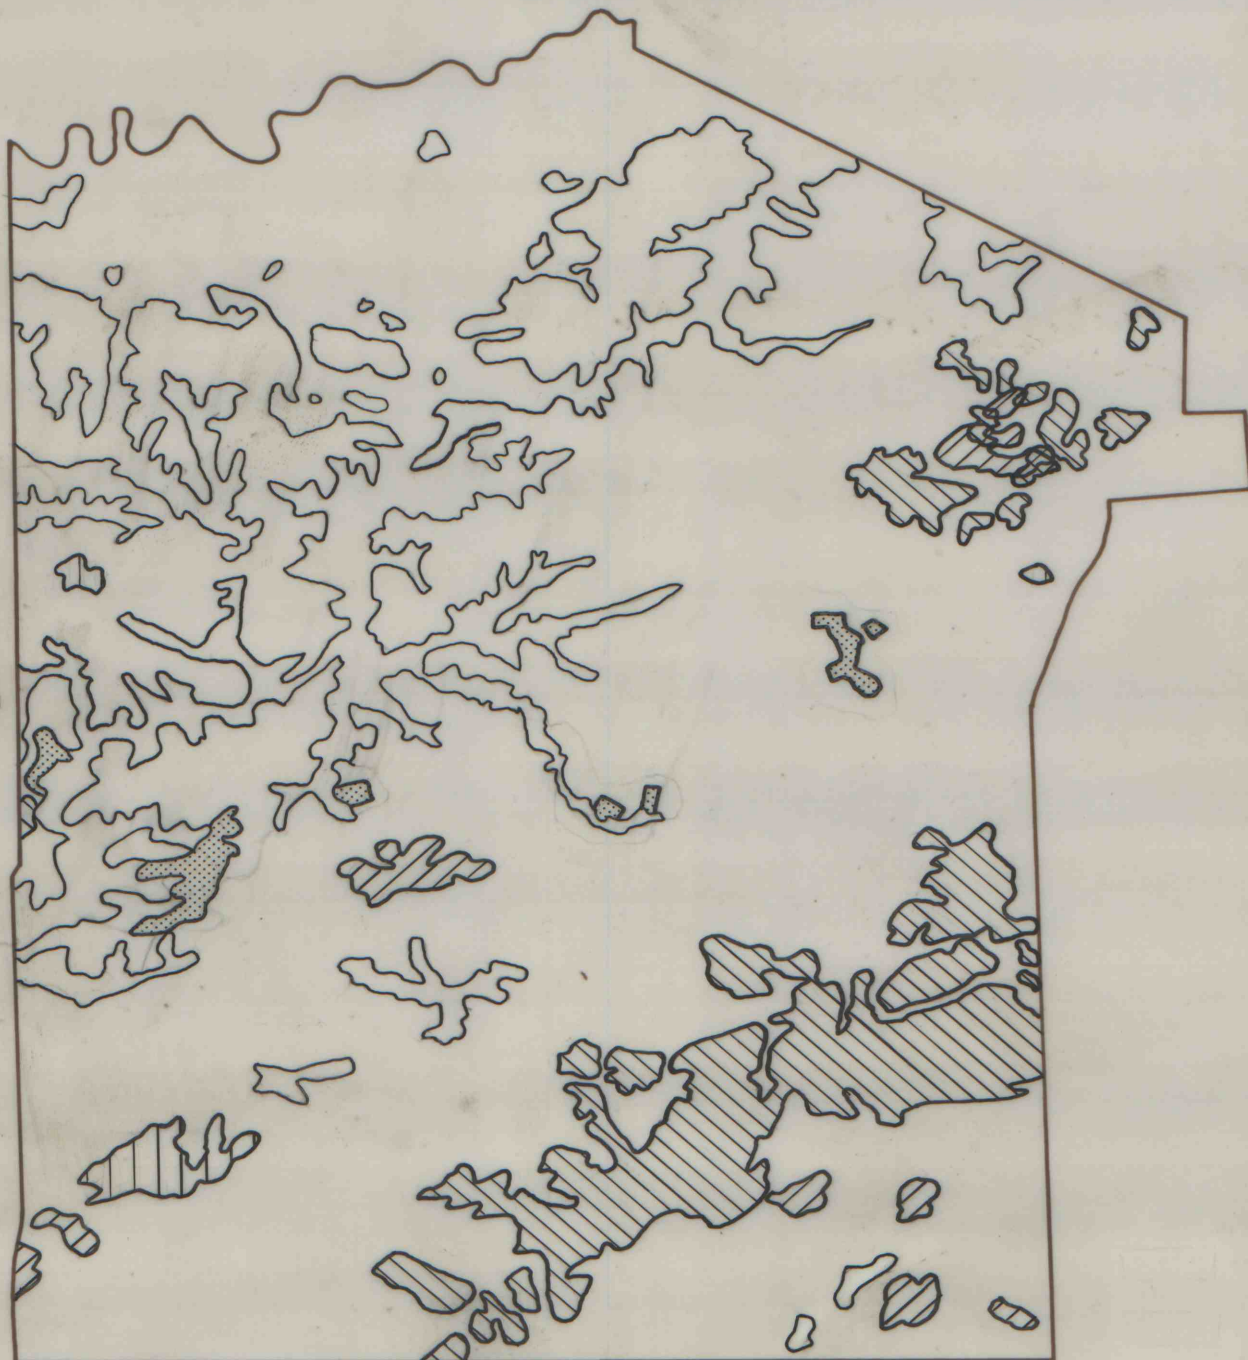

JEFFERSON COUNTY

1 / 250,000

IMAPS # 10868

	UF
	LF
	LK
	BKV