


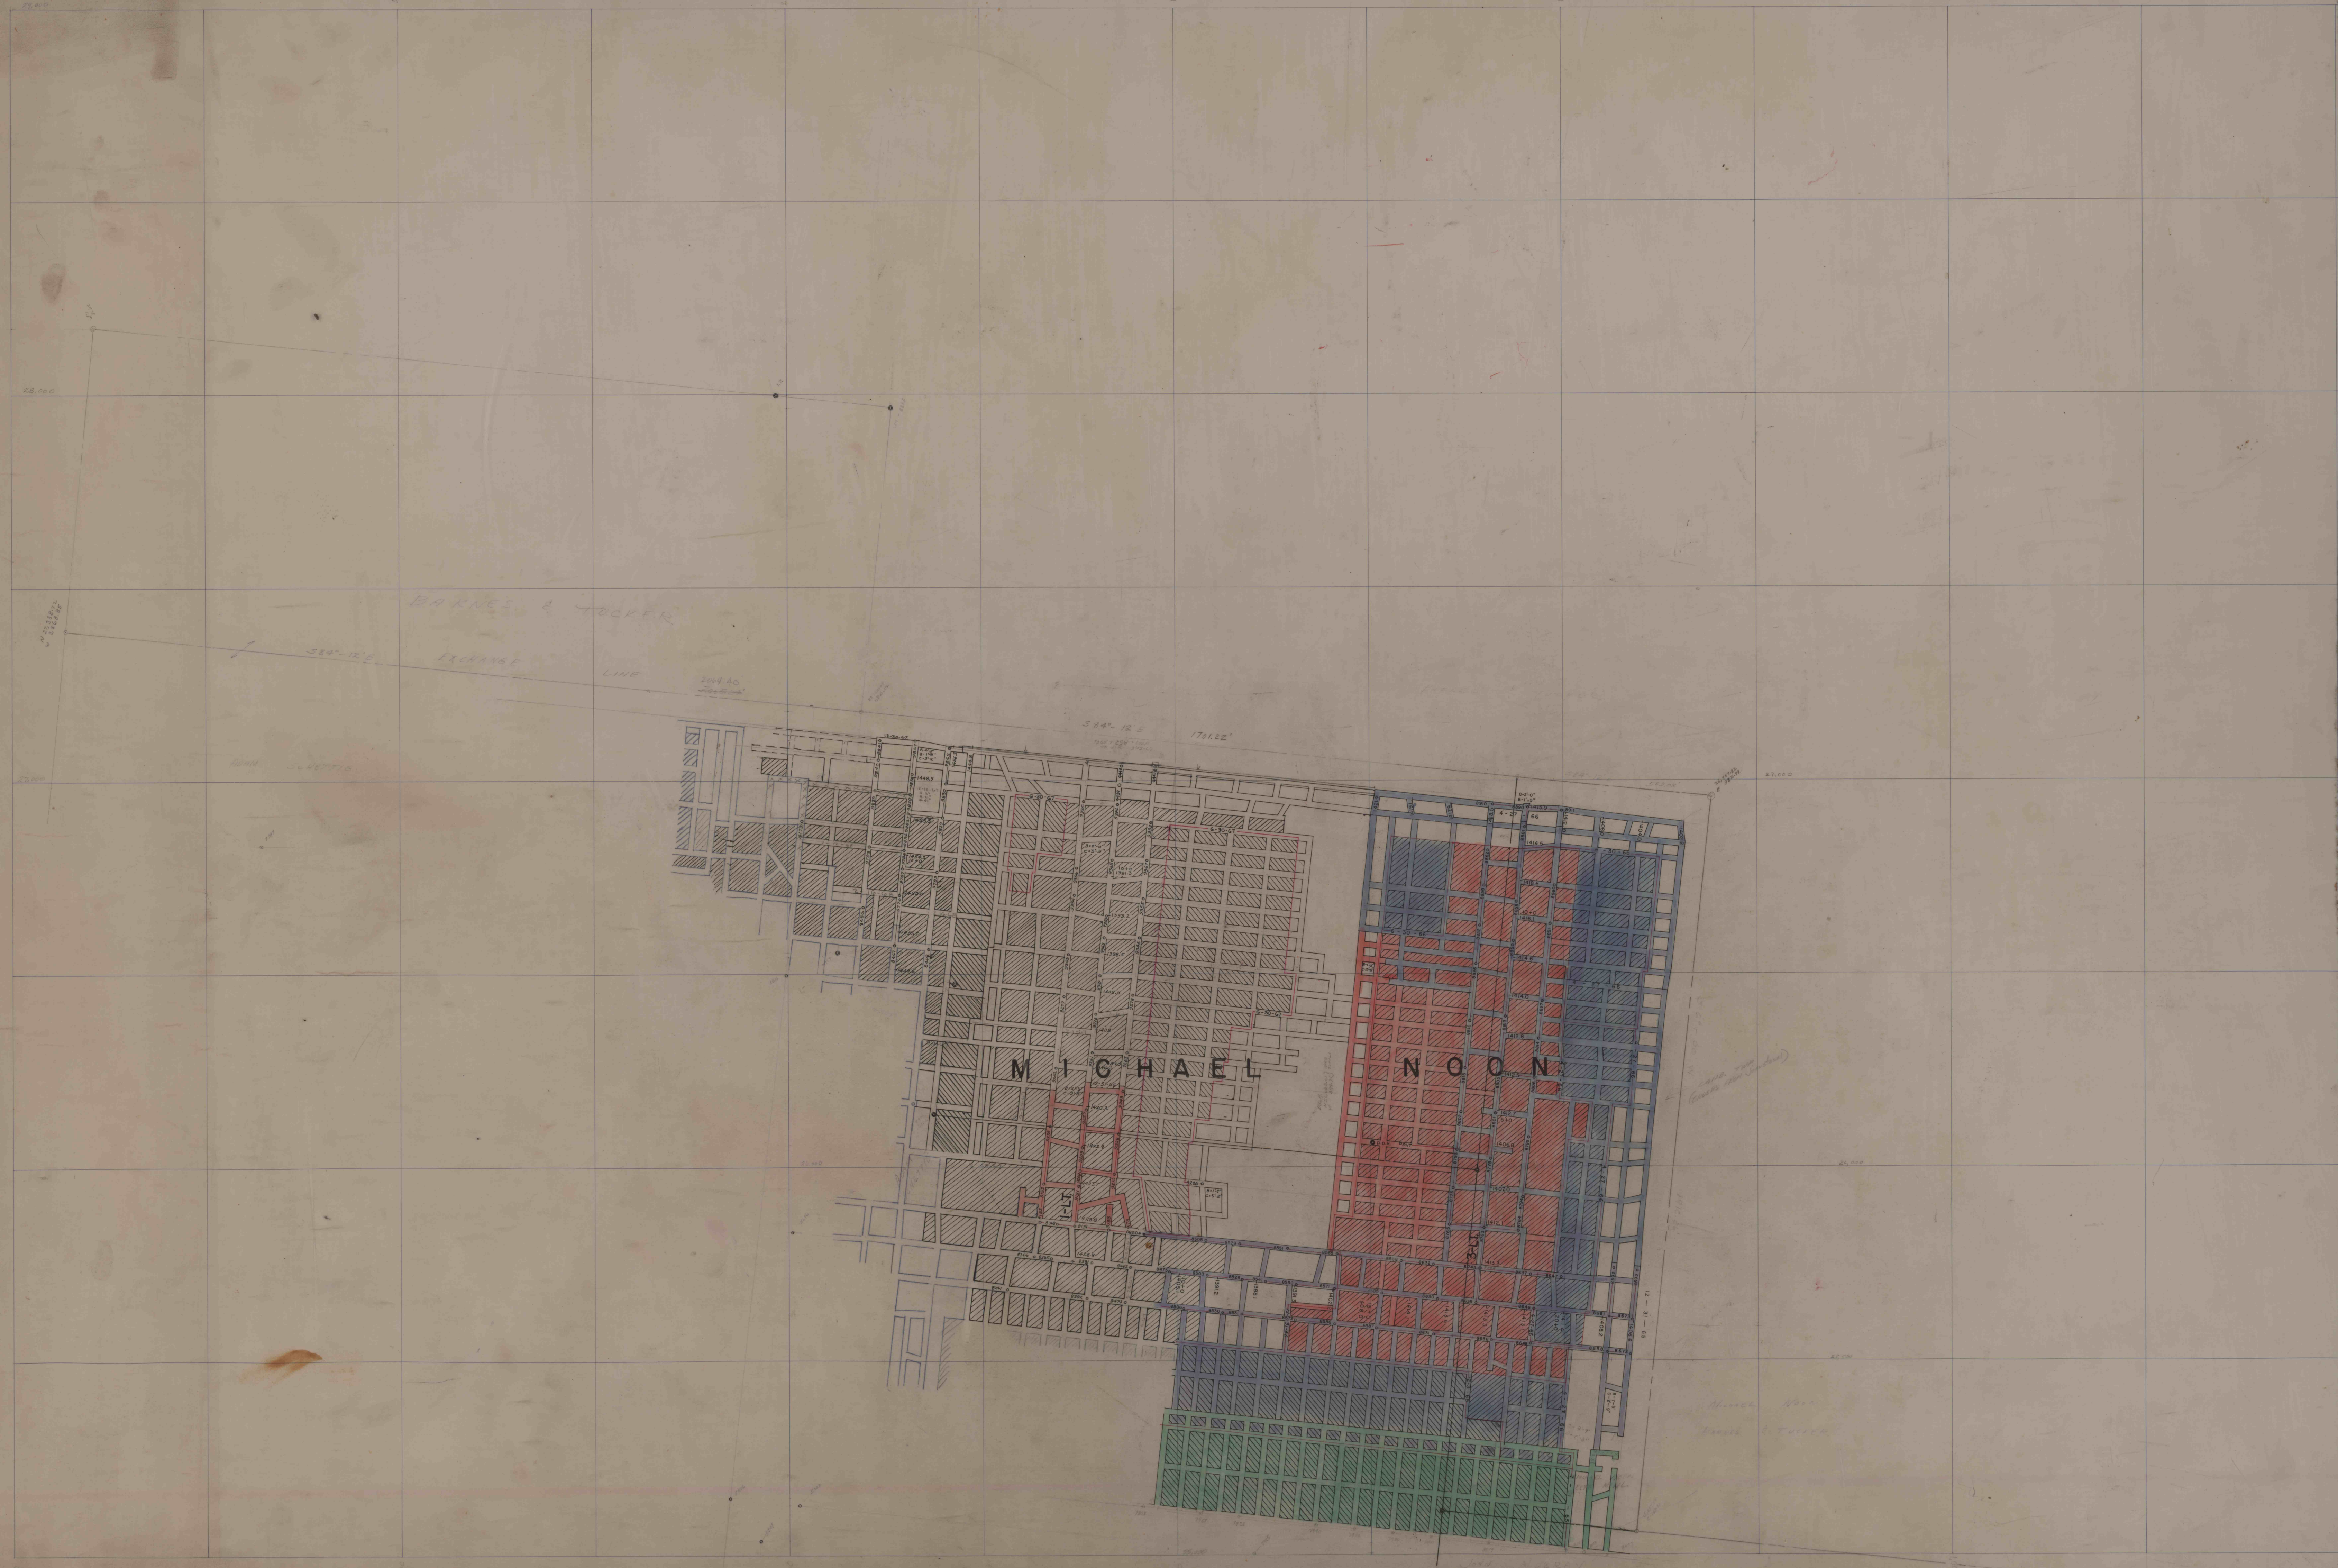

BARNES & TUCKER

EXCHANGE LINE

MICHAEL

NOON