


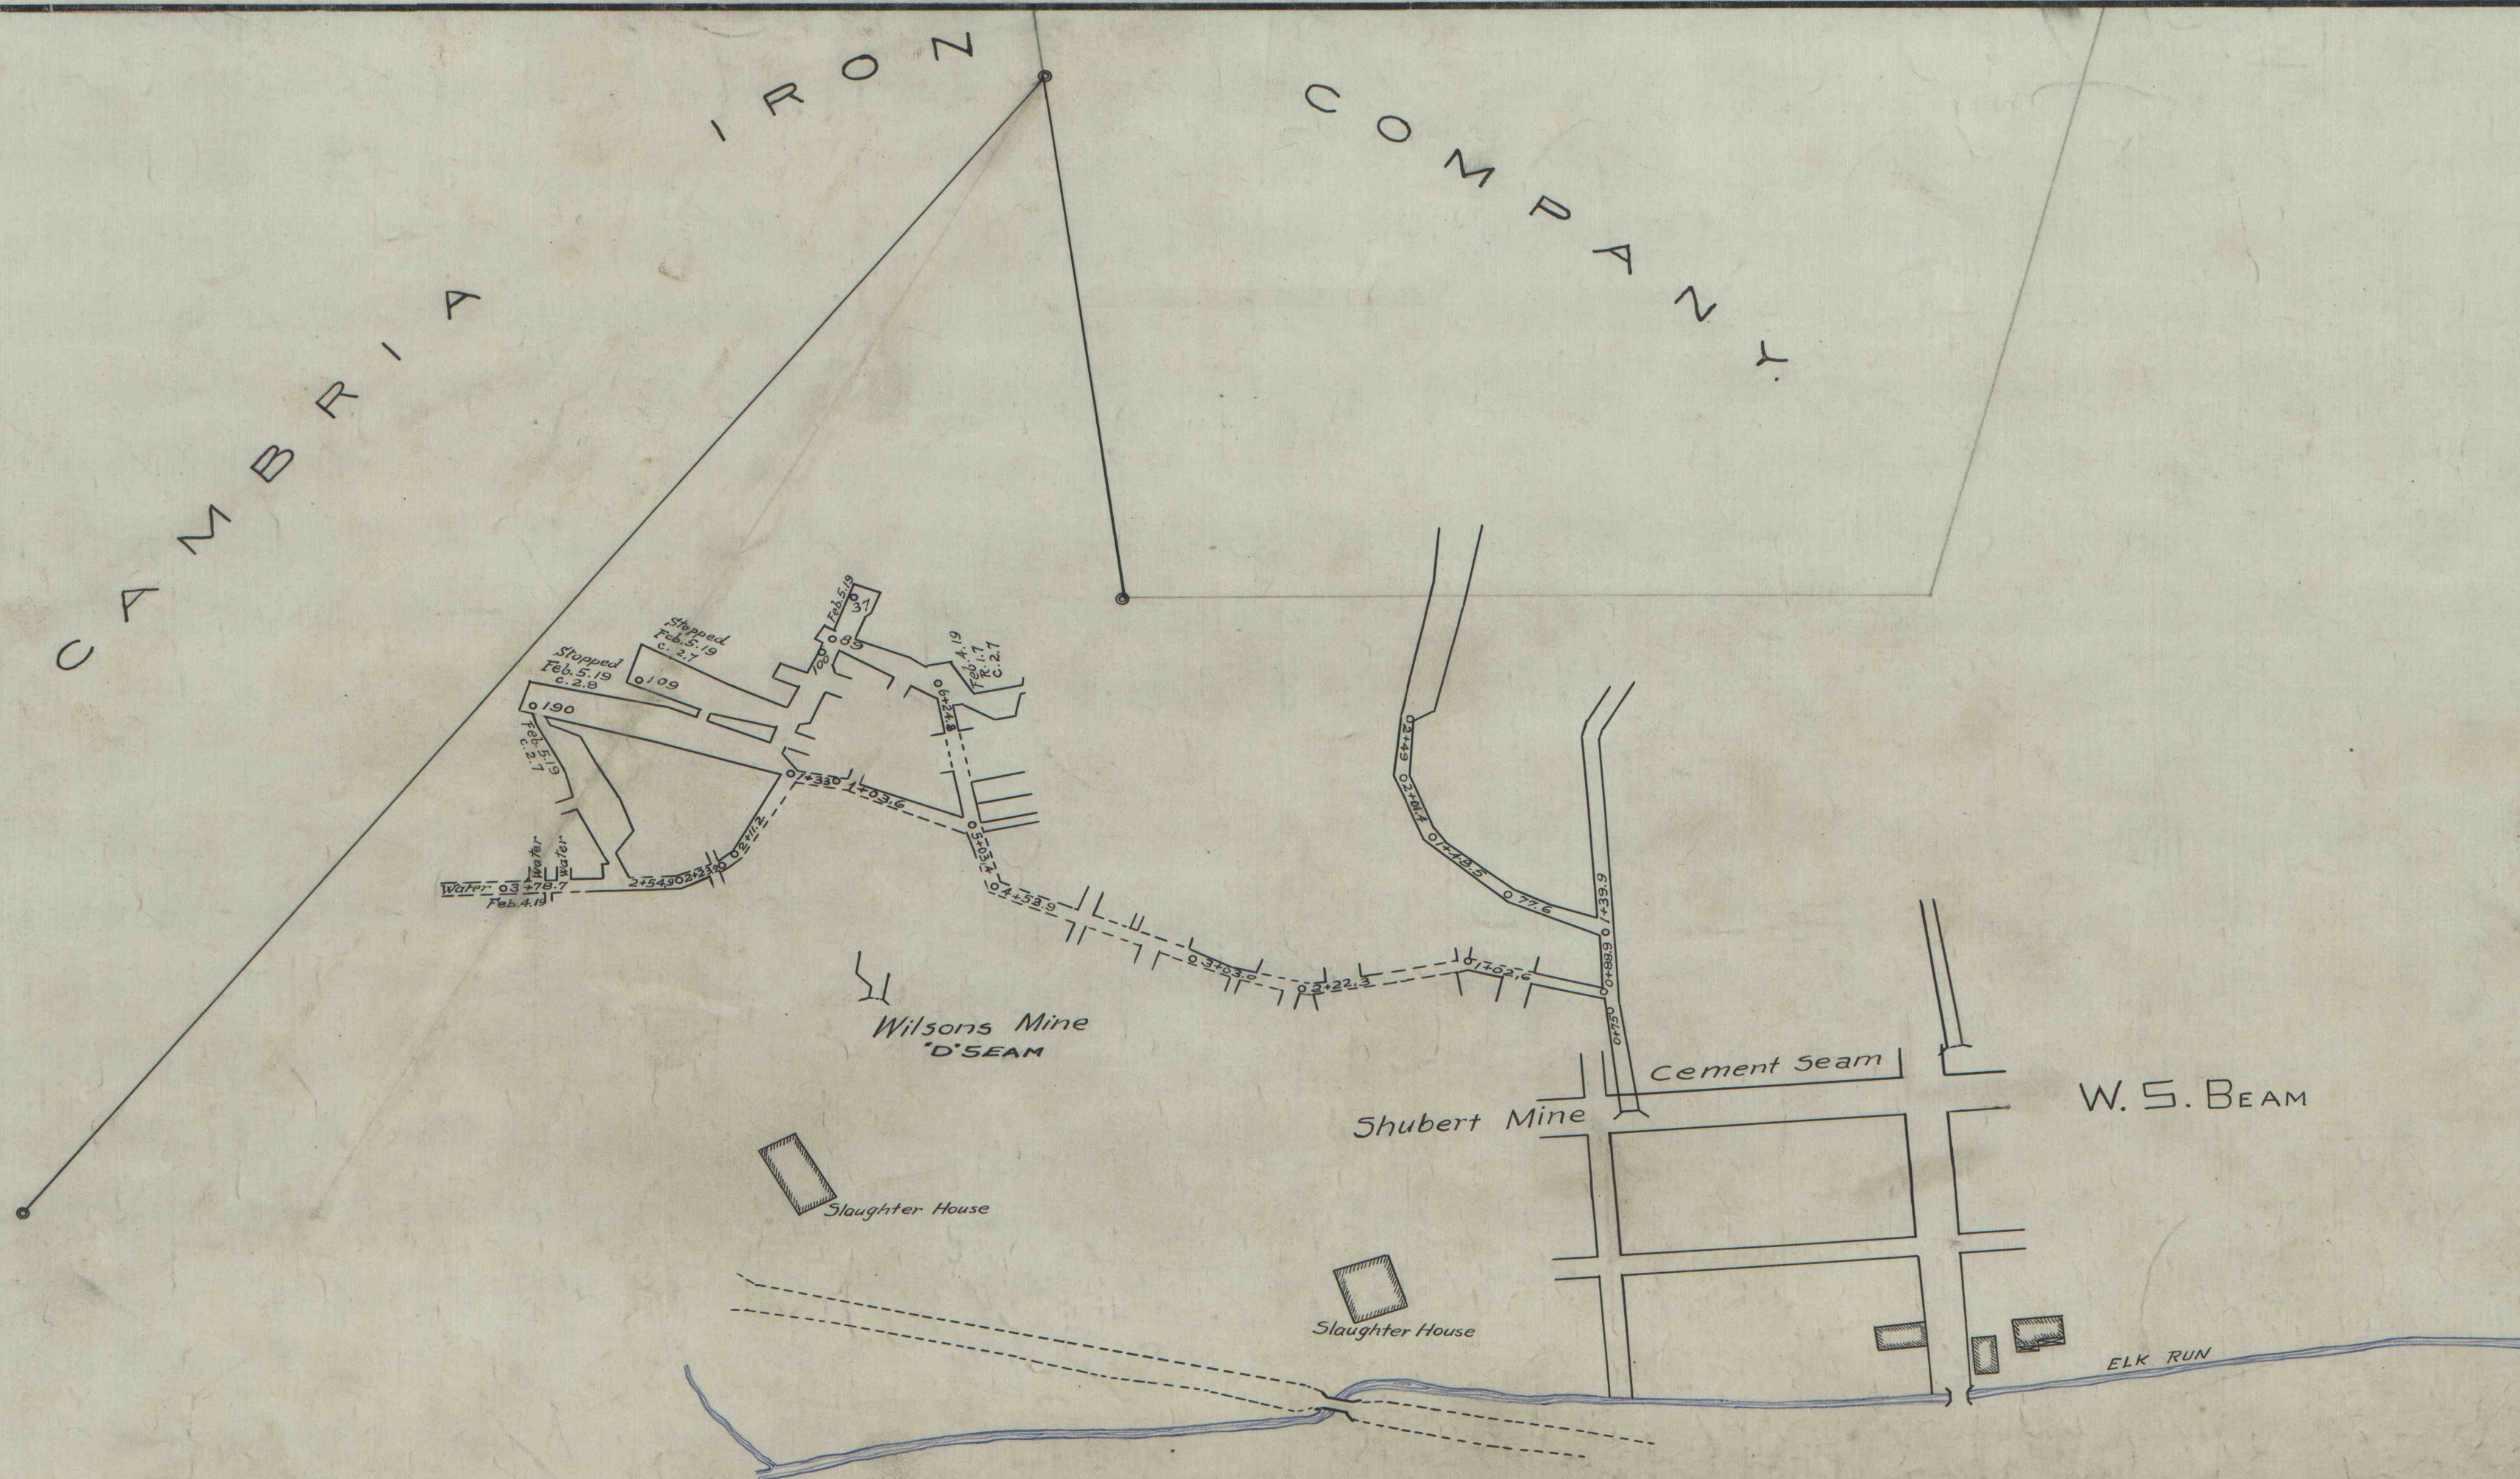

CAMBRIA STEEL CO.			
CIVIL ENGINEERING DEPT.			
JOHNSTOWN, PA.			
SHUBERT MINE			
CEMENT SEAM, SITUATE IN			
LOWER YODER TOWNSHIP			
CAMBRIA COUNTY PA.			
SCALE 1"=100'			
NOTE BOOKS			
REFERENCES 54-51A			
DATED	2-24-13		
DRAWN BY	E.G.		
TRACED BY	S.L.		
CHECKED BY	D.E.S.		
INDEX:			
52-A-199.			

D-9