


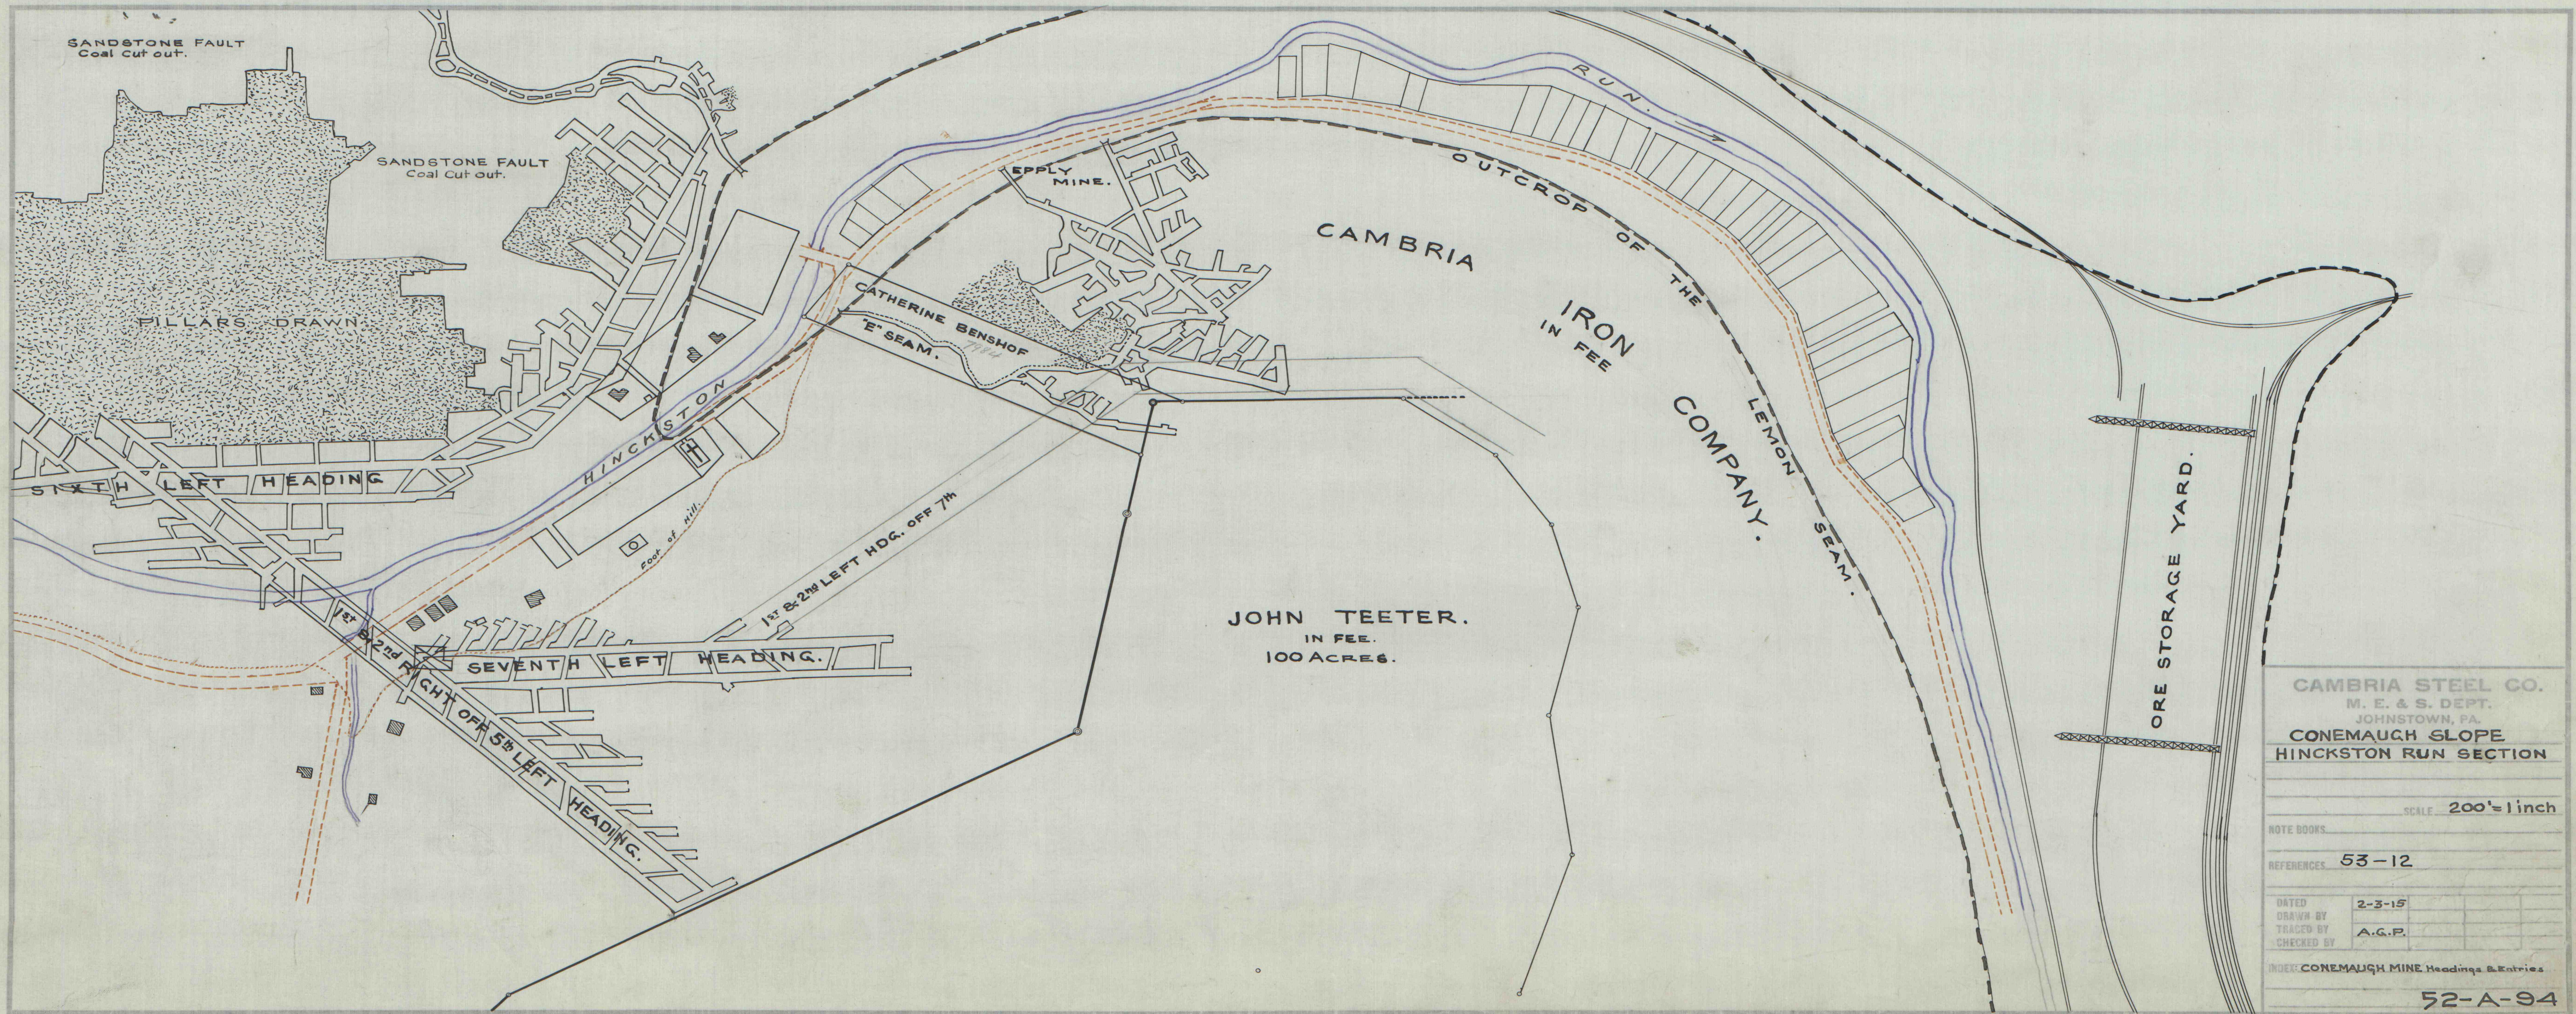

CAMBRIA STEEL CO.
M. E. & S. DEPT.
JOHNSTOWN, PA.
CONEMAUGH SLOPE
HINCHSTON RUN SECTION

SCALE 200' = 1 inch

NOTE BOOKS.

REFERENCES 53-12

DATED	2-3-15
DRAWN BY	A.G.P.
TRACED BY	
CHECKED BY	

INDEX: CONEMAUGH MINE Headings & Entries

52-A-94

D-9