


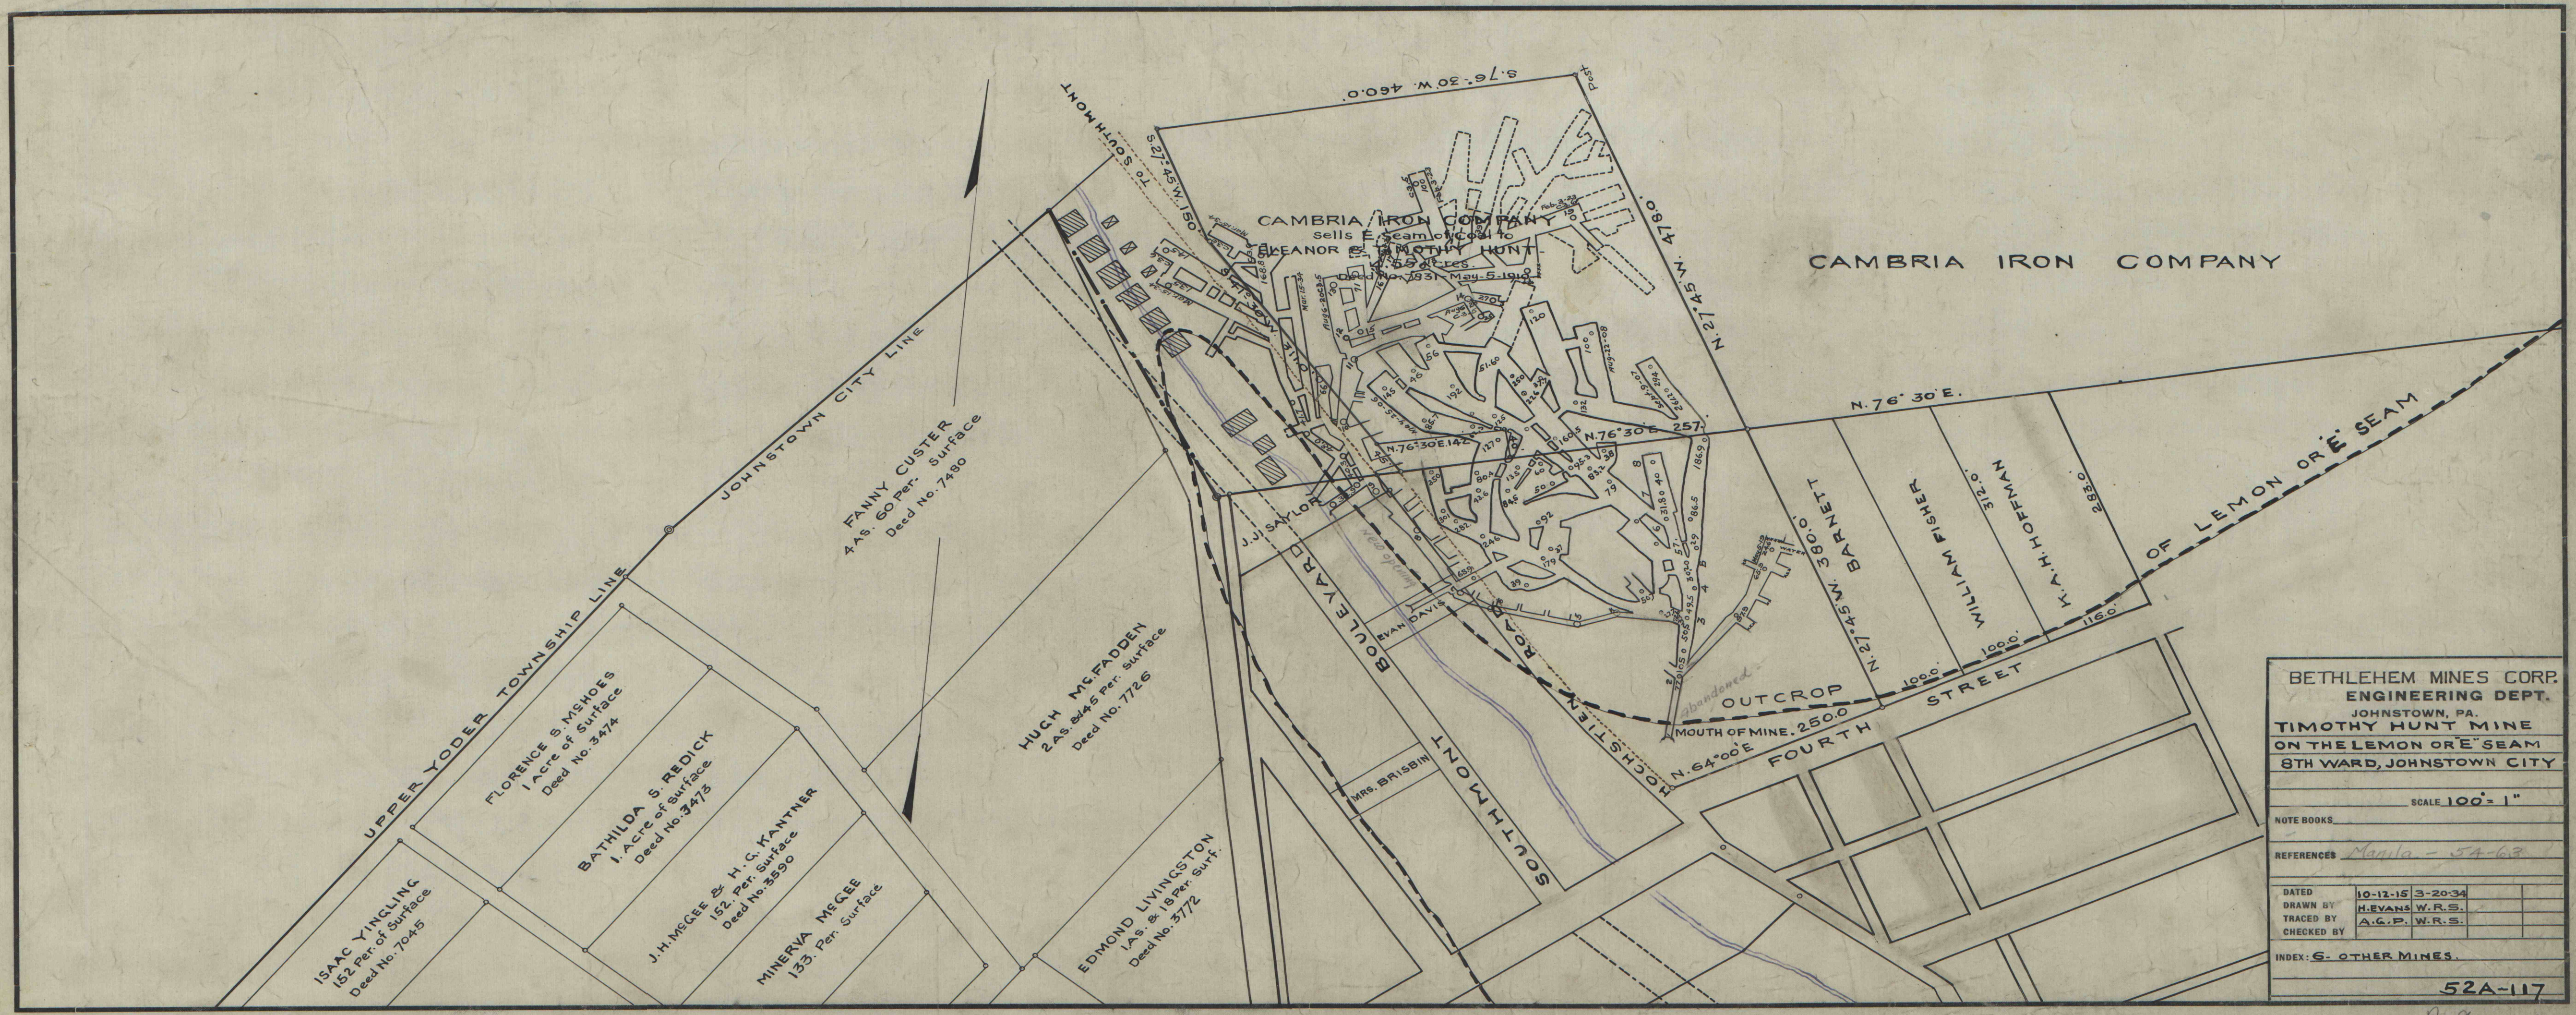

BETHLEHEM MINES CORP.
ENGINEERING DEPT.
JOHNSTOWN, PA.
TIMOTHY HUNT MINE
ON THE LEMON ORE SEAM
8TH WARD, JOHNSTOWN CITY

SCALE 100' = 1"

NOTE BOOKS

REFERENCES *Maple - 54-63*

DATED	10-12-15	3-20-34
DRAWN BY	H. EVANS	W. R. S.
TRACED BY	A. C. P.	W. R. S.
CHECKED BY		

INDEX: G. OTHER MINES.

52A-117