


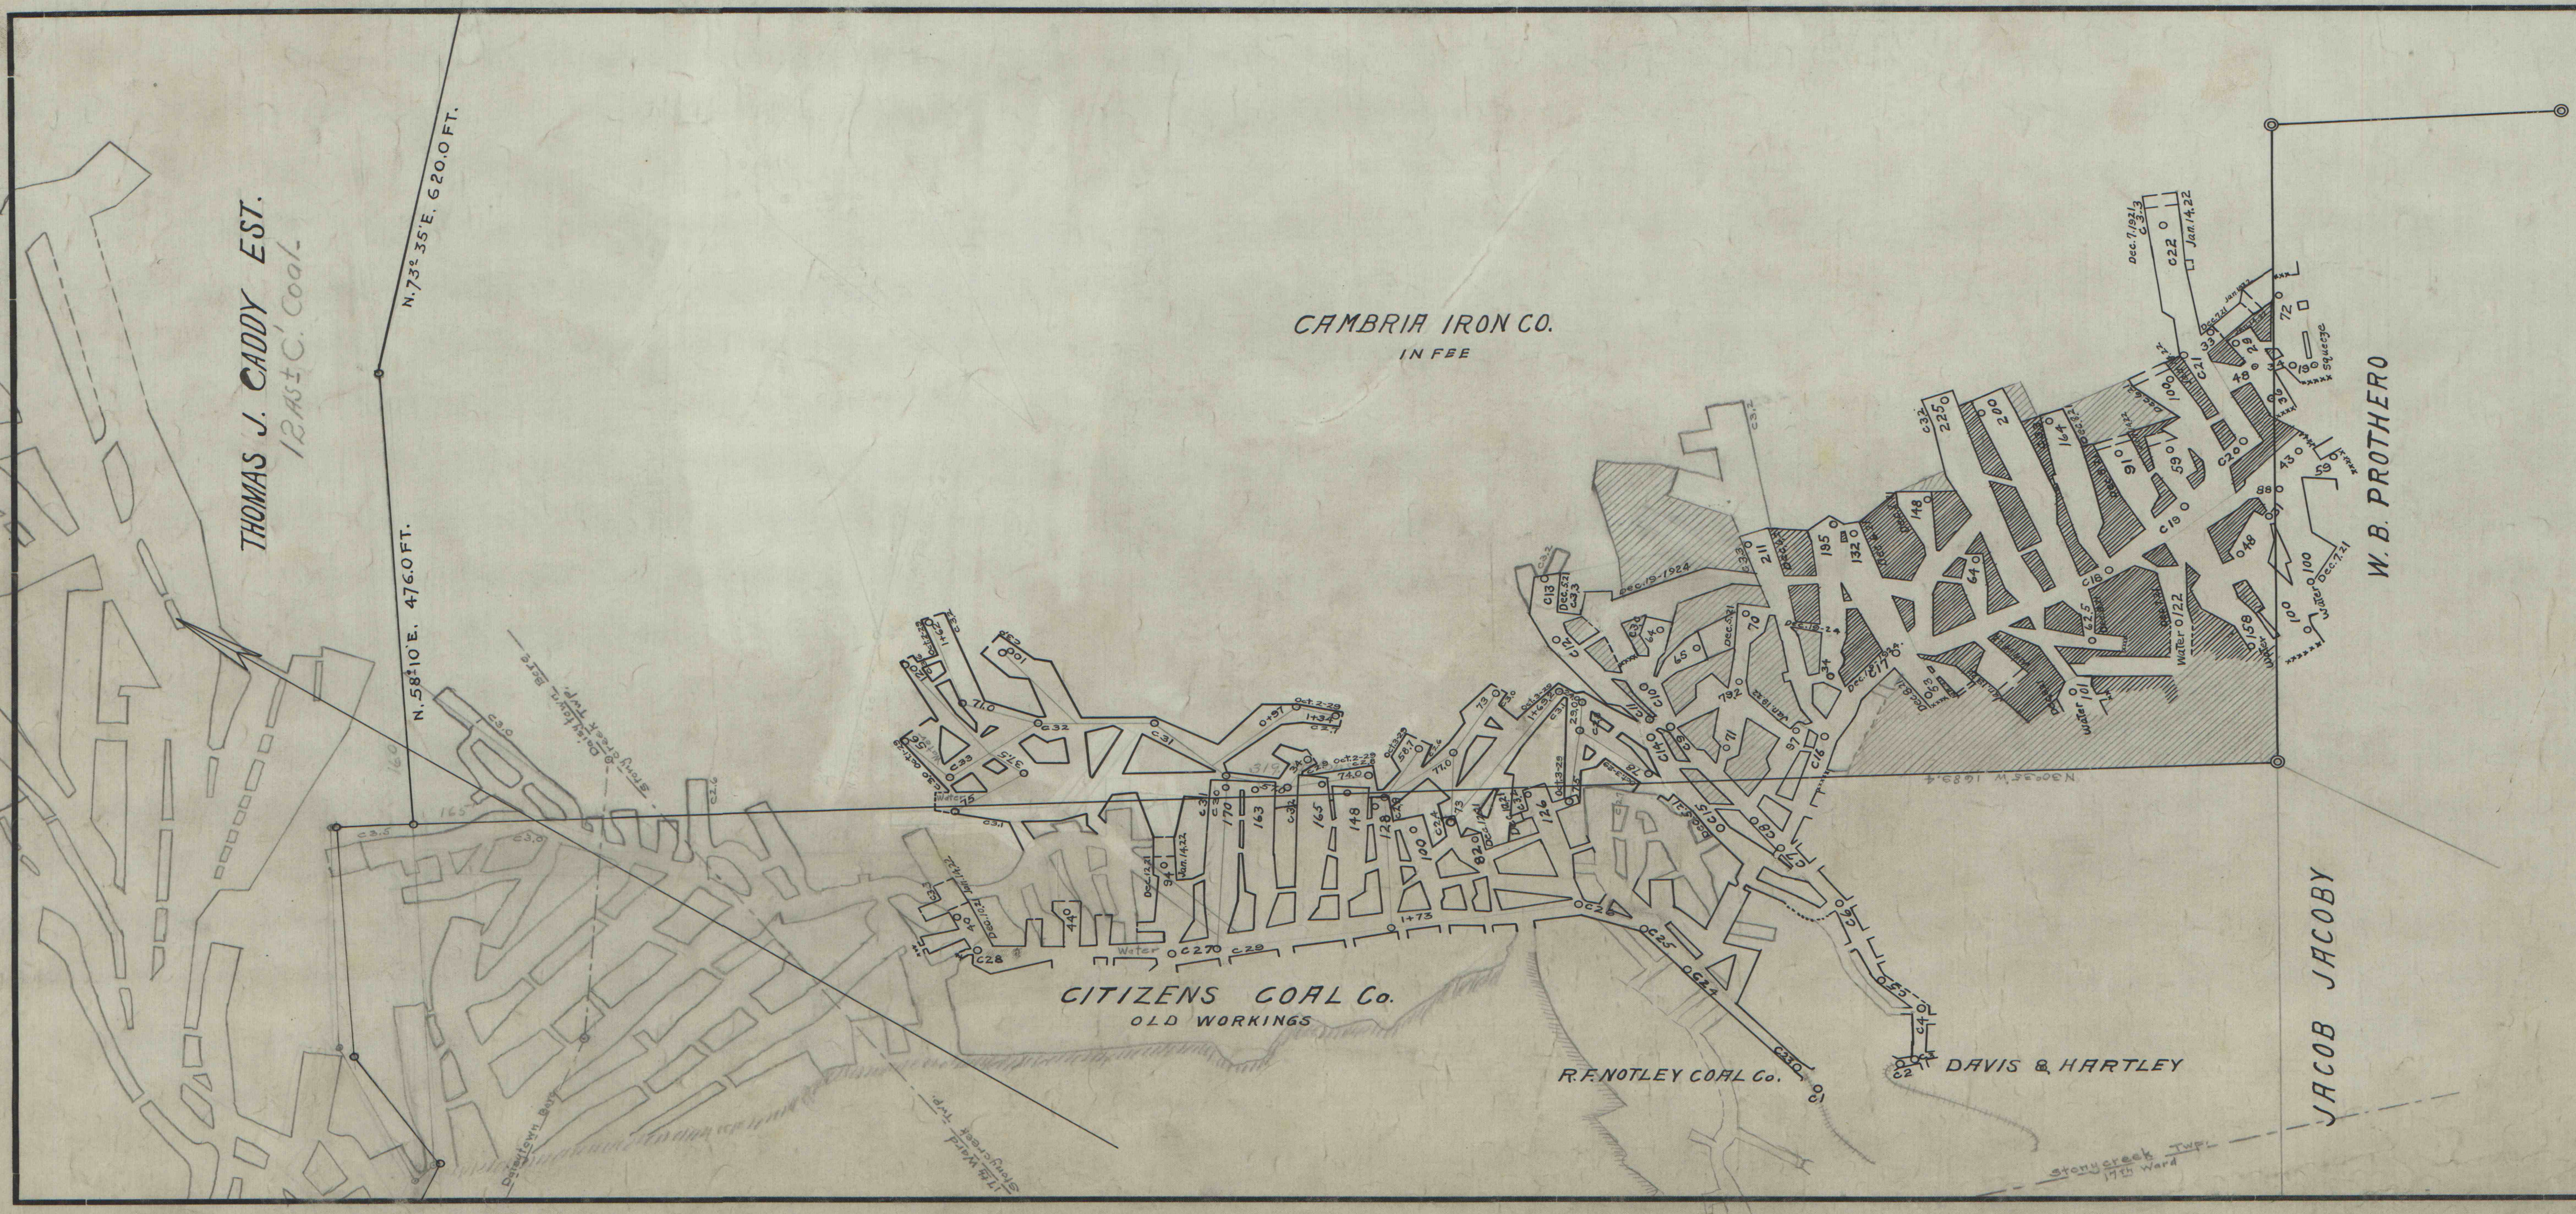

CAMBRIA STEEL CO.			
CIVIL ENGINEERING DEPT.			
JOHNSTOWN, PA.			
MAP SHOWING ENCROACHMENT			
OF DAVIS & HARTLEY AND			
R.F. NOTLEY COAL Co. ON PROP-			
ERTY OF CAMBRIA IRON Co.			
SCALE 1/IN = 100 FT.			
NOTE BOOKS			
REFERENCES			
DATED		12-19-24	
DRAWN BY	G.A.P.	A.G.P.	
TRACED BY	G.R.J. Feb 7, 22		
CHECKED BY	G.R.J.		
INDEX:			
52-A-217			