


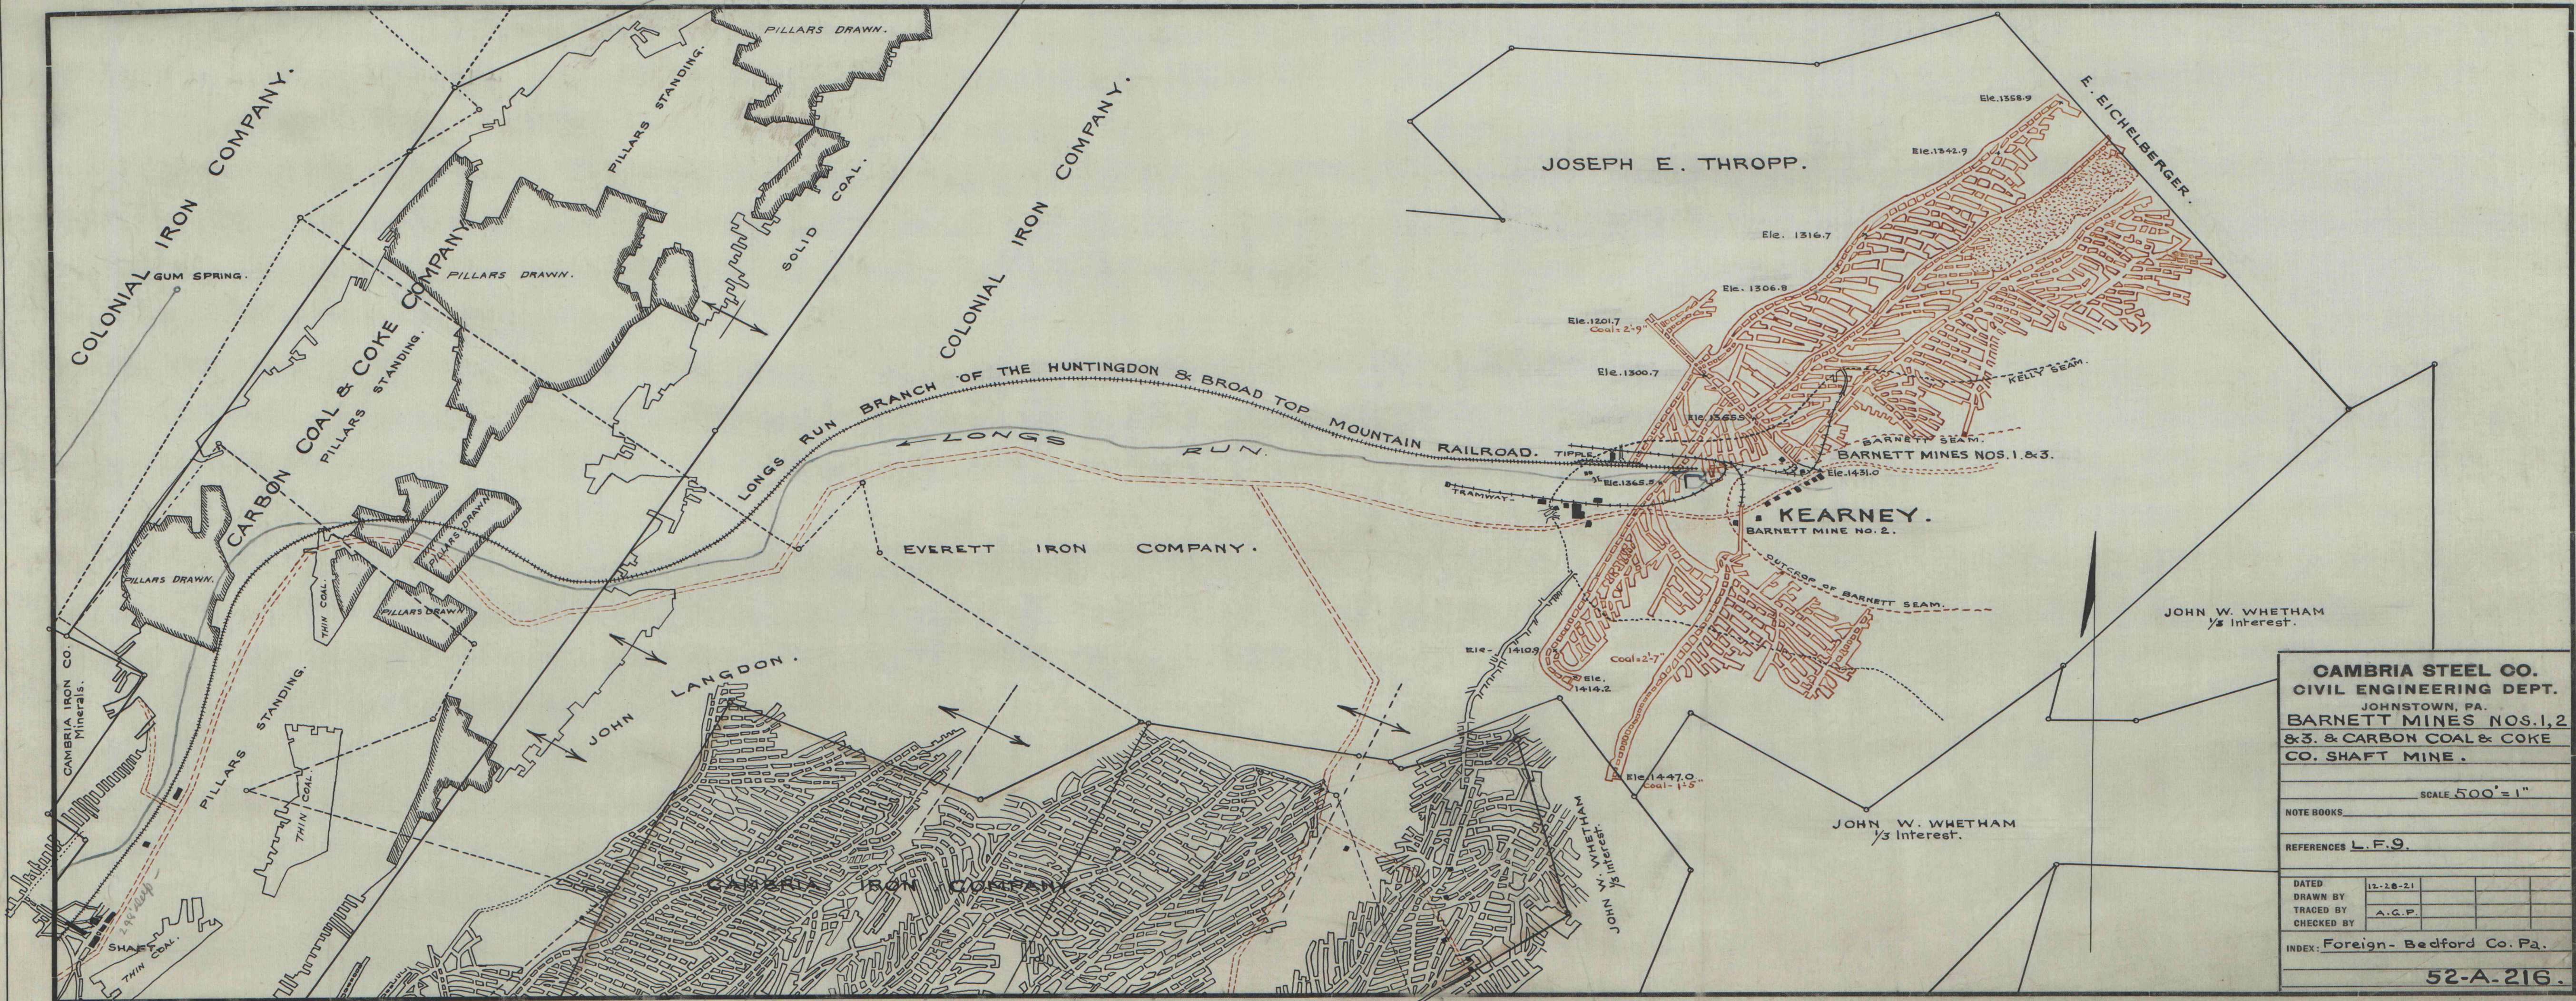

CAMBRIA STEEL CO.
CIVIL ENGINEERING DEPT.
JOHNSTOWN, PA.
**BARNETT MINES NOS. 1, 2
& 3. & CARBON COAL & COKE
CO. SHAFT MINE.**

SCALE 500' = 1"

NOTE BOOKS

REFERENCES L.F. 9.

DATED	12-28-21		
DRAWN BY			
TRACED BY	A.G.P.		
CHECKED BY			

INDEX: Foreign - Bedford Co. Pa.

52-A-216.

D-9