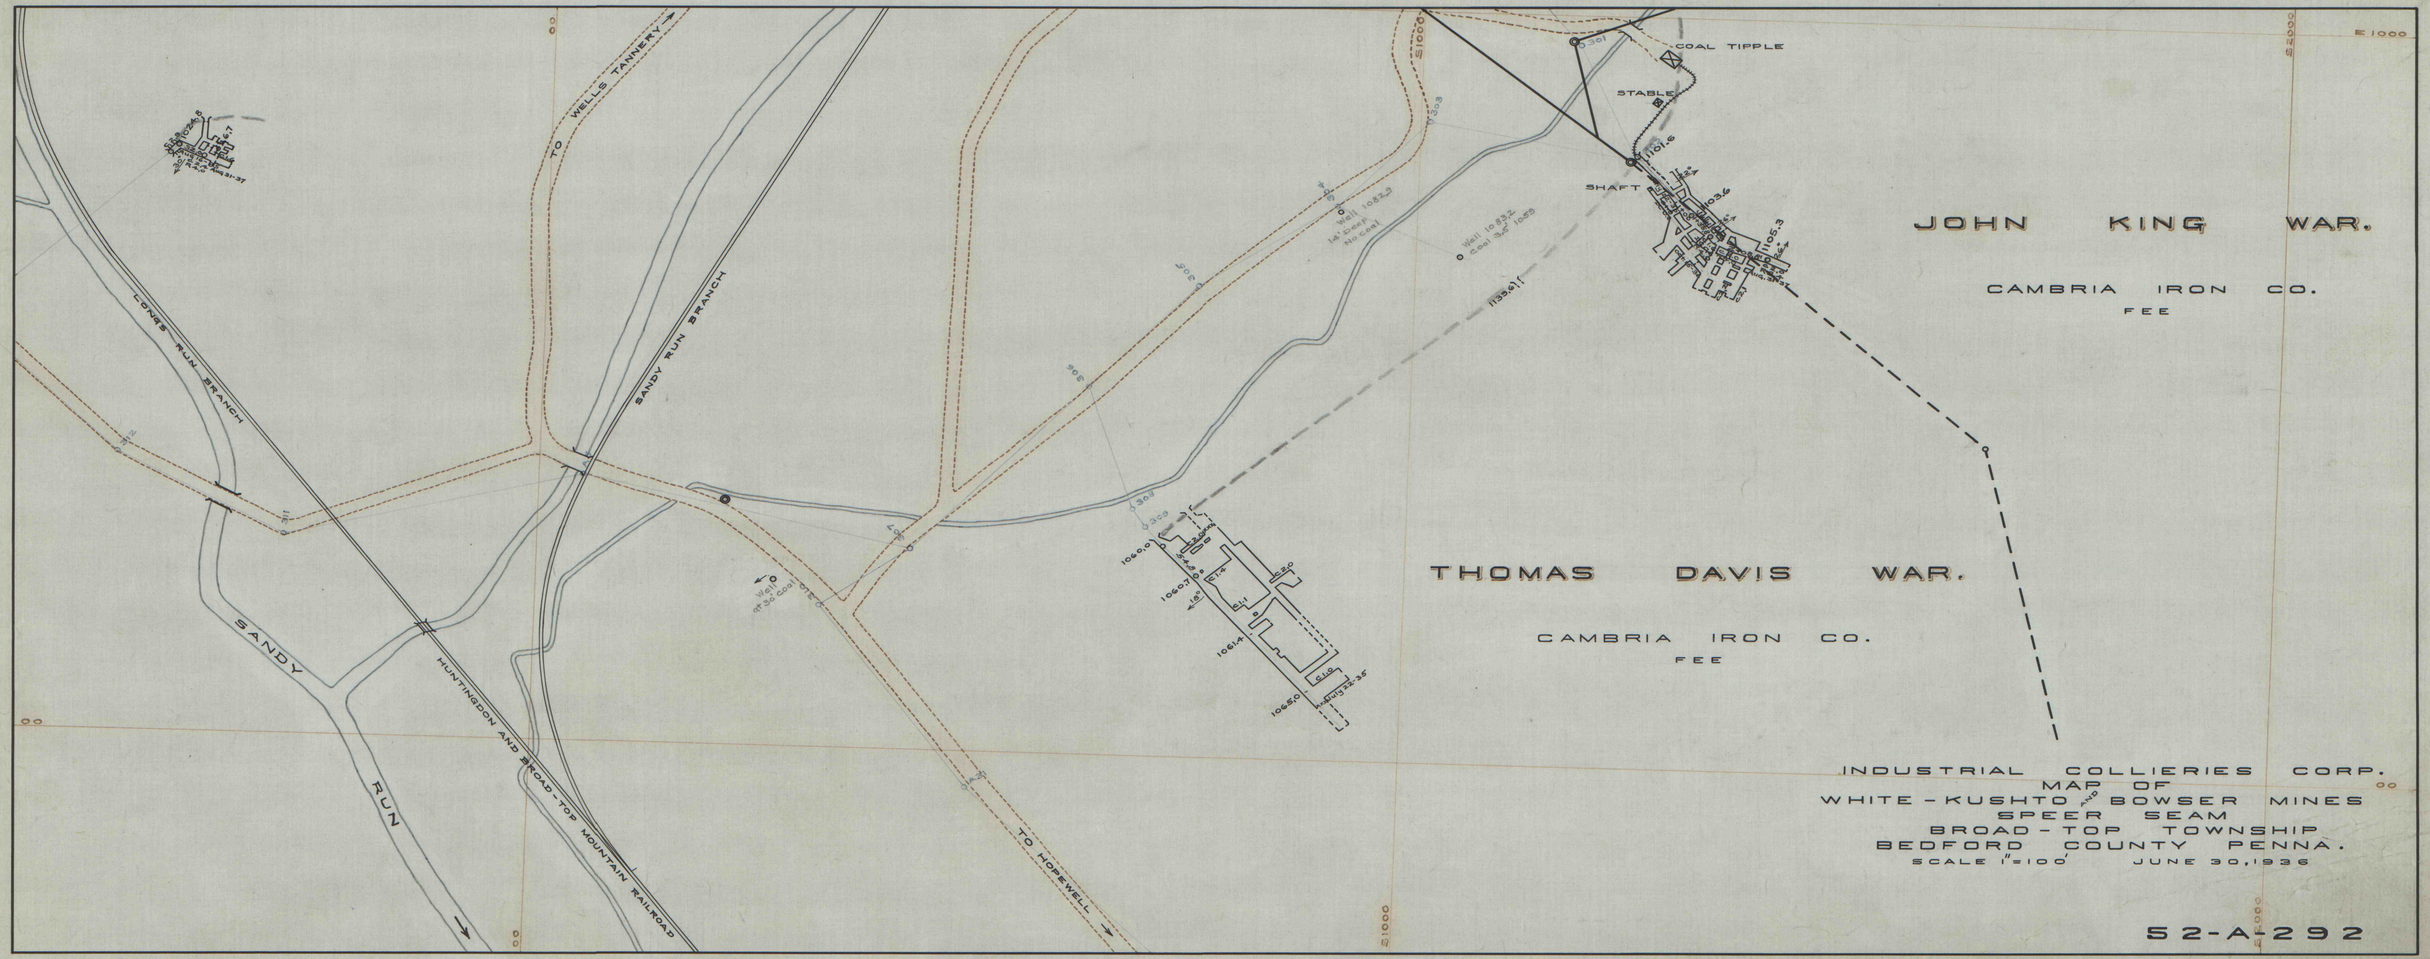
JOHN KING WAR.
CAMBRIA IRON CO.
FEE
THOMAS DAVIS WAR.
CAMBRIA IRON CO.
FEE
COAL TIPPLE
STABLE
SHAFT
TO WELLS TANNERY
SANDY RUN BRANCH
LONGS RUN BRANCH
SANDY RUN
HUNTINGDON AND BROAD-TOP MOUNTAIN RAILROAD
TO HOPEWELL
INDUSTRIAL COLLIERIES CORP.
MAP OF
WHITE-KUSHTO AND BOWSER MINES
SPEER SEAM
BROAD-TOP TOWNSHIP
BEDFORD COUNTY PENNA.
SCALE 1"=100' JUNE 30, 1936
52-A-292

D-9