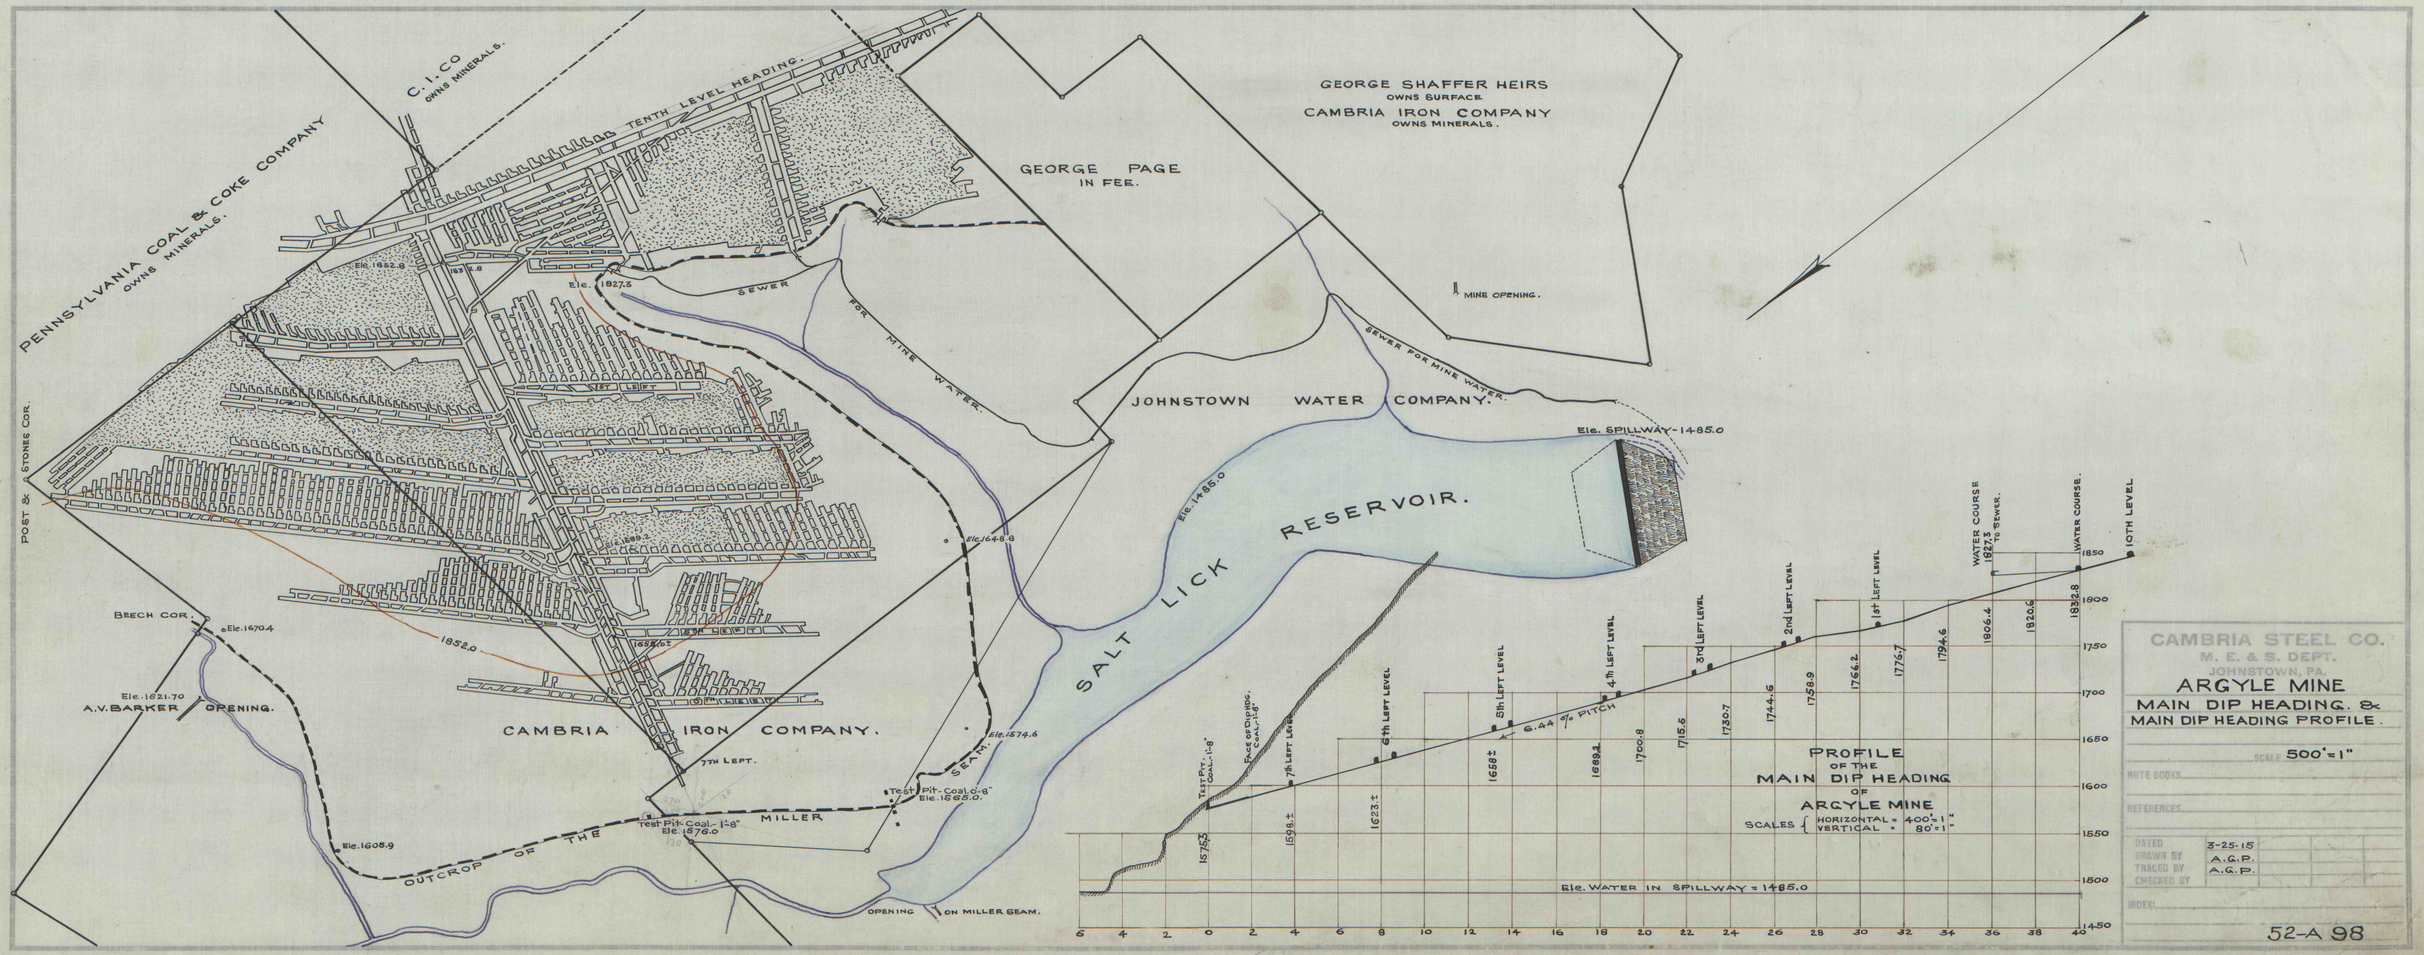

CAMBRIA STEEL CO.
M. E. & S. DEPT.
JOHNSTOWN, PA.

ARGYLE MINE
MAIN DIP HEADING &
MAIN DIP HEADING PROFILE.

SCALE 500'=1"

NOTE BOOKS

REFERENCES

DATED	3-25-15			
DRAWN BY	A.G.P.			
TRACED BY	A.G.P.			
CHECKED BY				

INDEX

52-A 98

0-9