


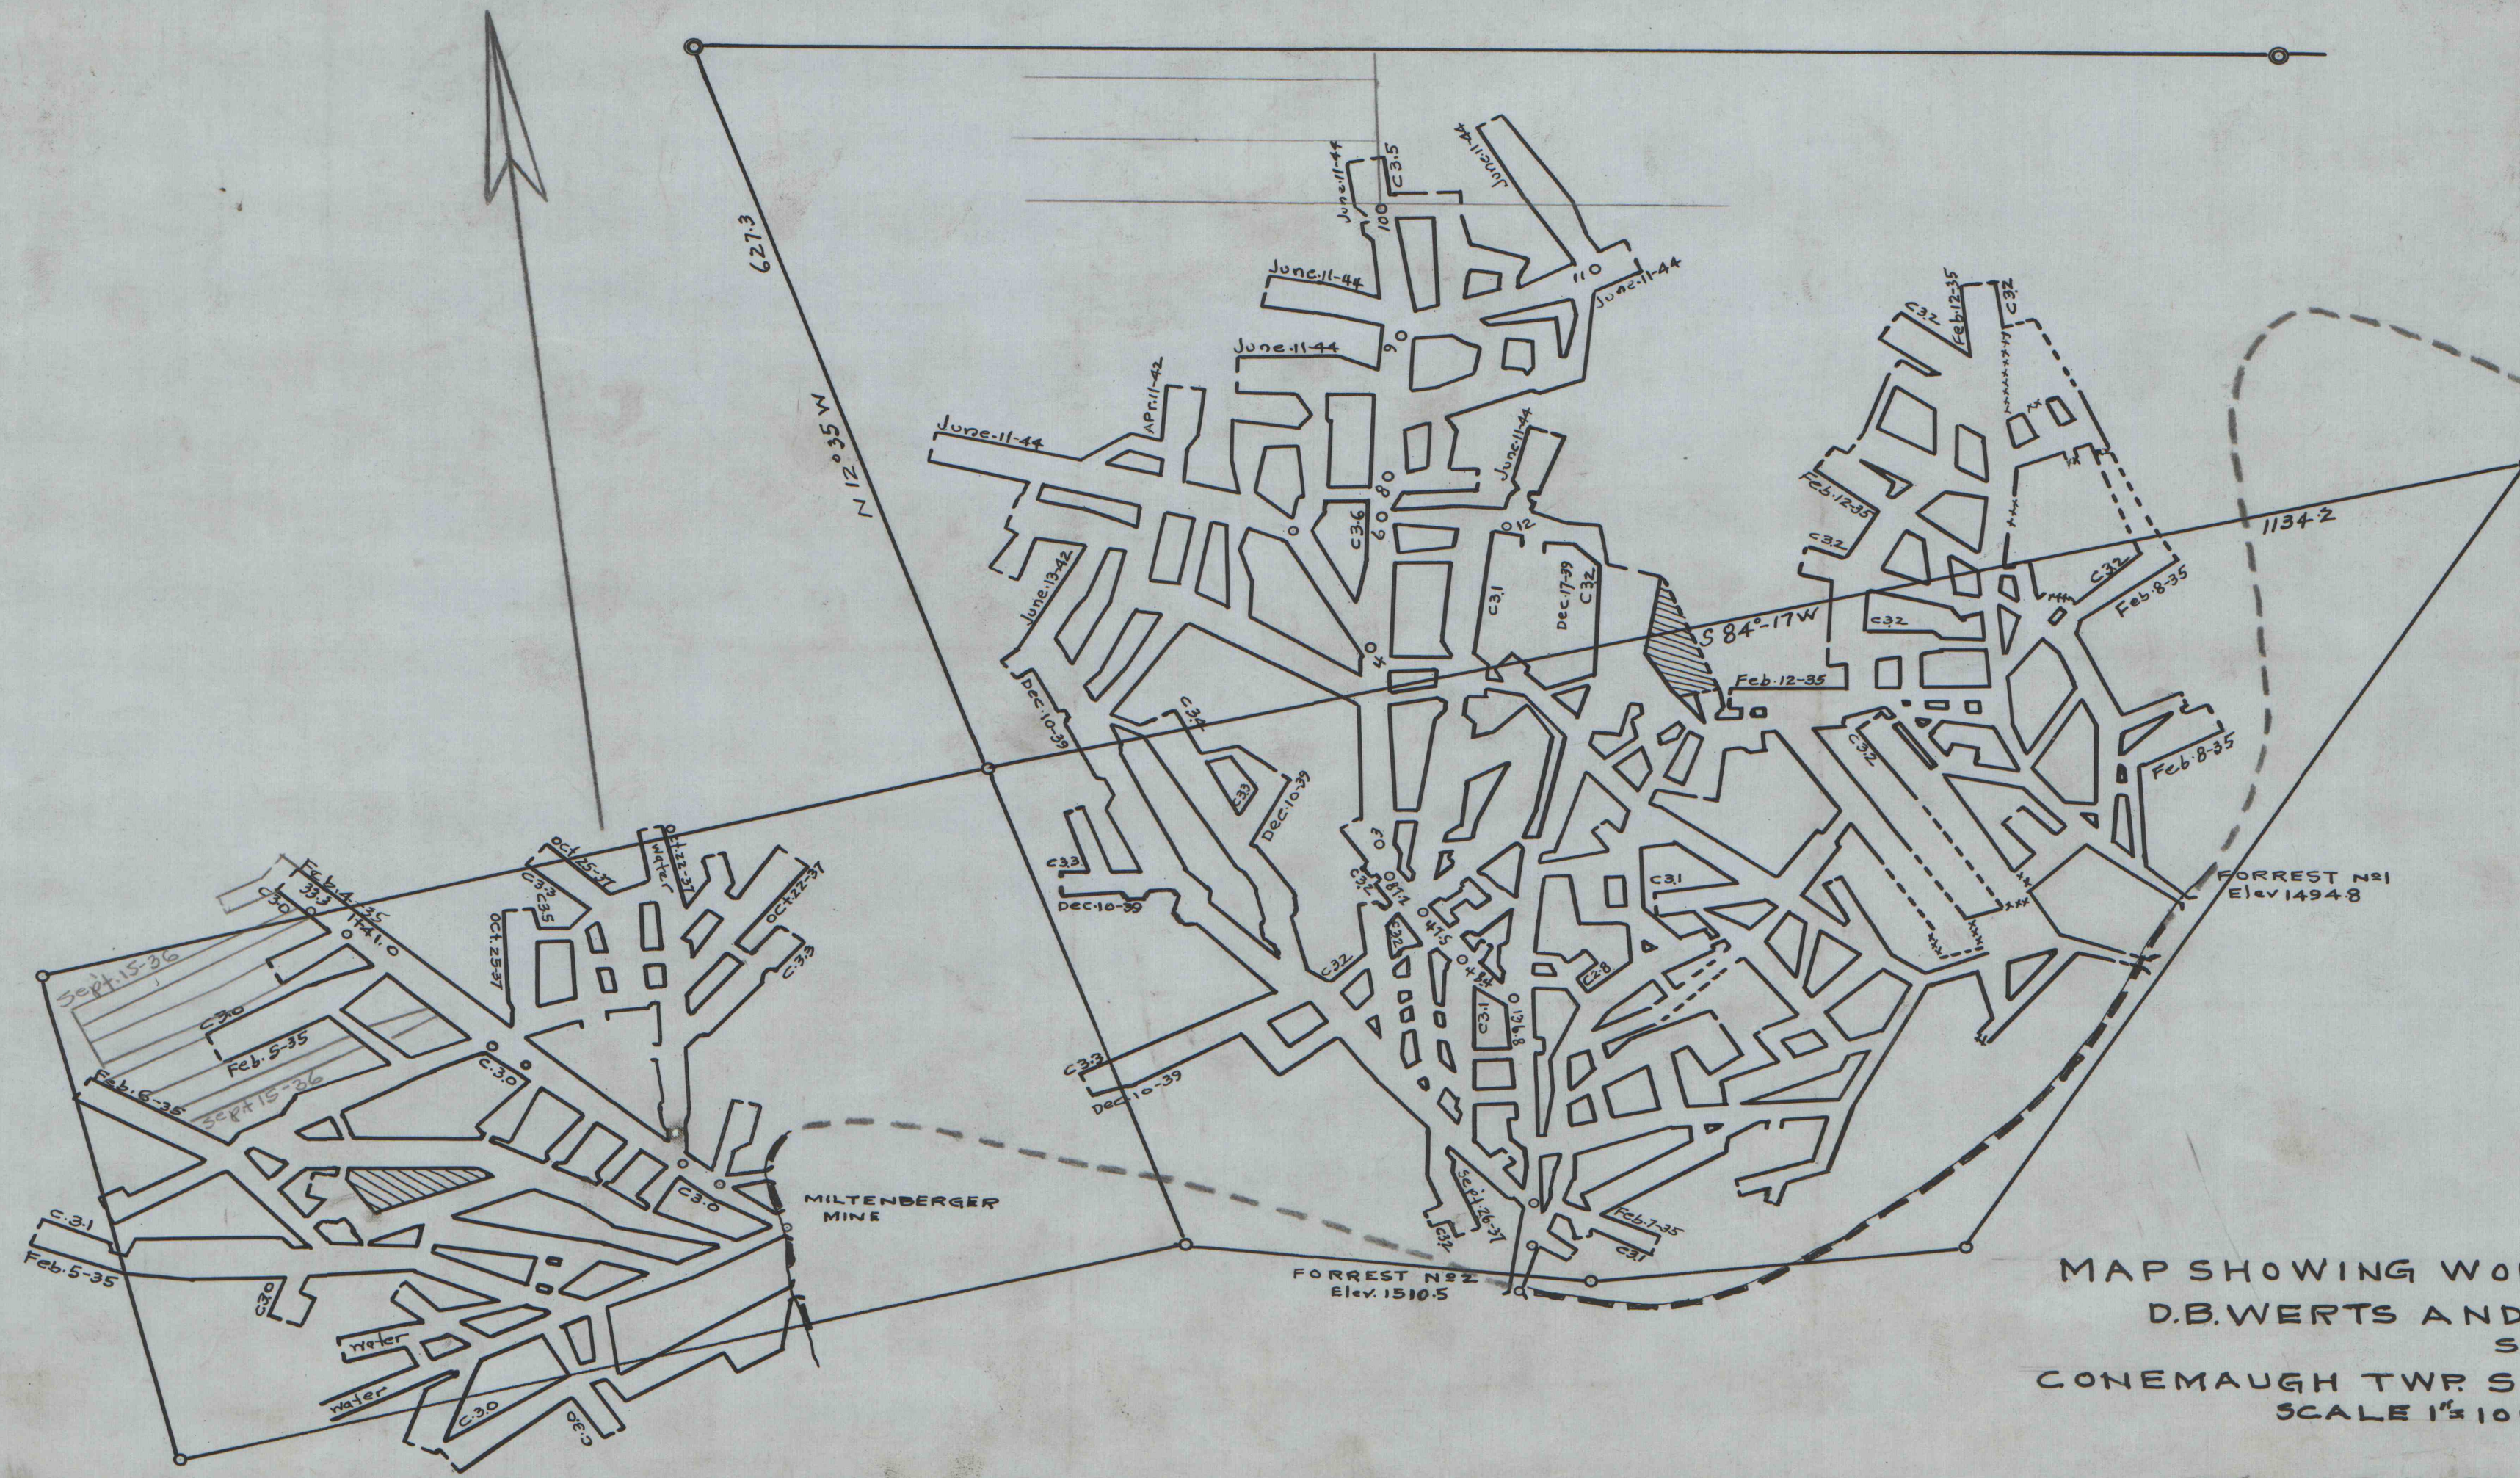

MAP SHOWING WORKINGS IN CEMENT SEAM
D.B. WERTS AND JOHN FORREST RESERVE
SITUATE
CONEMAUGH TWP. SOMERSET COUNTY PENNA.
SCALE 1"=100' NOV. 12-1945