


BETHLEHEM STEEL PRODUCTS CO.
OWNS COAL.

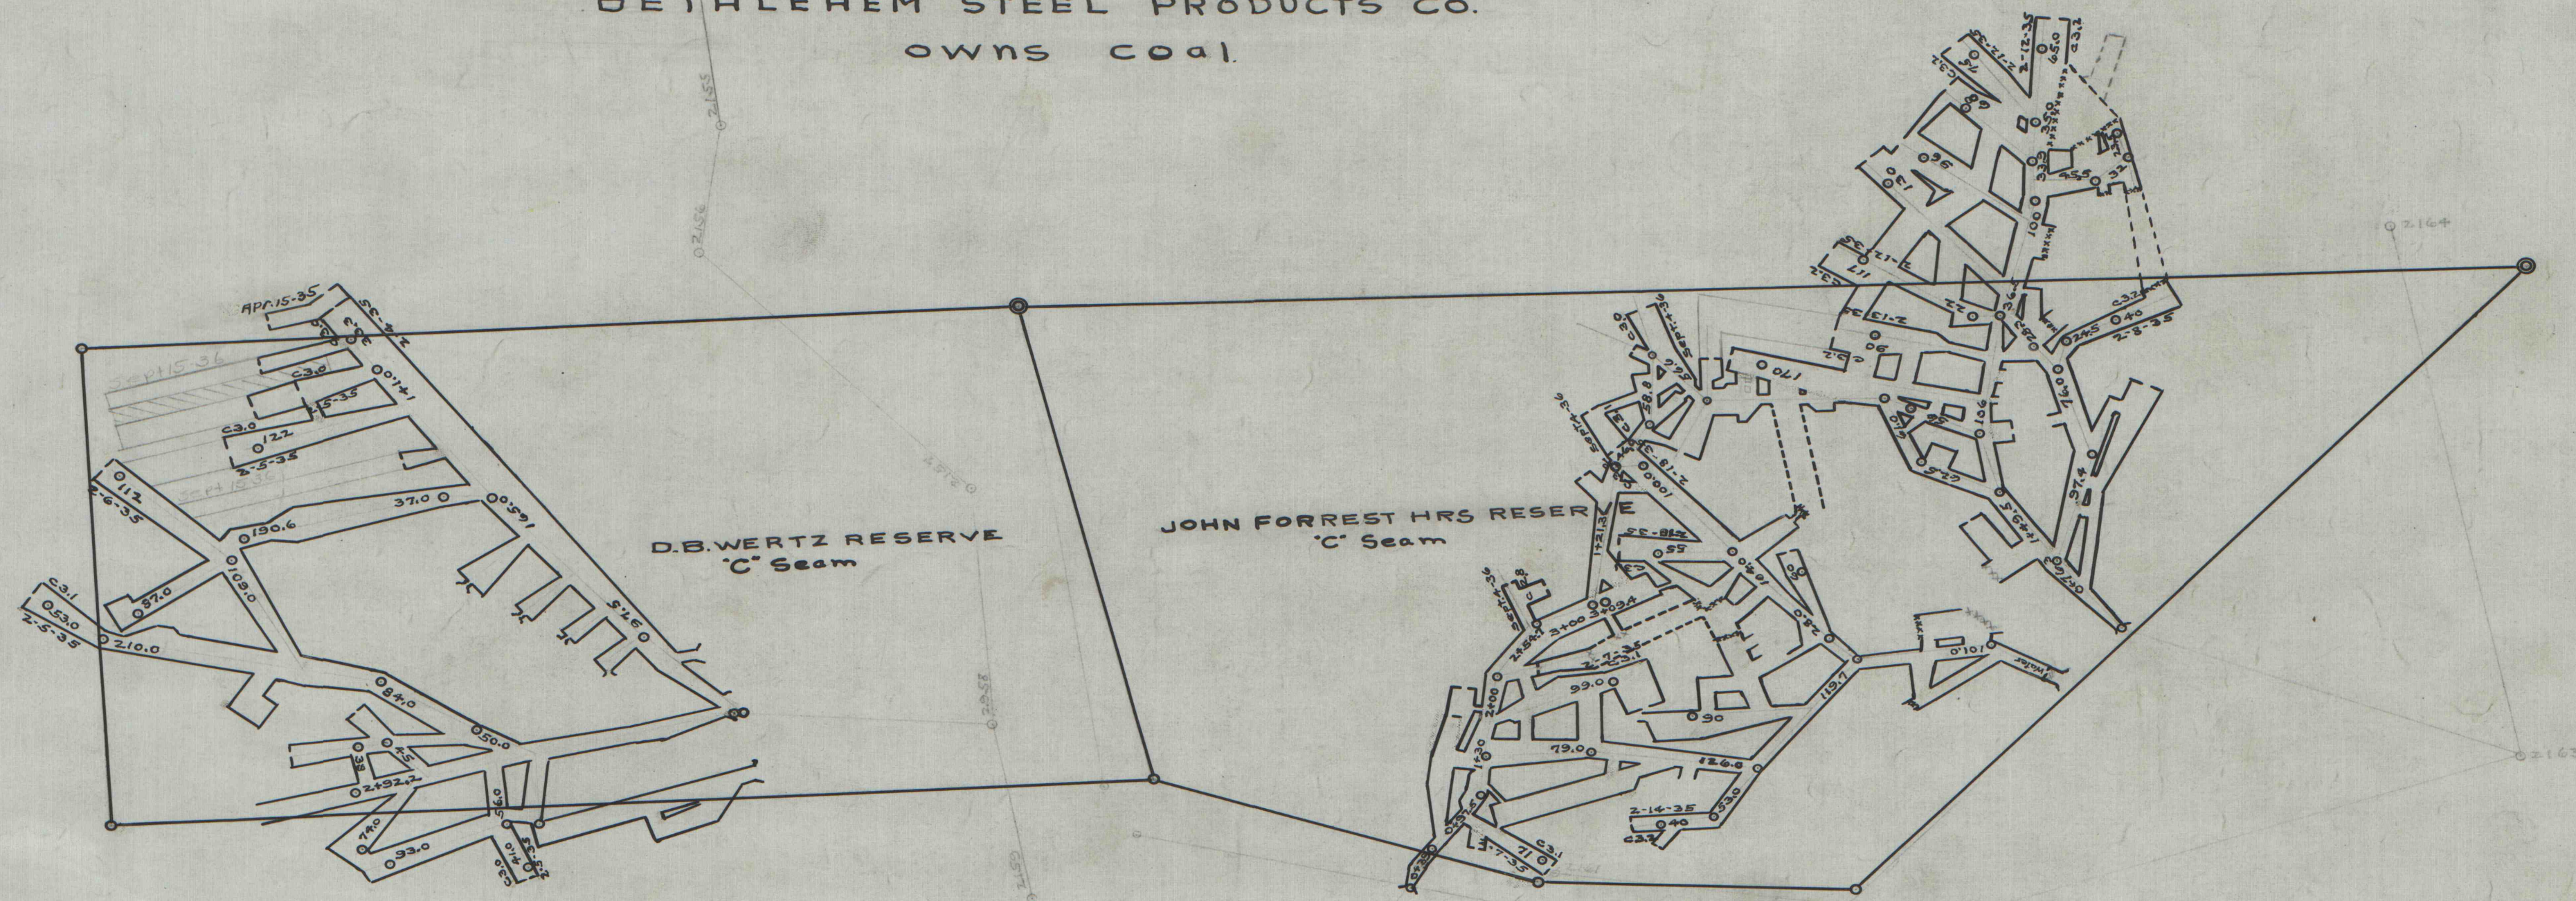

MAP SHOWING WORKINGS IN CEMENT SEAM
D.B. WERTZ AND JOHN FORREST RESERVE
SITUATE
CONEMAUGH TWP SOMERSET COUNTY PENNA.
SCALE 1"=100' APRIL-10-1935.

52-A-276

D-9