


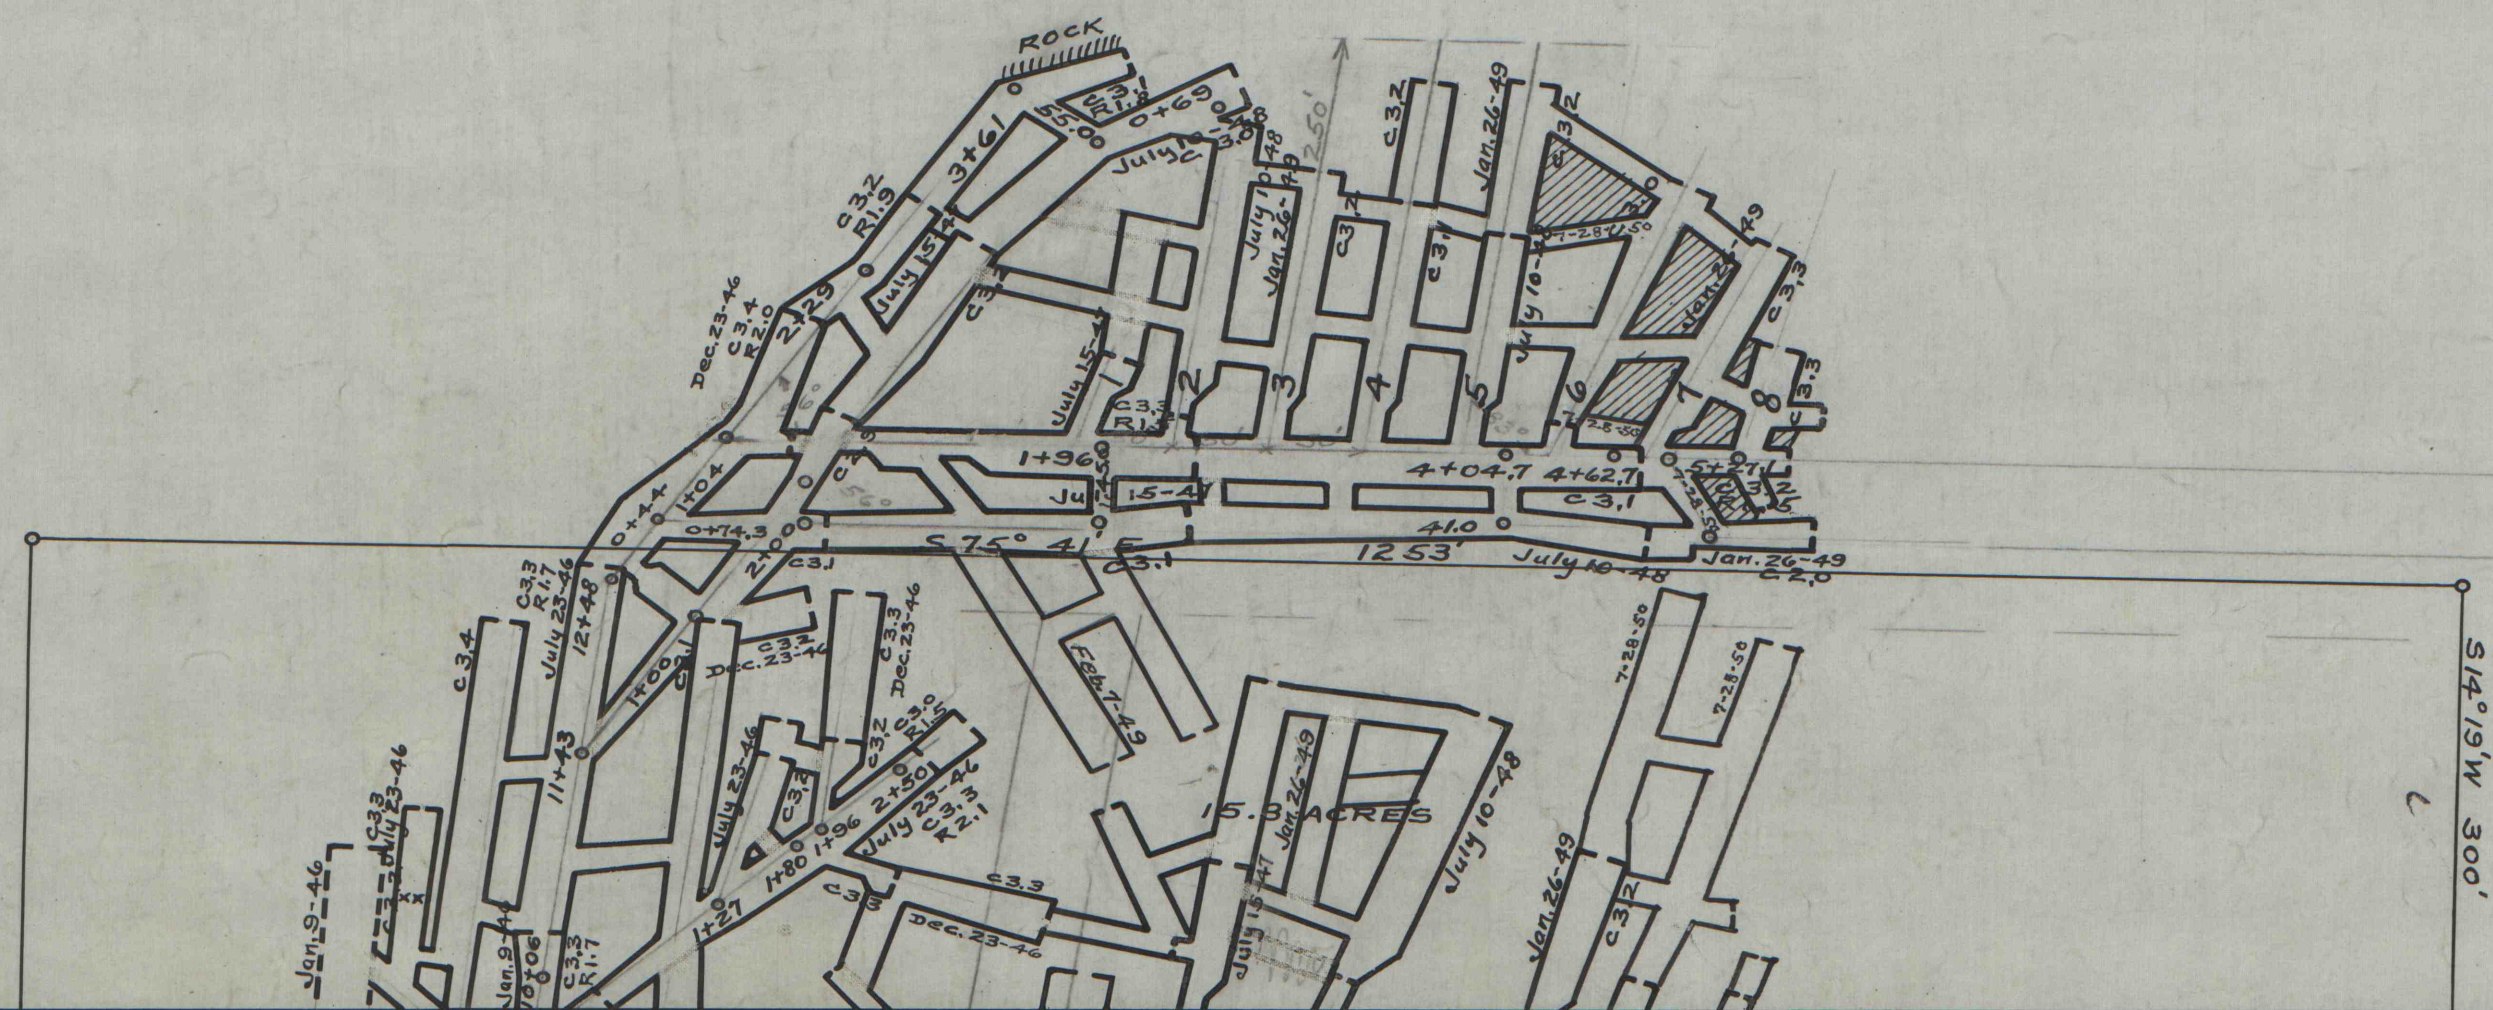

52-A-278-A

0-9