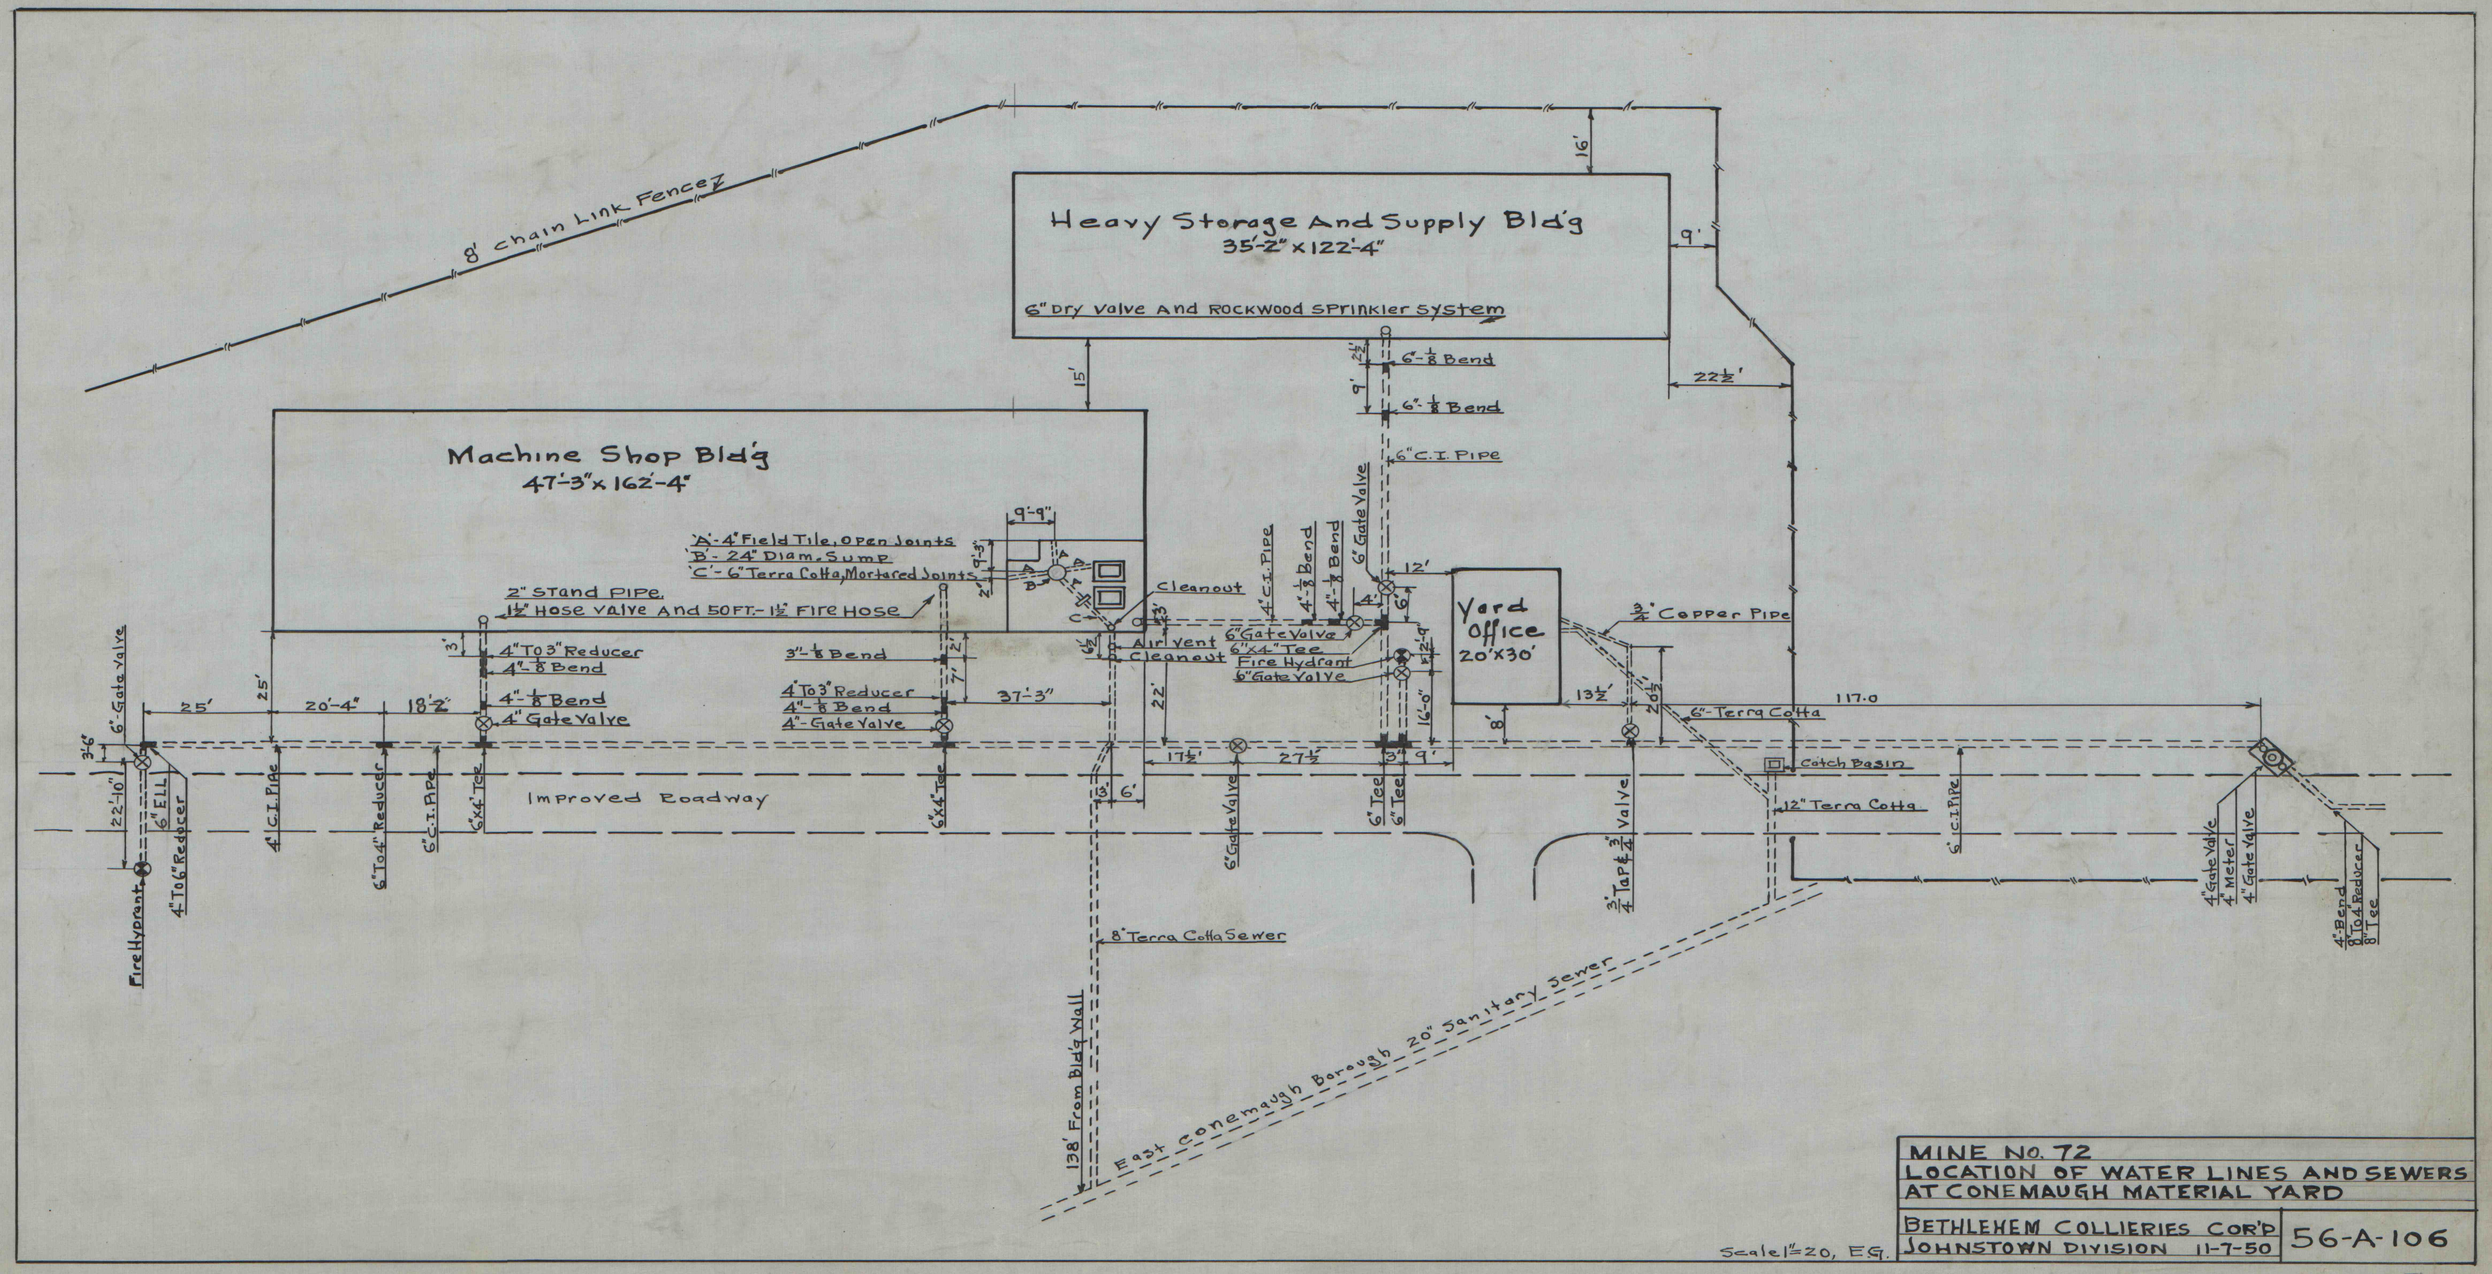

MINE NO. 72
LOCATION OF WATER LINES AND SEWERS
AT CONEMAUGH MATERIAL YARD

BETHLEHEM COLLIERIES COR'P
JOHNSTOWN DIVISION 11-7-50

56-A-106

0-7