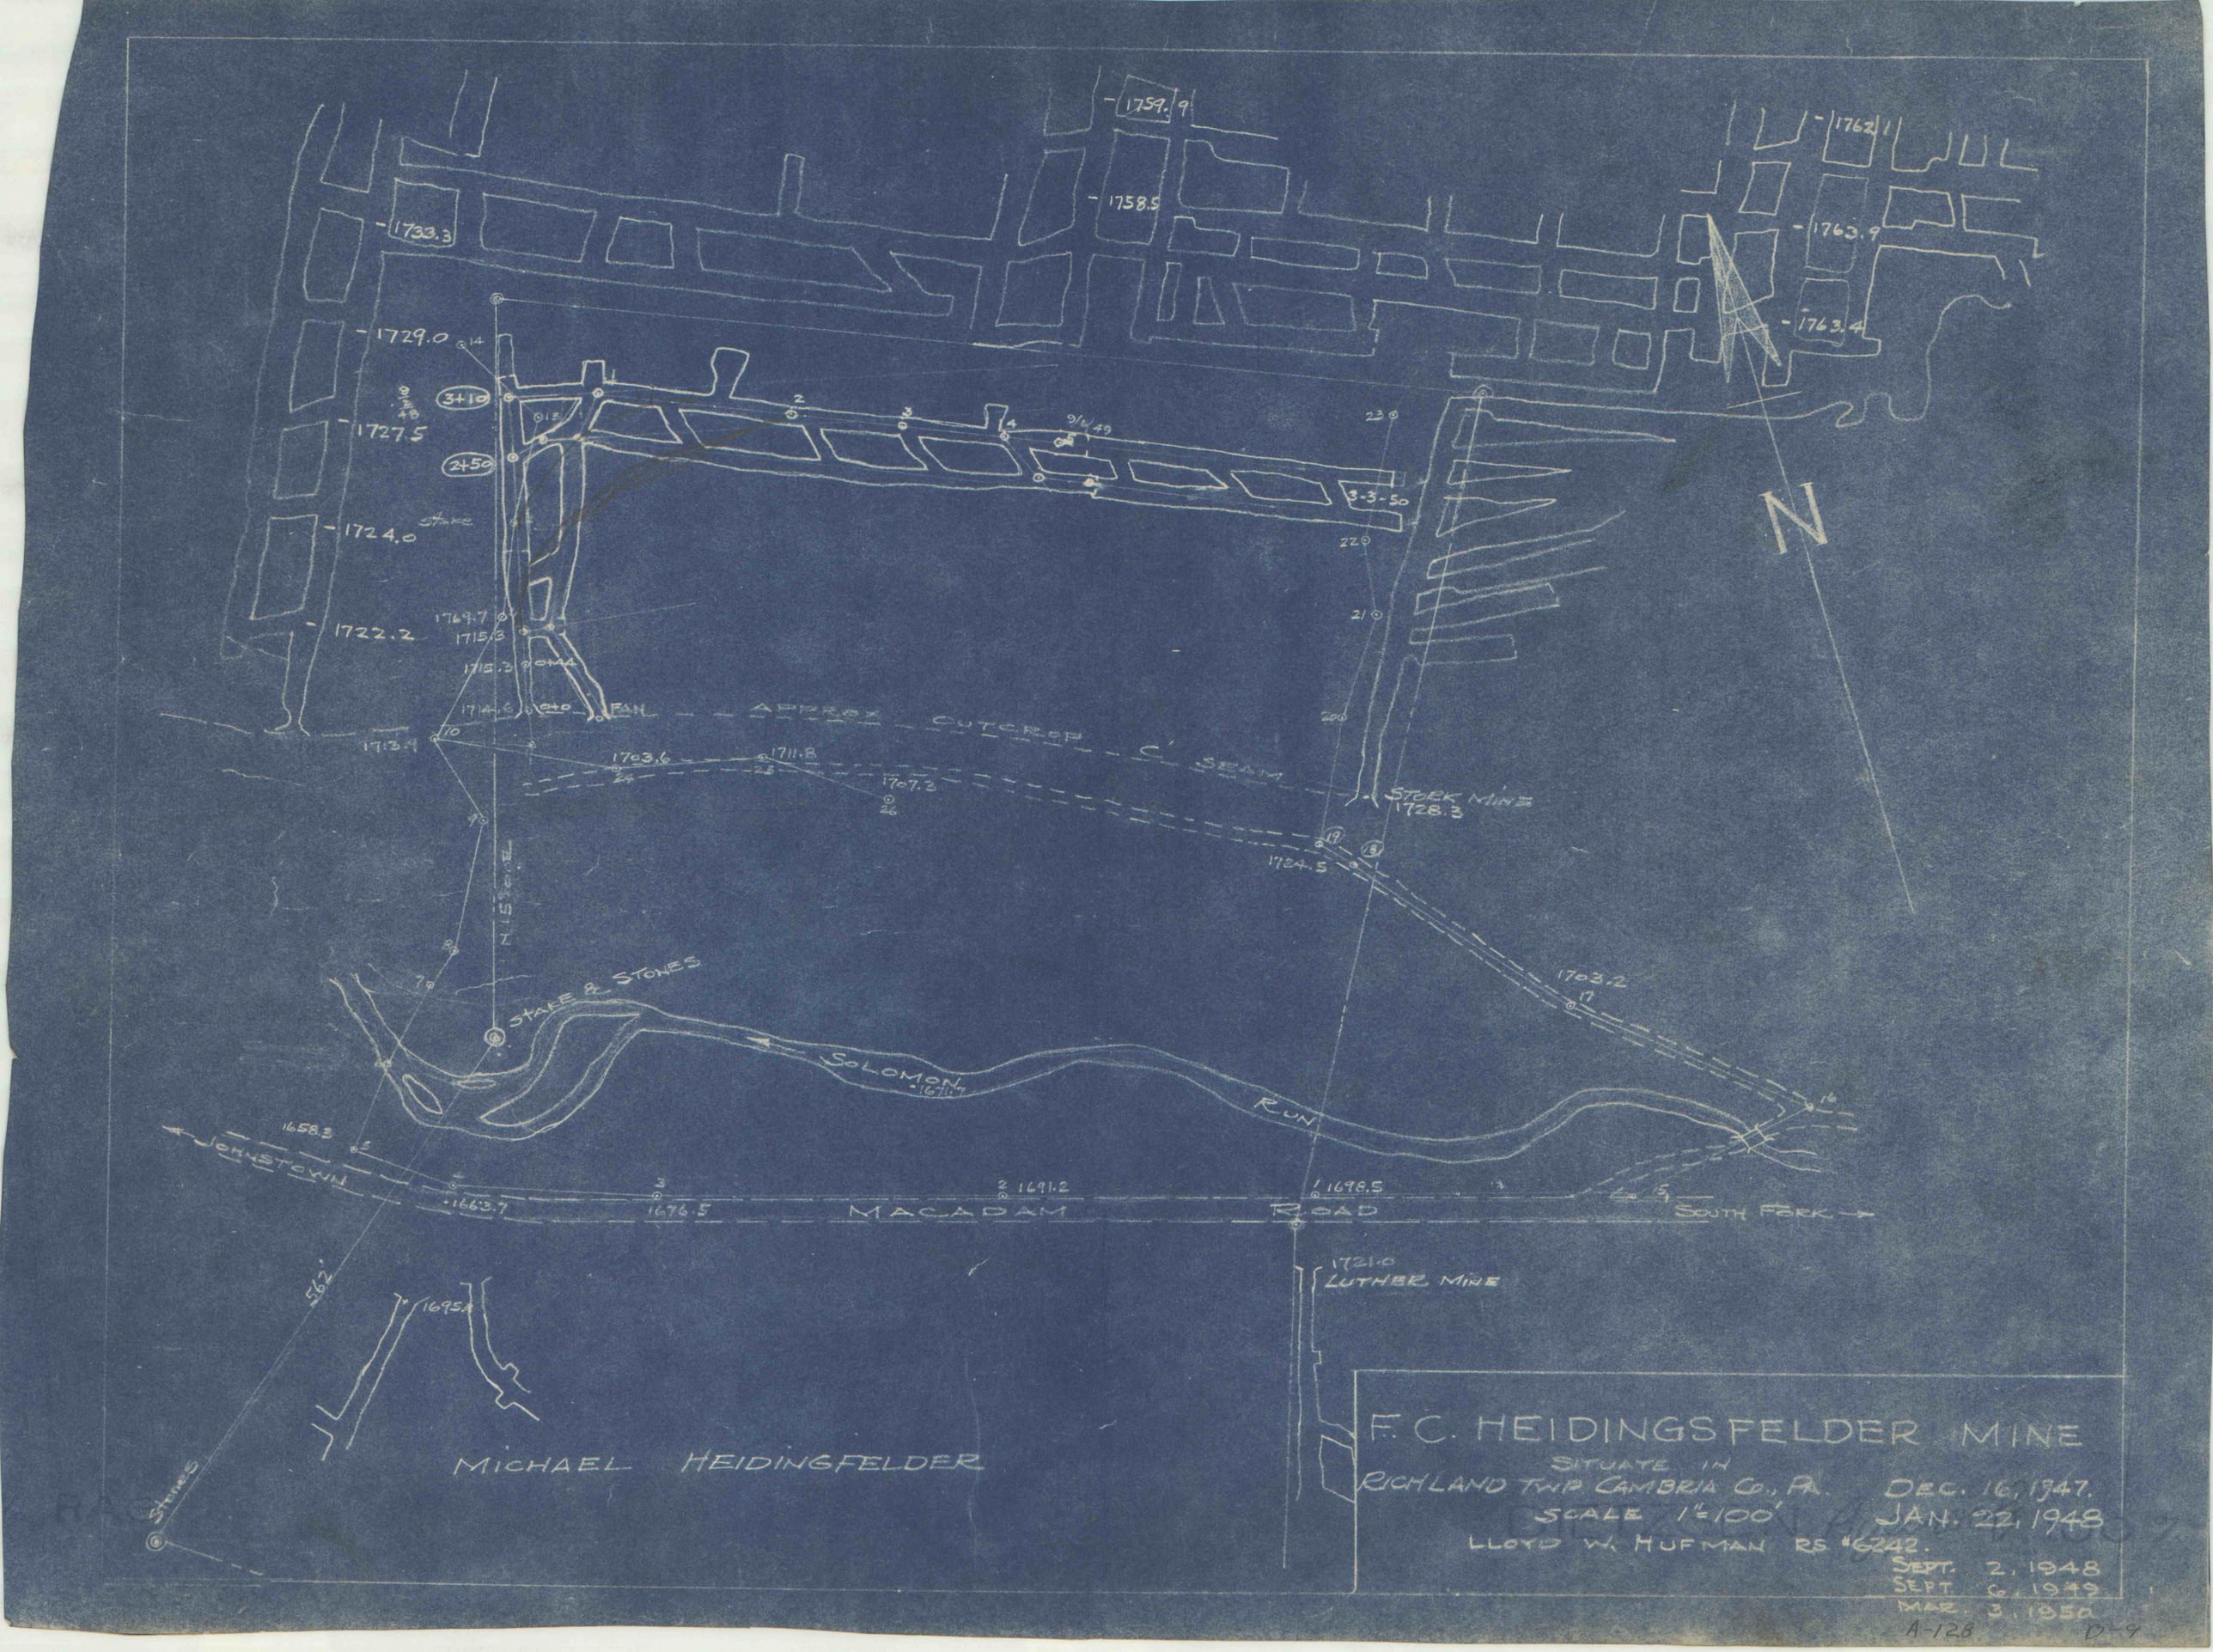
1759.9
1758.5
1762.1
1733.3
1763.9
1763.4
1729.0
1727.5
1724.0
1722.2
3+10
2+50
3-3-50
9/4/49
N
1769.7
1715.3
1715.2
1714.6
FAN
APPROX OUTCROP "C" SEAM
1713.4
1703.6
1711.8
1707.3
STOEK MINE
1728.3
1724.5
1703.2
STAKE & STONES
SOLOMON RUN
1658.3
JOHNSTOWN
1663.7
1676.5
1691.2
1698.5
MACADAM ROAD
SOUTH FORK
562'
1695A
1721.0
LUTHER MINE
MICHAEL HEIDINGFELDER
Stones
F. C. HEIDINGSFELDER MINE
SITUATE IN
RICHLAND TWP CAMBRIA CO., PA.
SCALE 1"=100'
LLOYD W. HUFMAN RS #6242.
DEC. 16, 1947.
JAN. 22, 1948
SEPT. 2, 1948
SEPT. 6, 1949
MAR. 3, 1950
A-128
D-9