


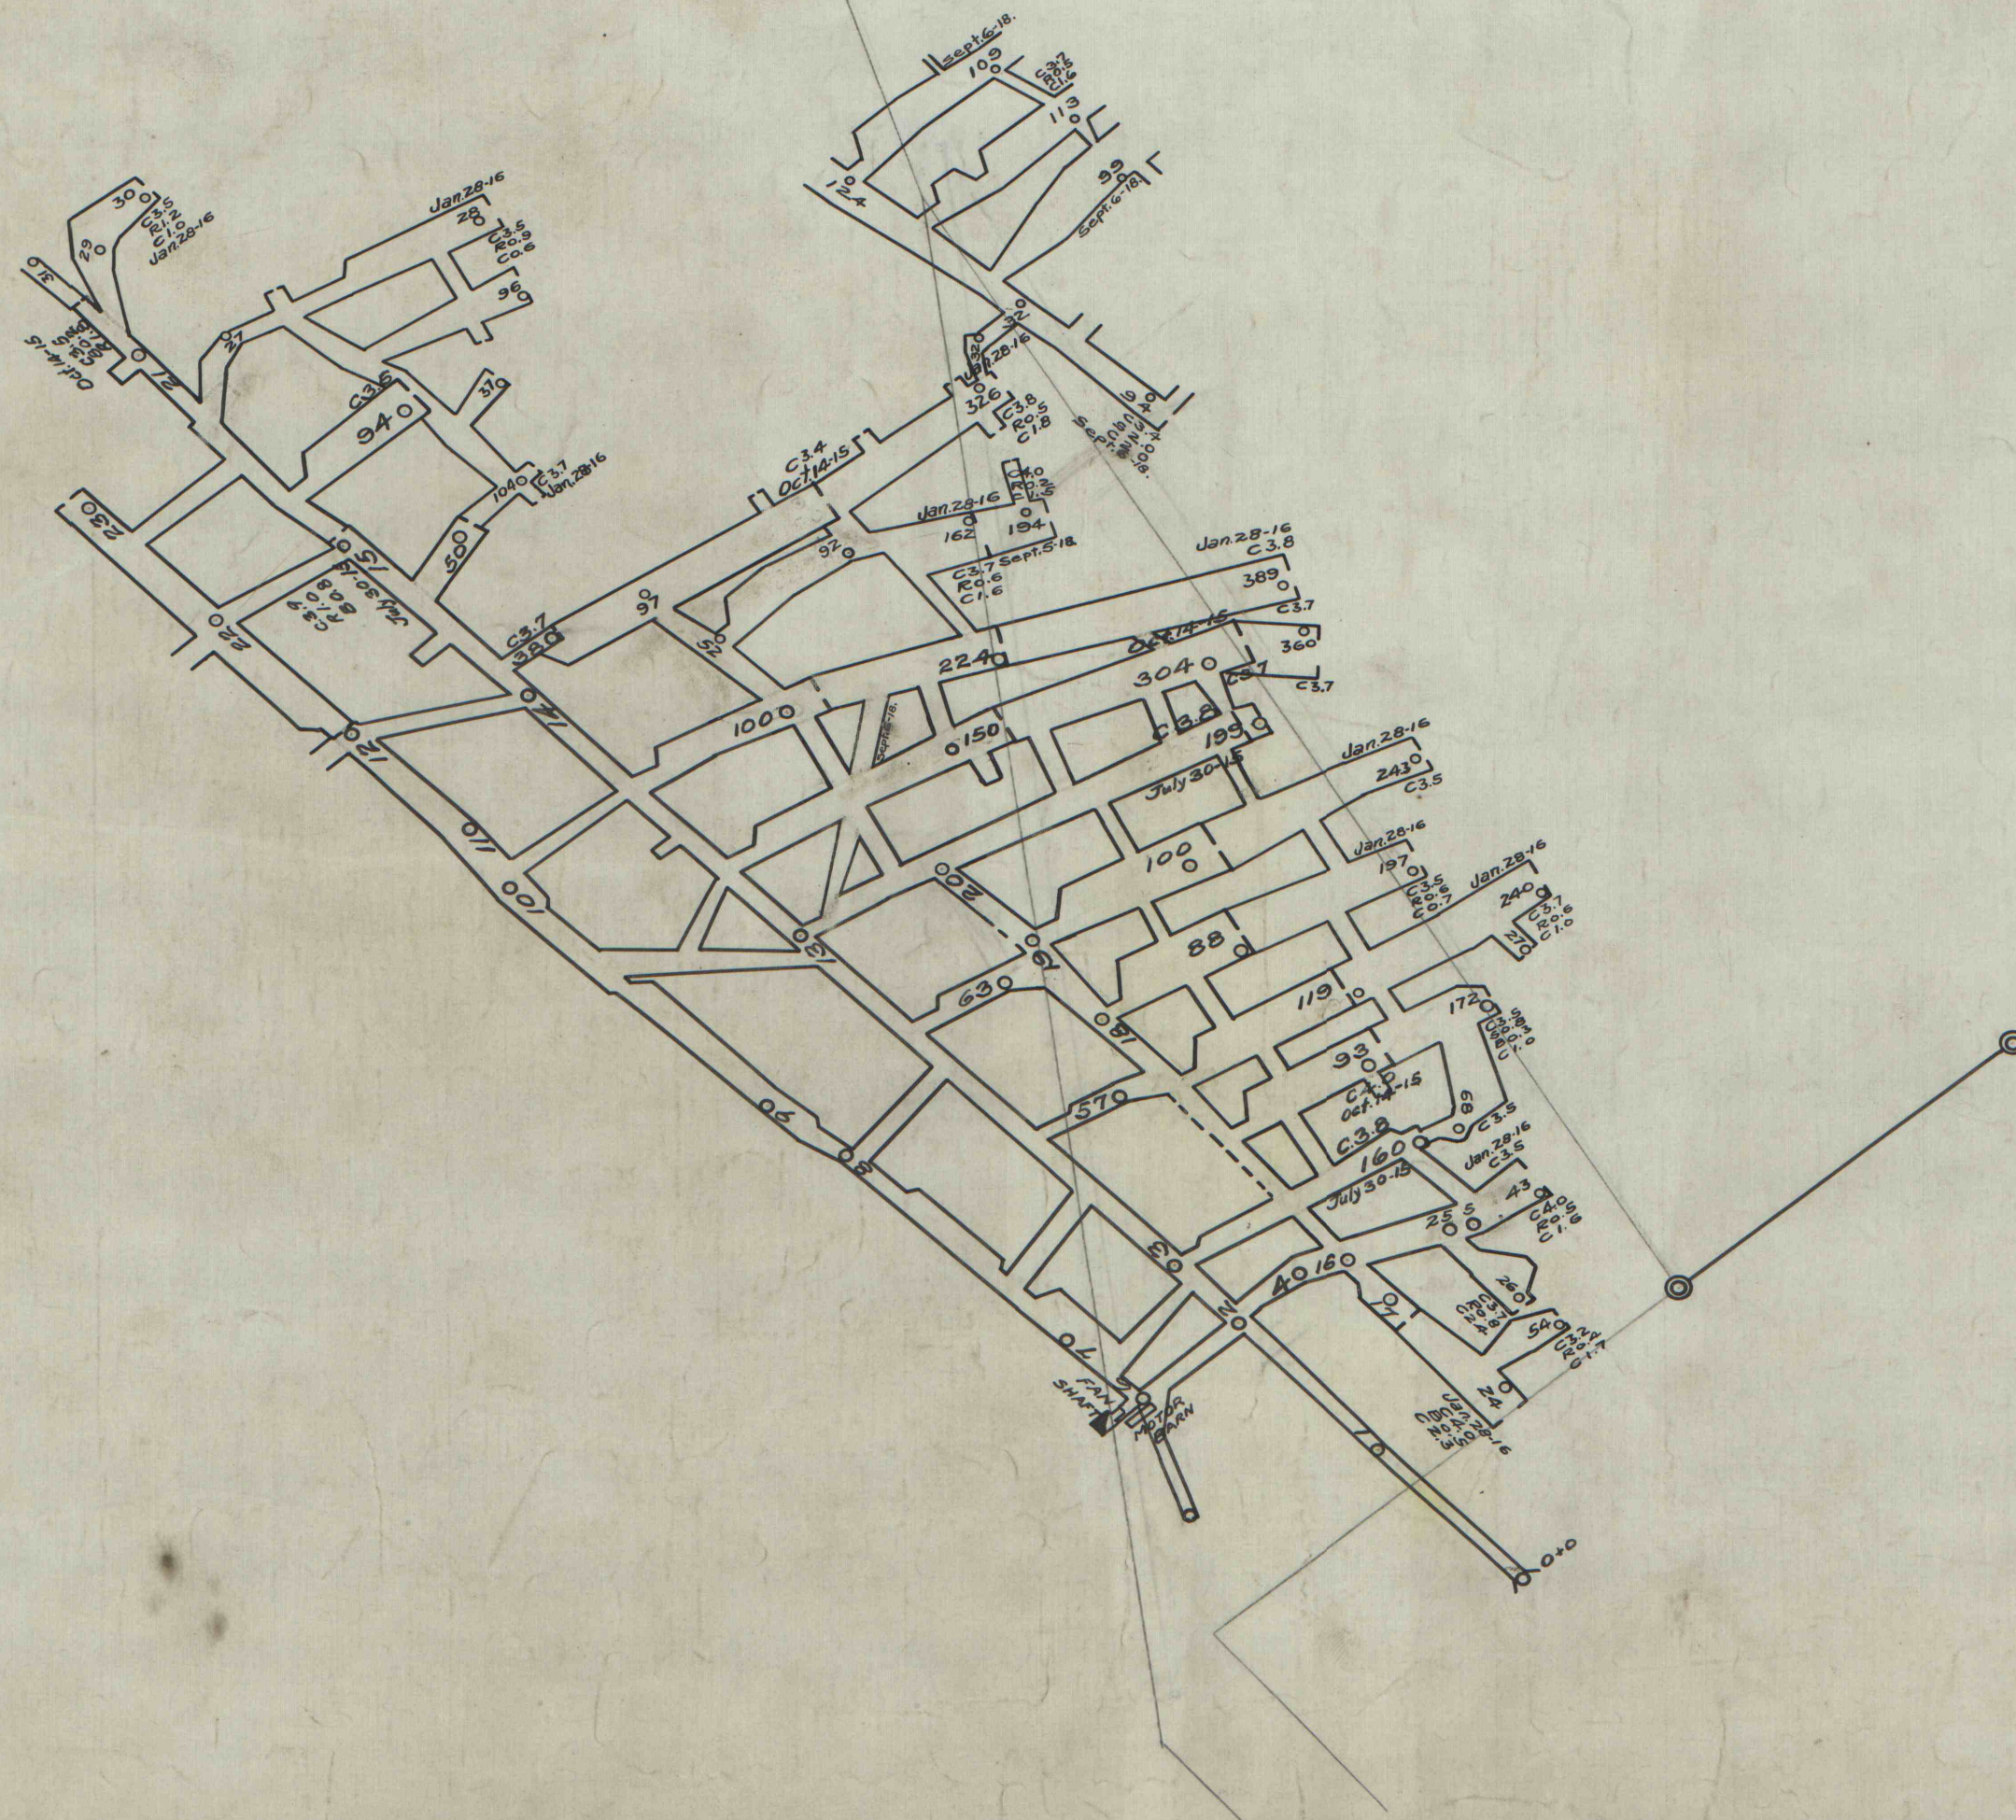

CAMBRIA STEEL CO.
M. E. & S. DEPT.
JOHNSTOWN, PA.

PARK HILL MINE
OPERATED BY CONEMAUGH
COAL MINING CO. SHOWING
WORKINGS ON PROPERTY LEAS-
ED FROM C.S.CO. SCALE 1 in. = 100 ft.

NOTE BOOKS

REFERENCES

DATED	8-3-16		
DRAWN BY	R.A.B.		
TRACED BY	R.A.B.		
CHECKED BY			

INDEX: Mines Leased. Mines Foreign

52A-106

B

D-9