


See 52-A-278 for addition

JACOB MENELY

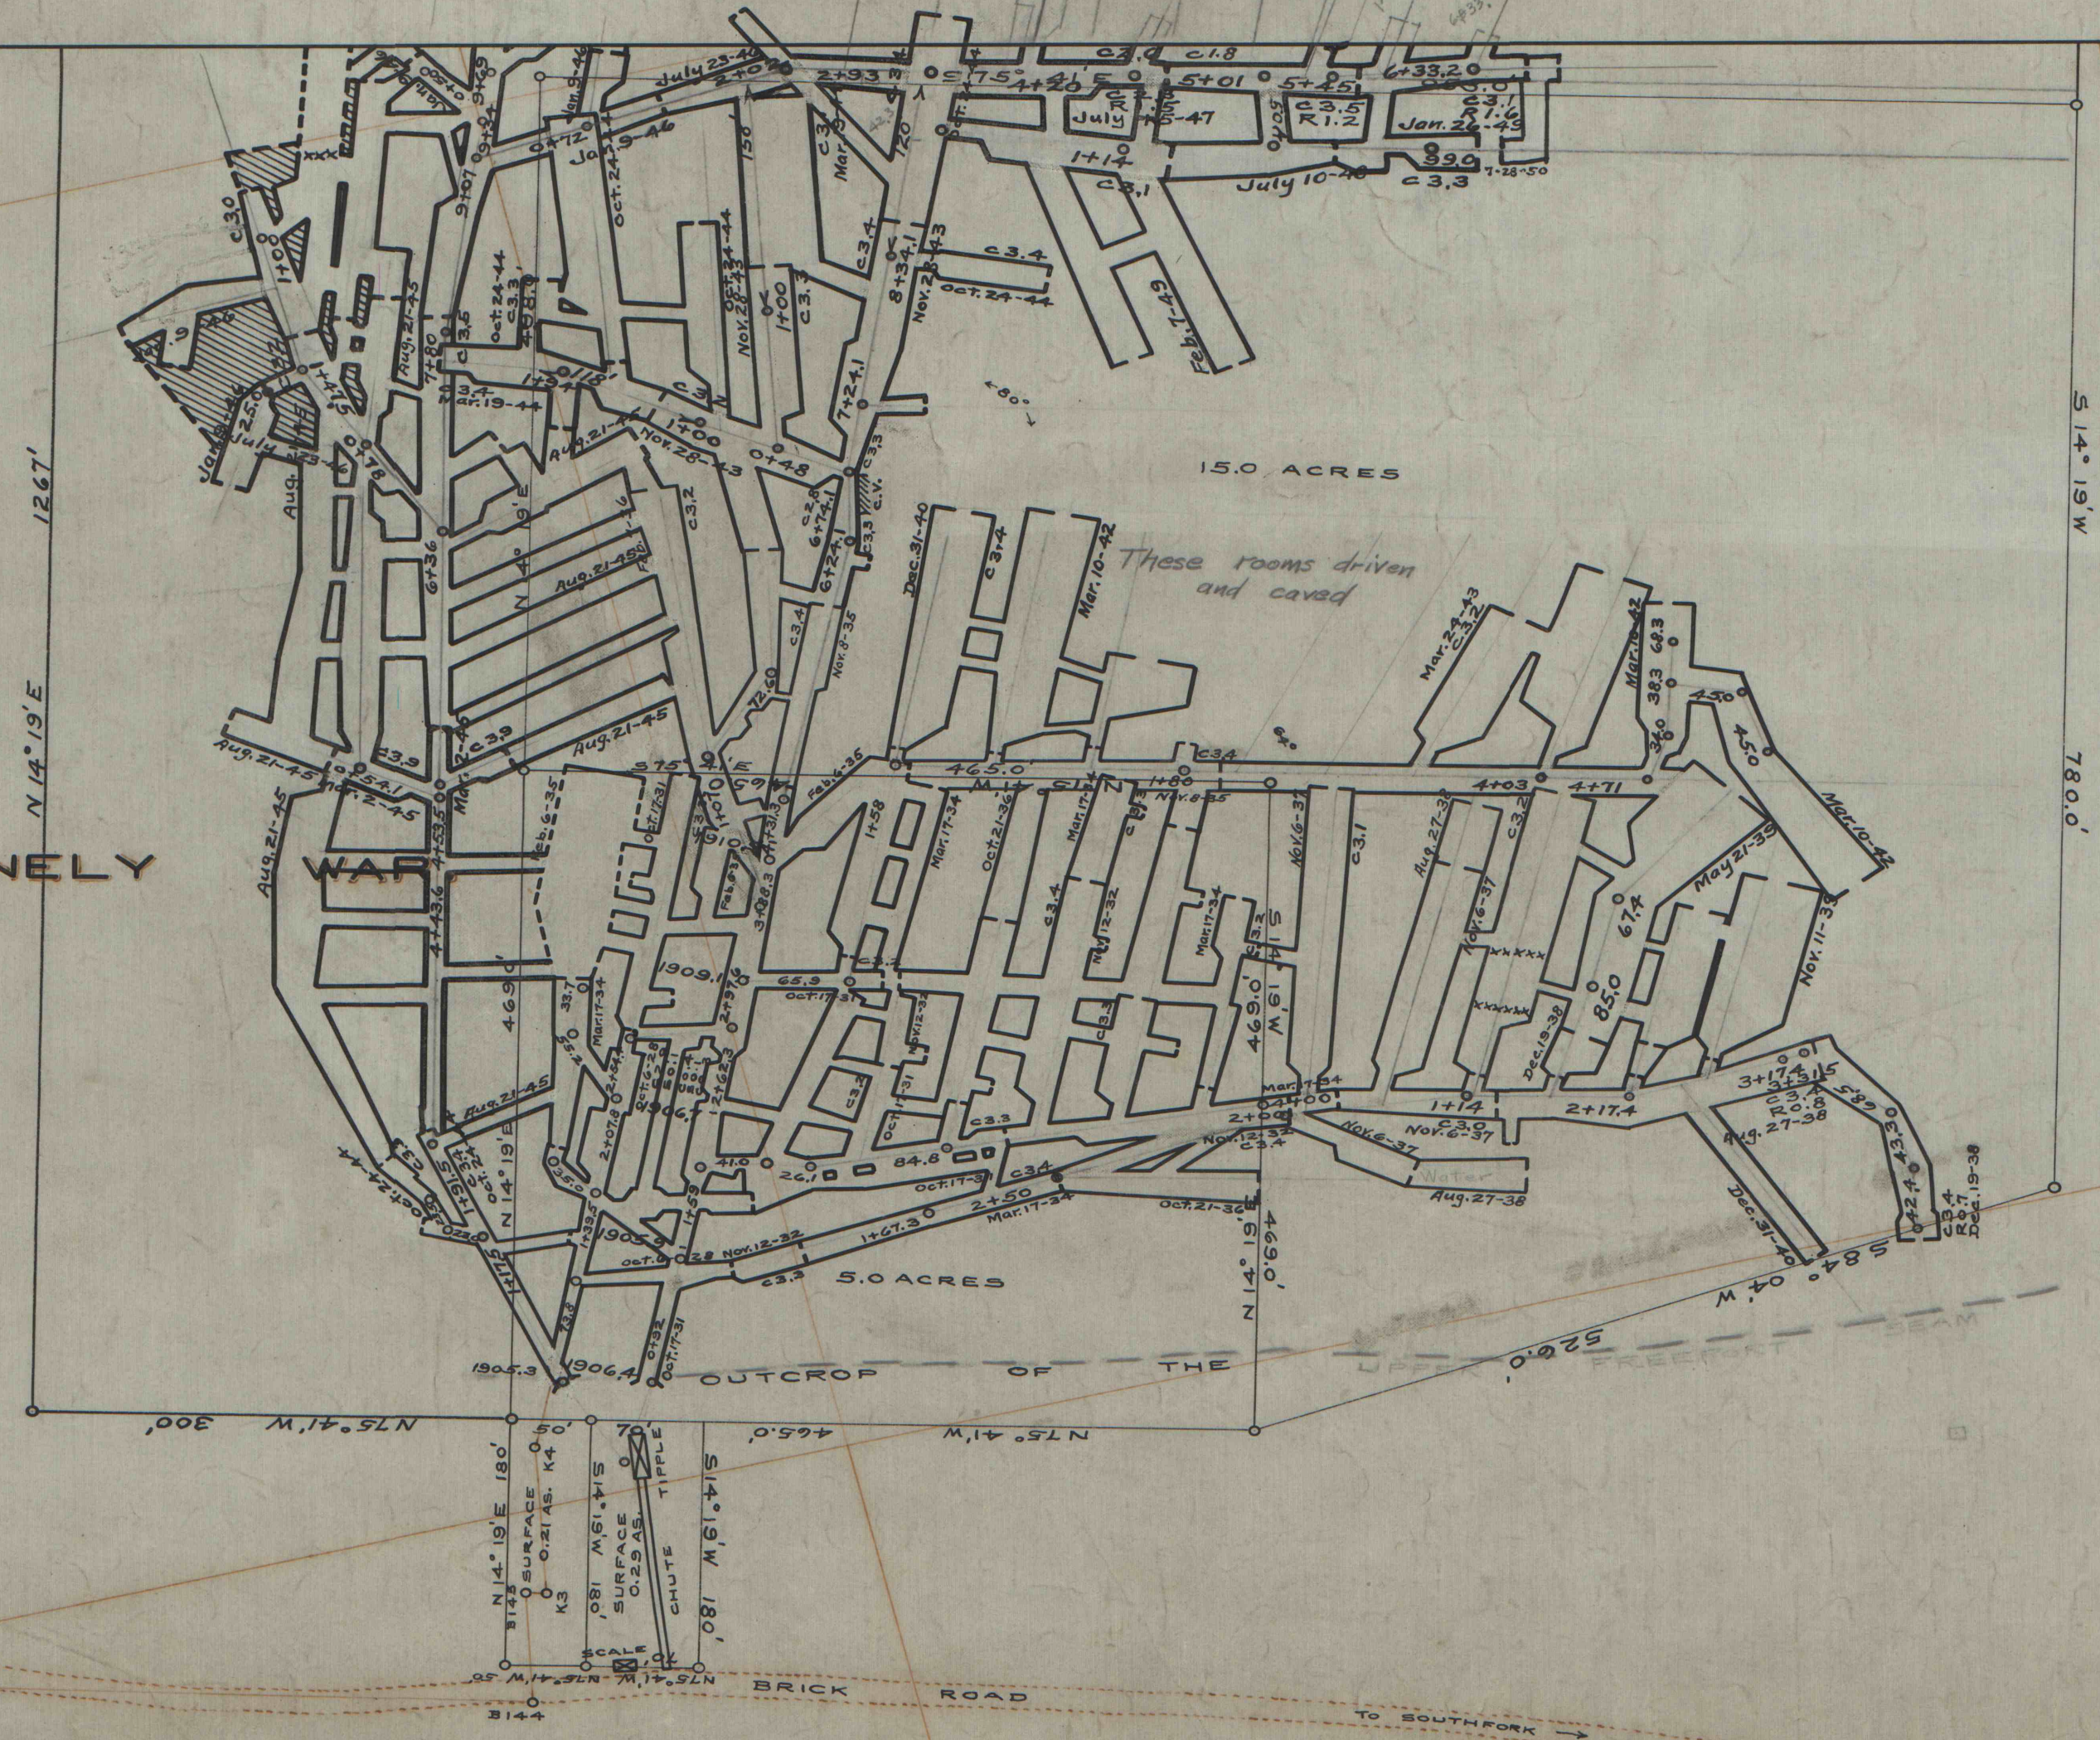

MAP OF A. C. KING MINE
UPPER FREEPORT SEAM
SITUATE
CONEMAUGH TOWNSHIP, CAMBRIA COUNTY,
PENNA.
SCALE 1" = 100' JUNE 10-1935

52-A-278

D-9